


T.6S.R.1W.W.M.

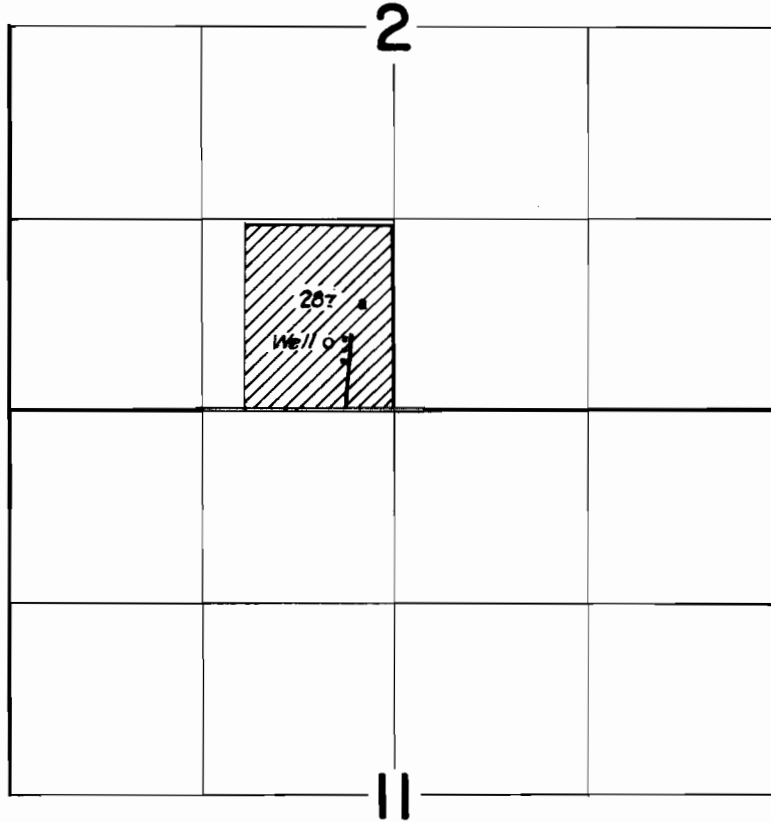

FINAL PROOF SURVEY UNDER

Application No. ~~G-1148~~ Permit No. G-1100....
IN NAME OF

CLEMENT DUDA

Surveyed April 20 1962, by *[Signature]*