


C-2897  
72946

# Chas. Montgomery's Pump

I Roy Pannells of Redmond Ore. do here by certify that this was made from notes taken during an actual survey made by me on Feb. 7, 1919, and it correctly represents the works in the accompanying application together with the location of streams and other ditches in the immediate vicinity.

Roy Pannells  
Surveyor.

T14SR15E

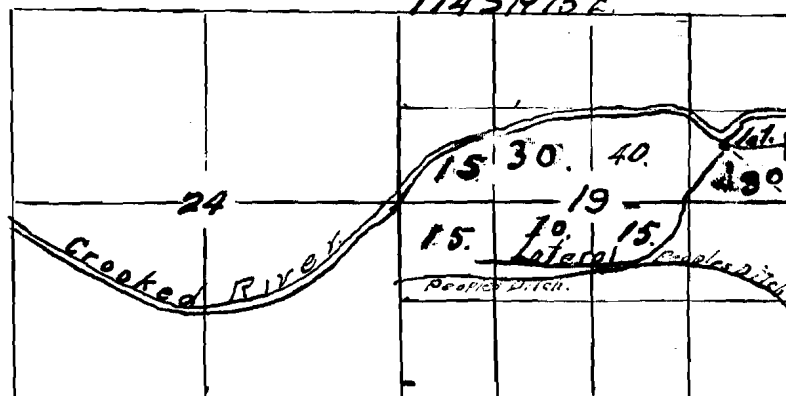

Application No 6738

Permit No 4260

P # 4260