


T.10S. R.2W., W.M.

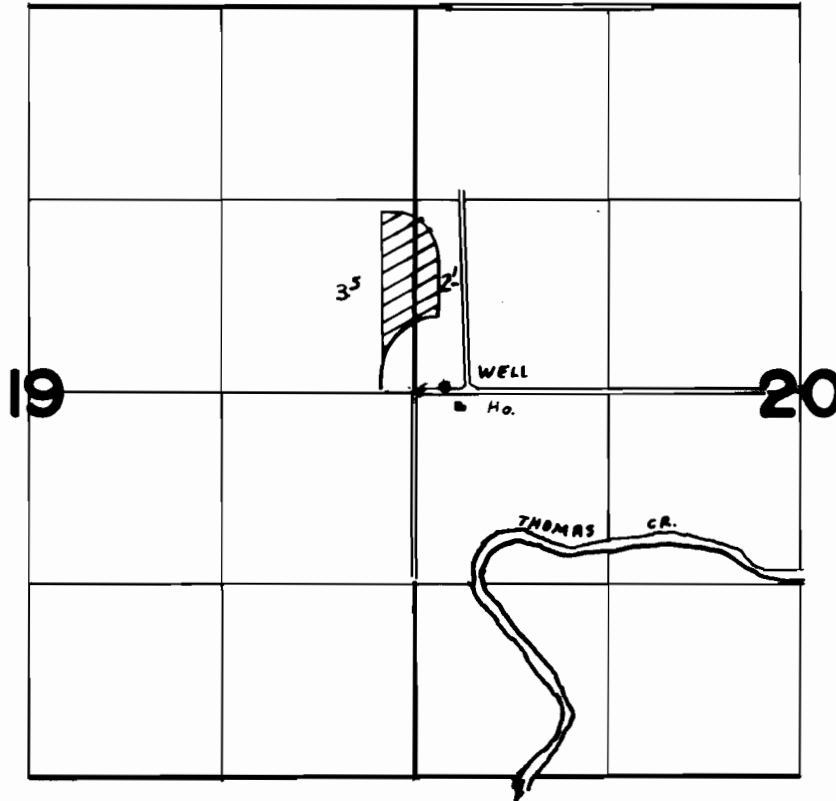

Well Loc 30' N. & 200' E. From W. 1/4 Cor. Sec. 20

FINAL PROOF SURVEY UNDER

Application No. G-5826... Permit No. G-5575...
IN NAME OF

..... LOUIE F. & LOMA WILLIAMS

Surveyed APR. 13. 1978., by S.P. APPLGATE