


MAP

ACCOMPANYING APPLICATION FOR PERMIT
TO APPROPRIATE WATER
SECTION 26 T2S R6 E. W.M.
Scale 1" = 400'

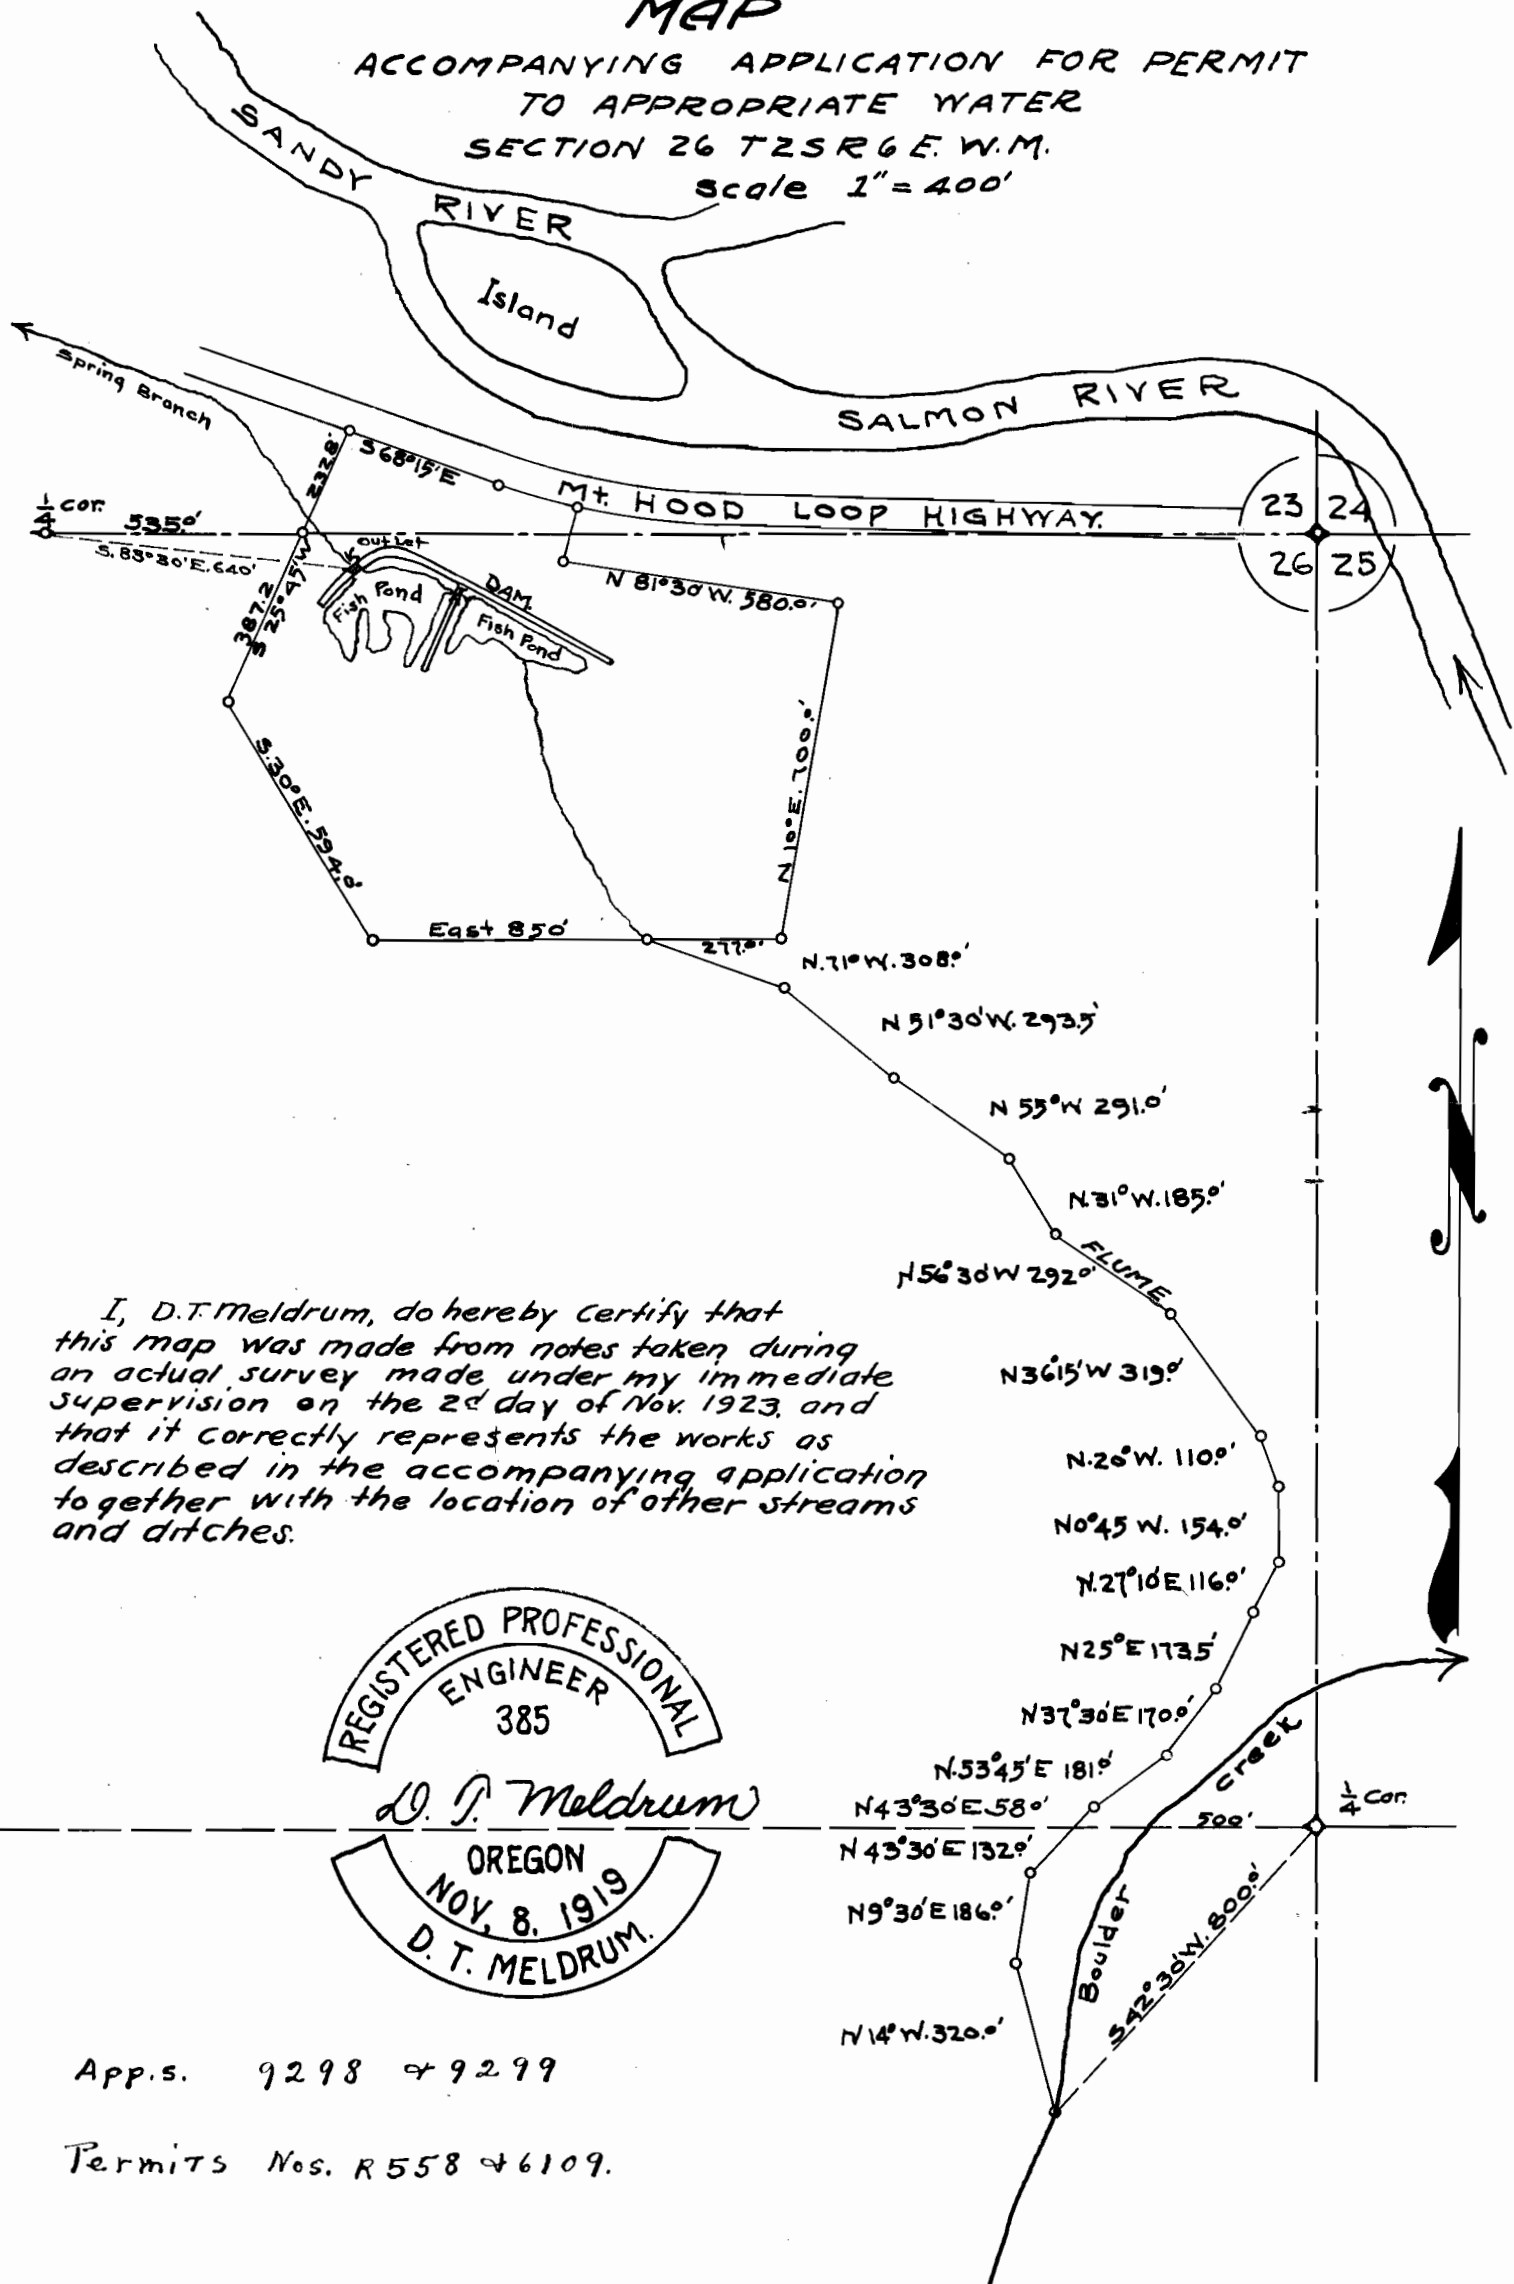

I, D.T. Meldrum, do hereby certify that this map was made from notes taken during an actual survey made under my immediate supervision on the 2^d day of Nov. 1923, and that it correctly represents the works as described in the accompanying application together with the location of other streams and ditches.

REGISTERED PROFESSIONAL
ENGINEER
385

D. T. Meldrum

OREGON
NOV. 8, 1919
D. T. MELDRUM.

App.s. 9298 & 9299

Permits Nos. R558 & 6109.