


T. 9S., R. 39E., W. M.

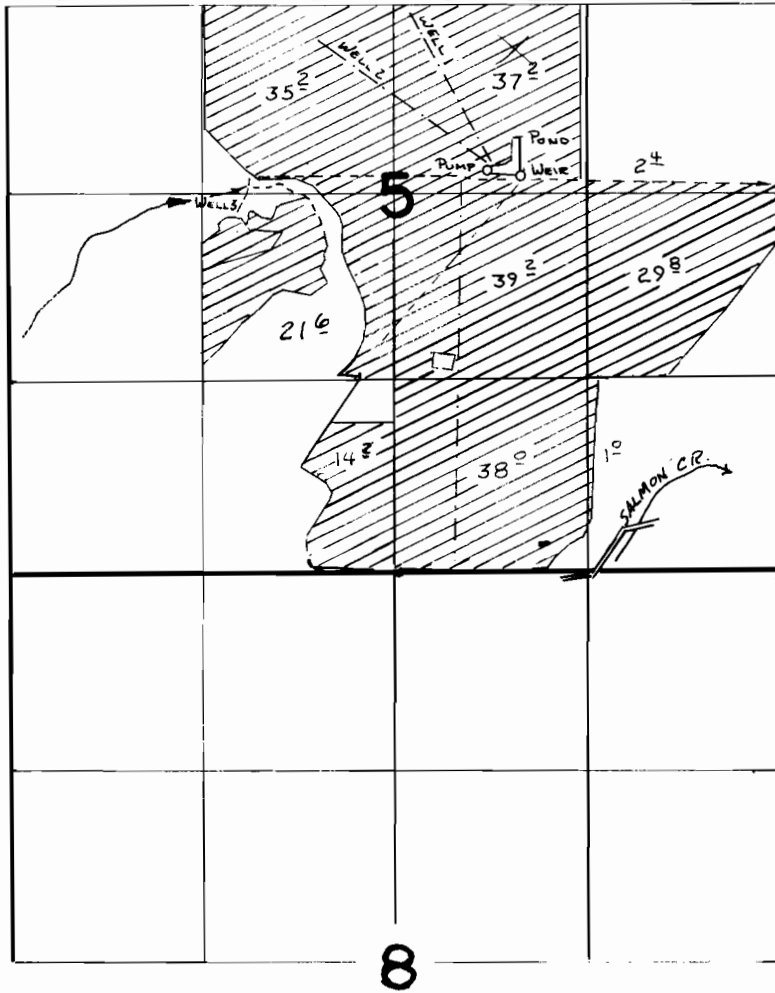

WELLS 1 & 2: 180' N & 650' E. FROM CENTER COR. SECTION 5  
WELL 3: 120' N & 1000' W. FROM CENTER COR. SECTION 5

**FINAL PROOF SURVEY**  
UNDER

G:10969                      G:10150  
Application No. G:8821.. Permit No. G:8236...  
IN NAME OF

..... JOSEPH O. RUDI .....

Surveyed *May 23*.... 19*84*., by *V.L. Church*.....



SCALE: 1" = 1320'