C-73173

S.29, T.14S., R.13E., W.M.
DESCHUTES COUNTY

SCALE: 1" = 400'

RECEIVED
JUN 13 1996
WATER RESOURCES DEPT.
SALEM, OREGON

LEGEND

- WATER RIGHTS ON
- H HOUSE
- S SHED
- Y YARD

8" DIAMETER WELL IS
S. 450' x E. 1370'
FROM W1/4 CORNER

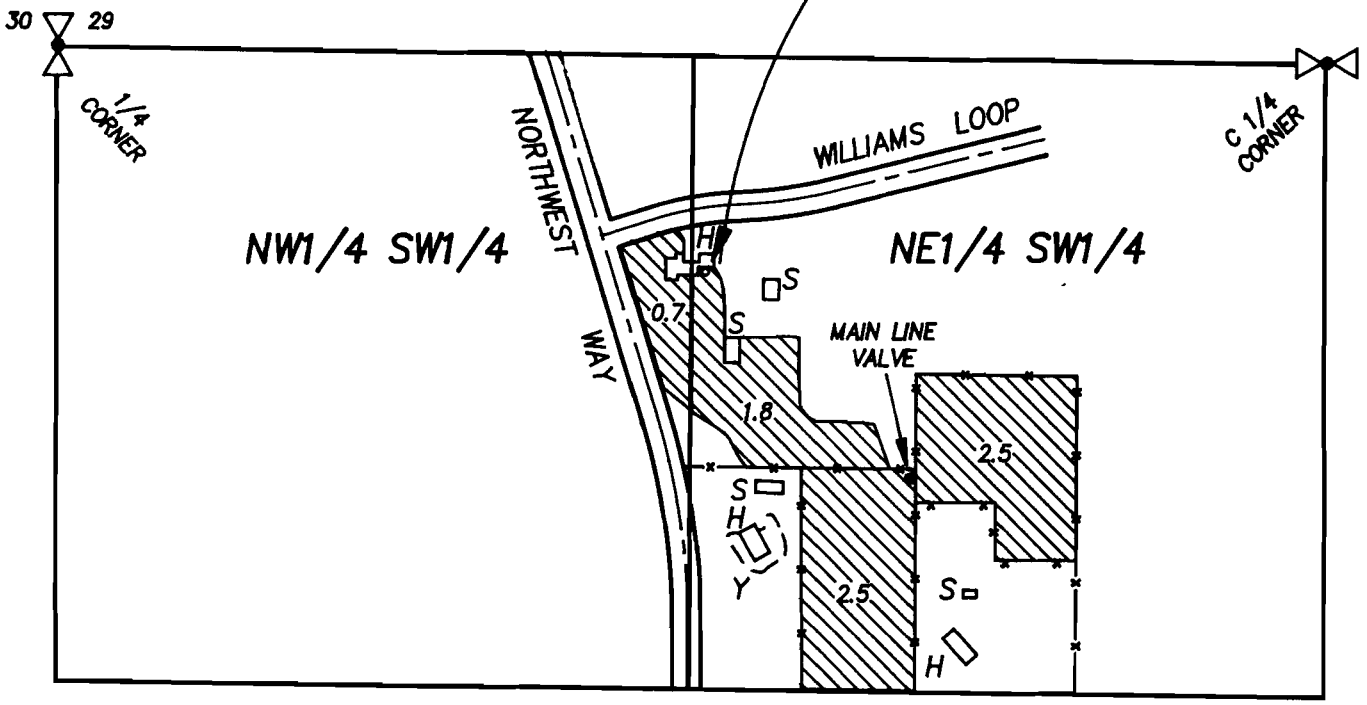

FINAL PROOF
FOR GROUND WATER
DAHL/ McHATTON/ LEE

I, Robert R. Povey, Oregon Certified Water Right Examiner #106, hereby certify the above final proof map was prepared under my direct supervision.

The preparation of this map is for the purpose of identifying the location of the water right only and has no intent to provide dimensions or locations of property ownership lines.

Certified Water Right Examiner #106
Robert R. Povey 5-28-96
Robert R. Povey
Nov. 19, 1987
STATE OF OREGON

APPL. 12565 PERMIT 11417 CERT: 73173

M96-39.DWG

G-11417