
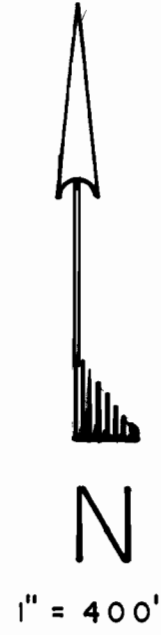


T. 3 S., R. 7 E., W.M.
SECTION 9

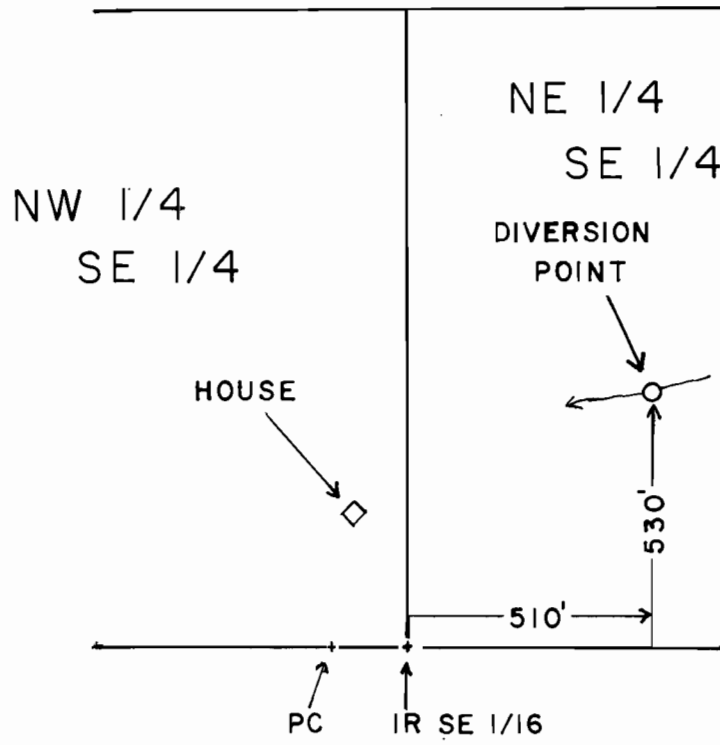

FINAL PROOF SURVEY
UNDER

Application No. 65530 Permit No. 47989
IN NAME OF

Gerald A. Beard

Surveyed August 31, 1993, by R.M.Cozzi

R.M.C. 9/23/93
P.T.S. W/FF