


RECEIVED
NOV 4 1993
WATER RIGHTS DIVISION

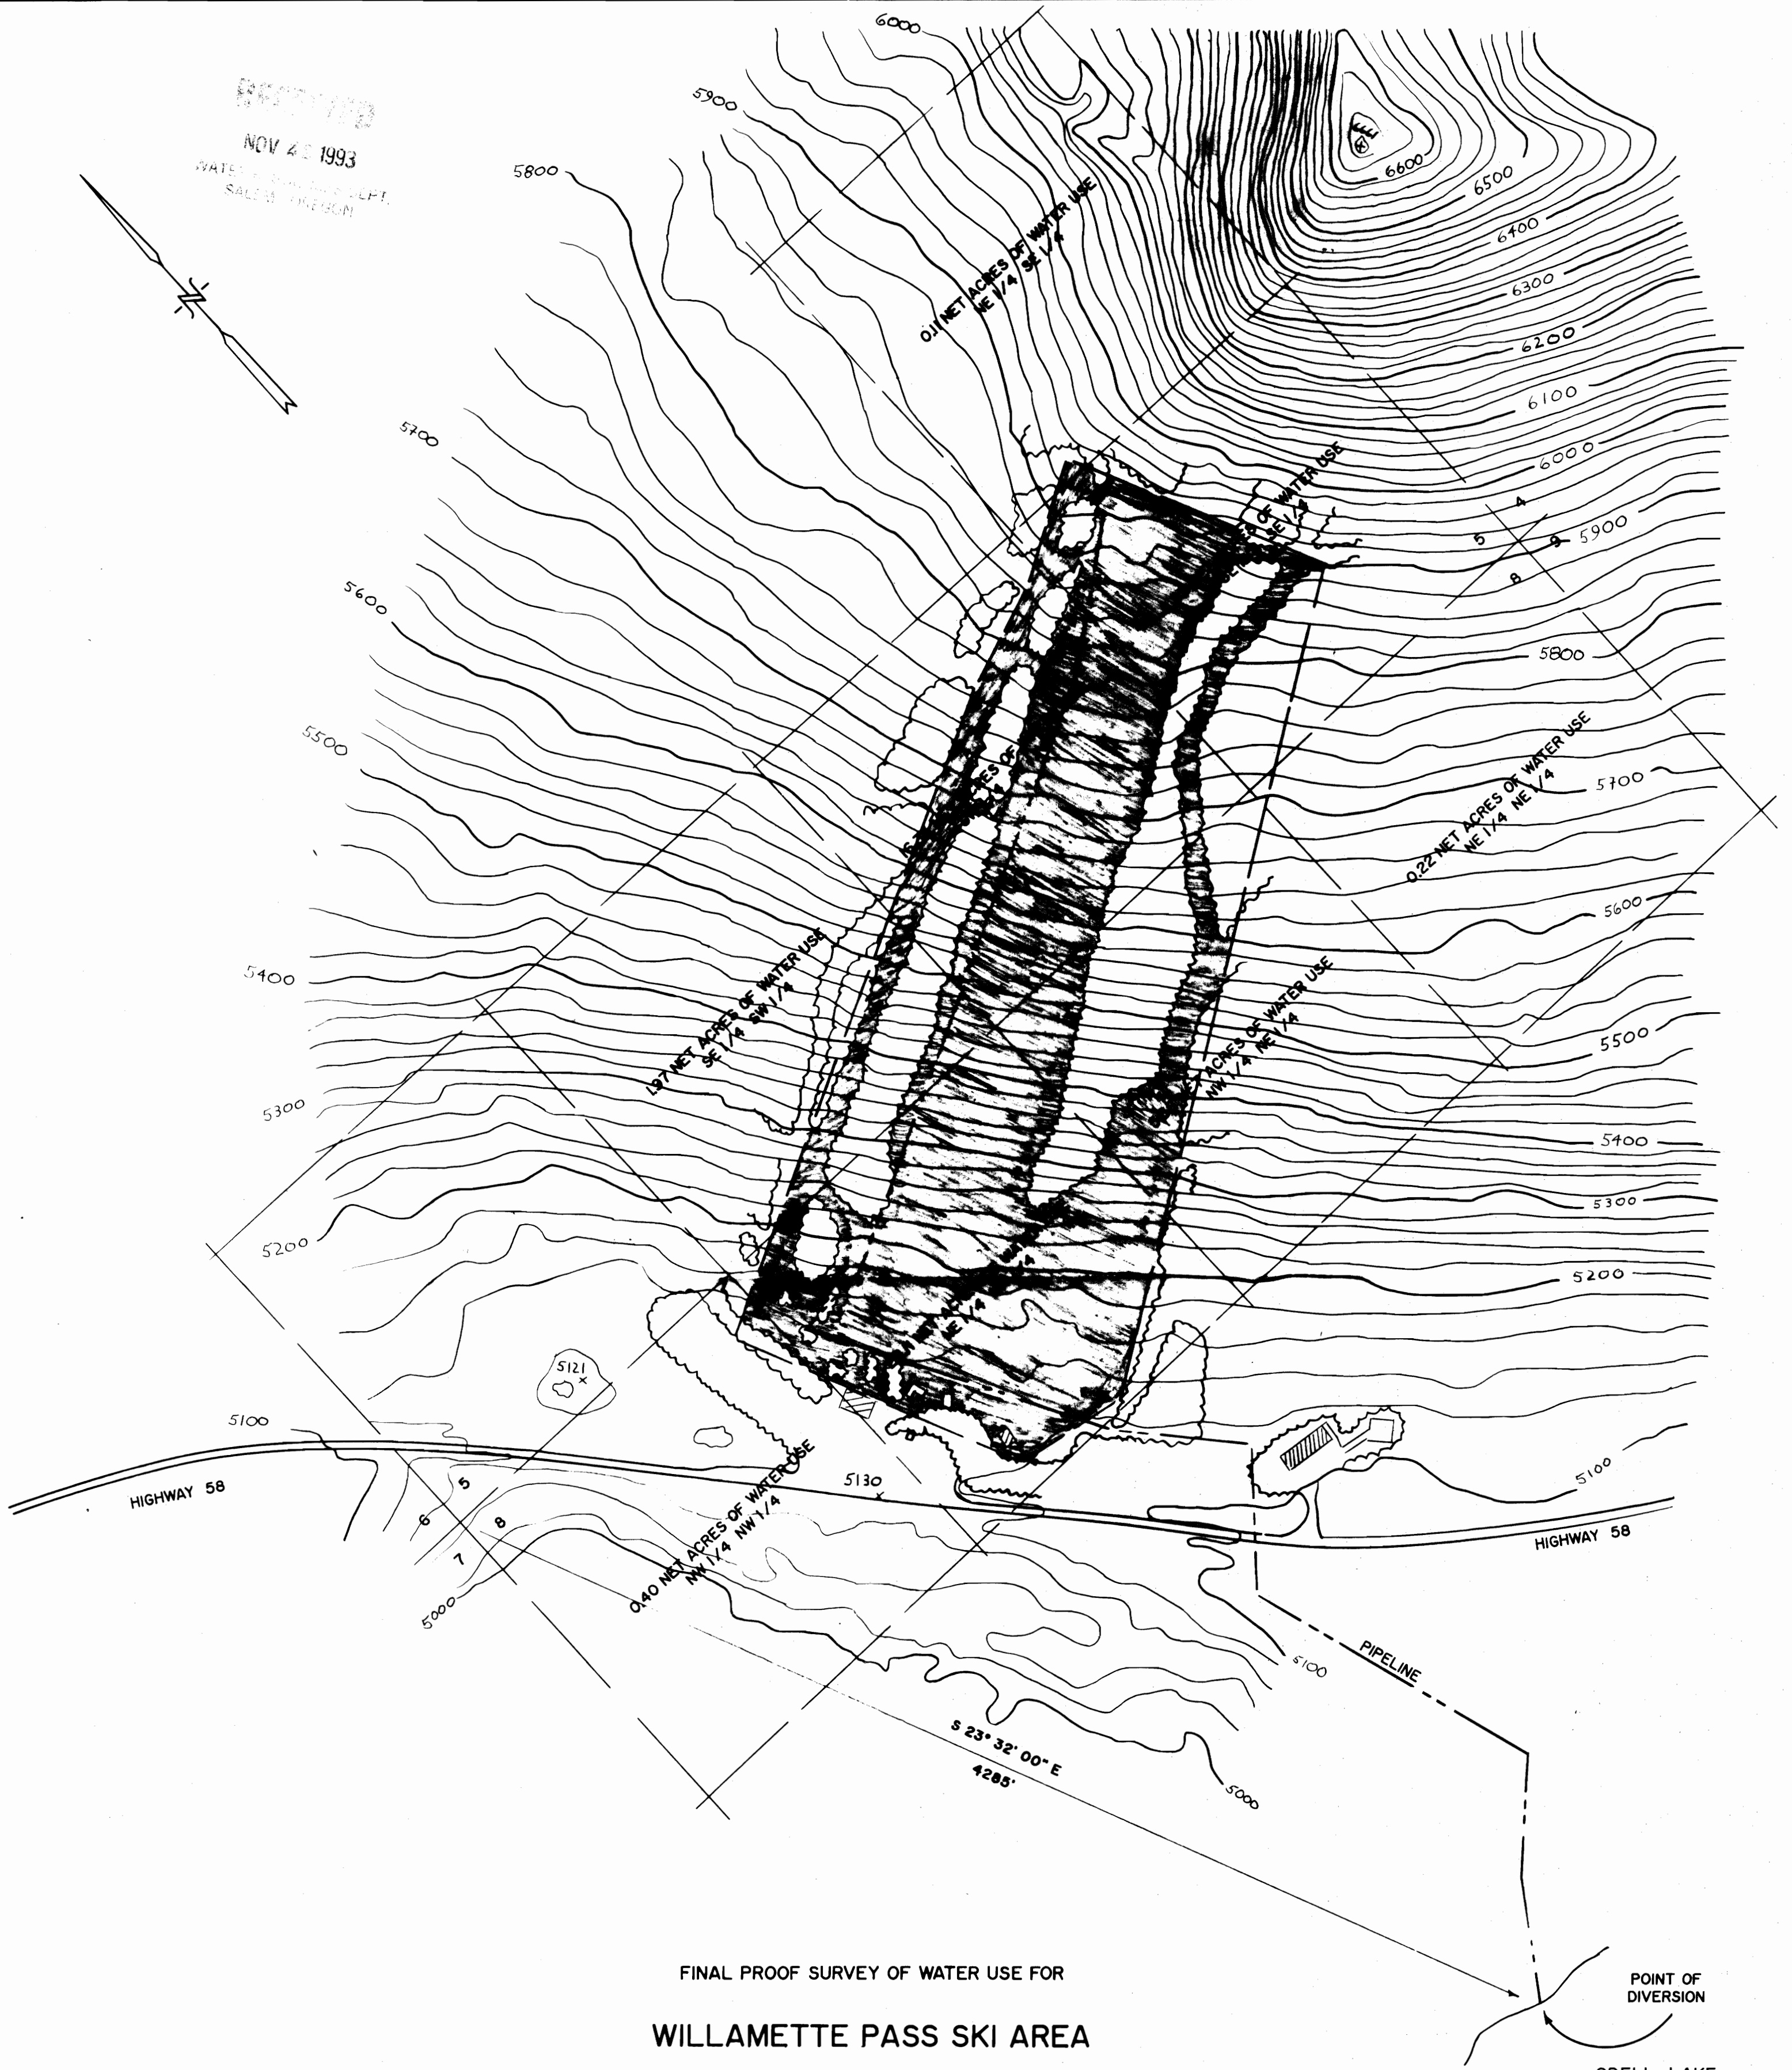


FINAL PROOF SURVEY OF WATER USE FOR
WILLAMETTE PASS SKI AREA
LOCATED IN PORTIONS OF SECTIONS 5 & 8, T. 23 S., R. 6 E., W.M.
KLAMATH COUNTY, OREGON

POINT OF
DIVERSION

ODELL LAKE
ELEVATION = 4780' ±

SCALE: 1" = 400'
01 DECEMBER 1992

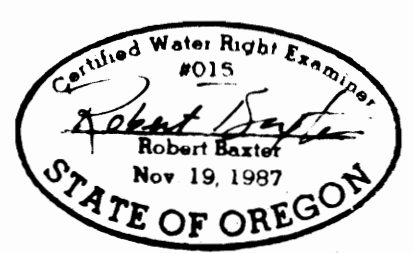

NOTE: SECTIONAL SUBDIVISION LINES AND CORNER LOCATIONS ARE BASED ON PROTRACTOR, AND ARE SCALED FROM REFERENCE MAPS. WATER USE BOUNDARIES ARE BASED ON STATEMENTS BY THE SKI AREA OPERATOR AND ARE SCALED FROM TOPOGRAPHIC FEATURES. NO MEASUREMENTS HAVE BEEN MADE ON THE GROUND. THIS IS NOT A BOUNDARY SURVEY, AND IS SUBJECT TO ANY INACCURACIES A SUBSEQUENT BOUNDARY SURVEY MAY REVEAL.

WATER RIGHTS EXAMINER: BAXTER LAND SURVEYING INC.
DRAFTING BY: JEFF KERN & ASSOC. INC. PROFESSIONAL LAND SURVEYORS
1030 N.W. NEWPORT AVE. BEND, OREGON 97701 389-4736