


T.34 S., R.1 W., W.M.

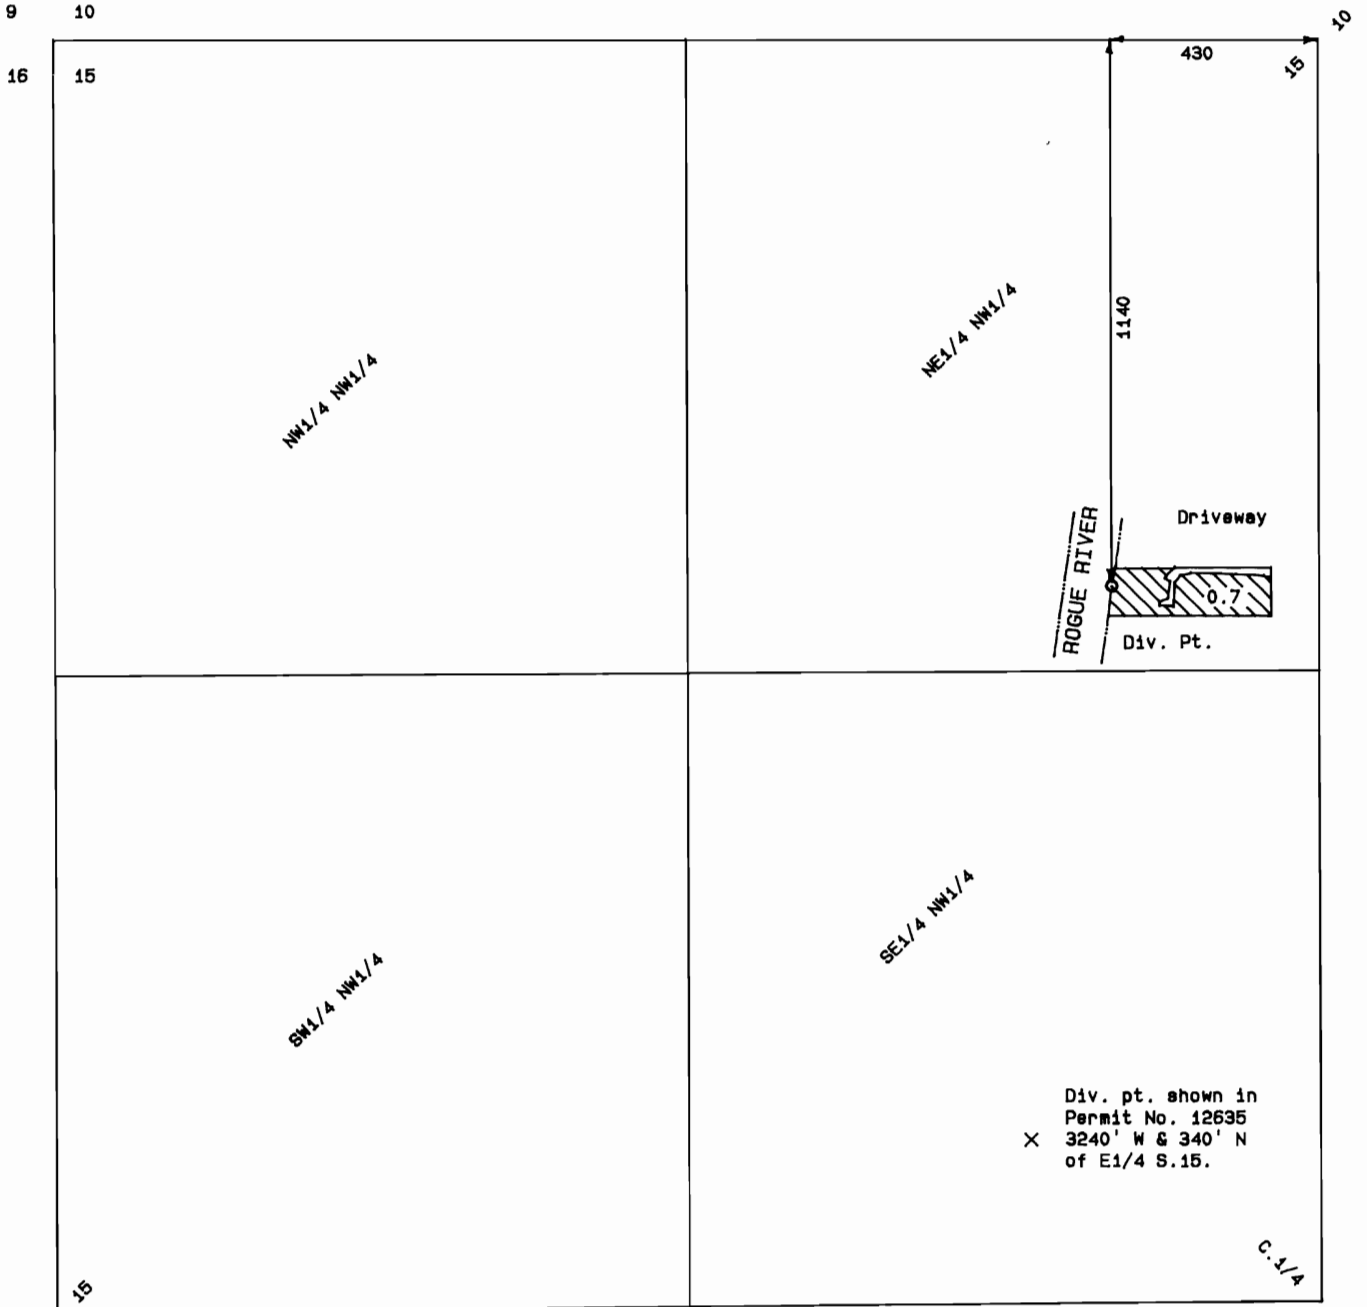

FINAL PROOF MAP
 under
 Application No. T- 6567 Permit No. 12635.
 in name of

RICHARD and WENDY MEYER

Mapped Feb. 18, 1993 Scale: 1" = 400'

Mapped by: L.J. Friar & Associates P.C.
 Consulting Land Surveyors
 304 South Holly Street
 Medford, OR 97501
 (503) 772-2782



THE PREPARATION OF THIS MAP WAS FOR THE PURPOSE OF IDENTIFYING THE WATER RIGHT ONLY & HAS NO INTENT TO PROVIDE DIMENSION OR LOCATION OF PROPERTY OWNERSHIP LINES.

