


5610

T. 41 S. R. 22 E. W.M.

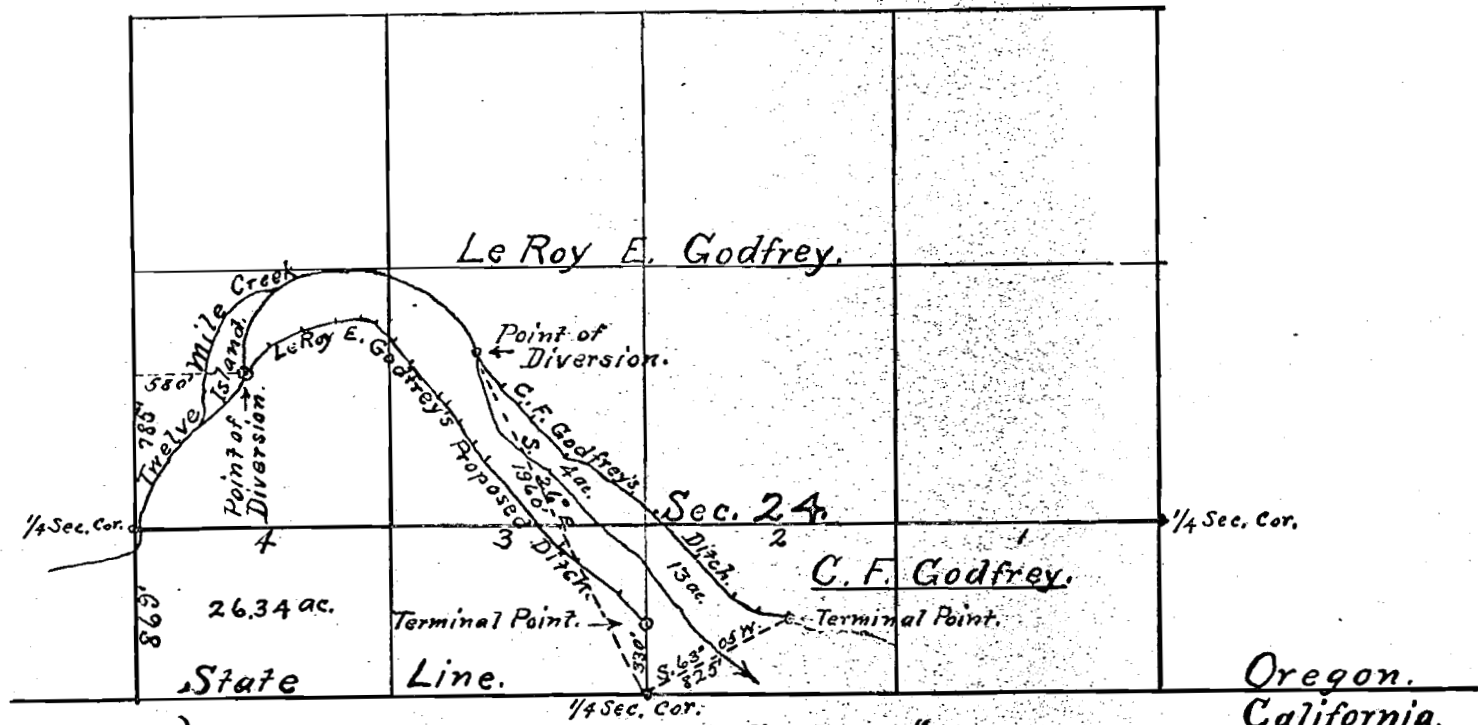

State of California, } ss.
County of Modoc. }

Scale: 1" = 1000'.

I, Geo. T. Cline, being first duly sworn, depose and say that the above map is a true and accurate plat of the irrigation ditch owned by C.F. Godfrey, as taken from the field notes of a survey made by me, completed on the 11th day of July, 1922, at the instance of C.F. Godfrey, and that the map shows the location of streams and ditches in the immediate vicinity.

Geo. T. Cline, Surveyor.

Subscribed and sworn to before me this day of July, 1922.

Notary Public in and for Modoc County, California.

5610
7324