


MAP  
 Accompanying application  
 of E.H. NORRIS  
 for  
 a Permit to appropriate  
 Water.  
 Sec 9, Twp 29 S. R. 12  
 W. N. M.  
 Coos Co. Ore  
 Scale 2 inches = one mile

Twp 29 S. R 12 W. N. M.

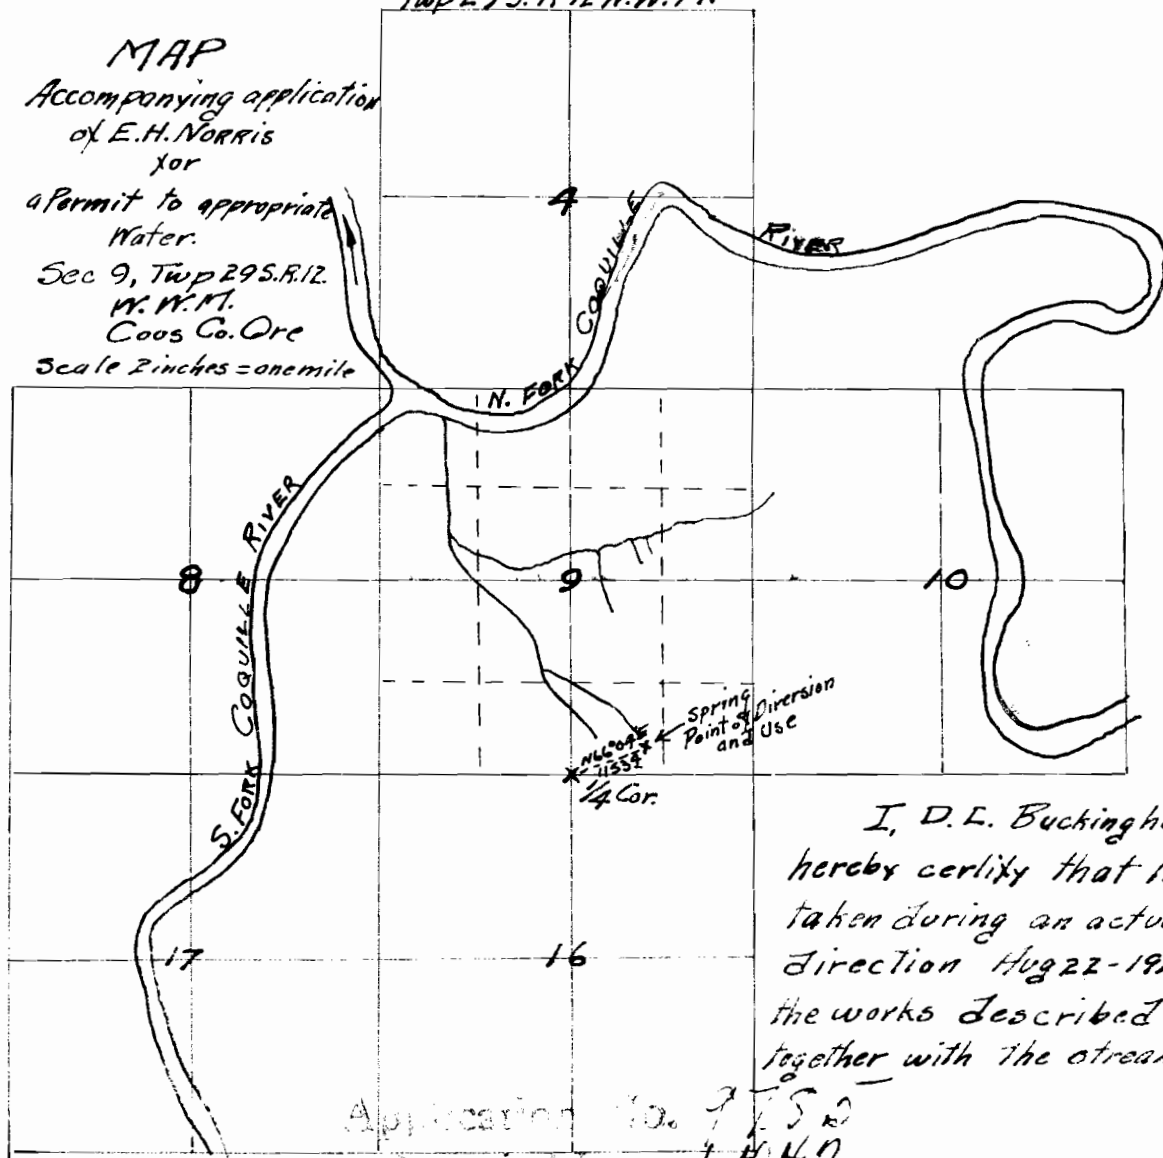

D. L. Buckingham  
 19

I, D. L. Buckingham, of Marshfield Oregon,  
 hereby certify that this map was made from notes  
 taken during an actual survey made under my  
 direction Aug 22-1924 and that it correctly represents  
 the works described in the accompanying application  
 together with the streams in the immediate vicinity.

D. L. Buckingham

Application No. 7752  
 Permit No. 6442