

SEC. COR.
FD. BLM BRASS
CAP

22 23
27 26

1/4 COR.
FD. BLM BRASS
CAP

N.00° 35' 00" E
2640.58

WELL NO. 1 LOCATED 141.8' EAST &
30.1' SOUTH OF 1/4 27 26

T29S , R17E , W.M. , LAKE COUNTY

WELL NO. 2 LOCATED 2605.9' EAST &
179.1' SOUTH OF 1/4 27 26

NW 1/4
SW 1/4

NE 1/4
SW 1/4

NW 1/4
SE 1/4

SE 1/4
SW 1/4

SW 1/4
SE 1/4

27 26
34 35

26 25
35 36

NE 1/4
NW 1/4

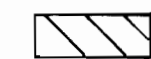
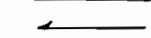
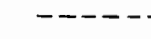
12 AC. TOTAL
NW 1/4
NE 1/4

SE 1/4
NW 1/4

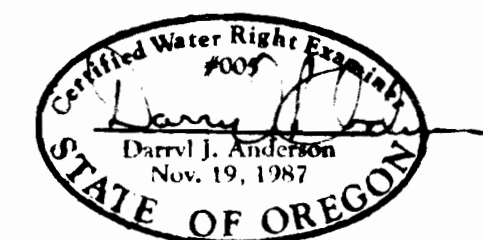
SW 1/4
NE 1/4

SCALE 1" = 400'

LEGEND

-  FLOOD IRRIGATED AREAS AS NOTED
-  DIRECTION OF FLOW FOR FLOOD IRRIGATION
-  SECTION LINE
-  SECTIONAL SUBDIVISIONAL LINE
-  FOUND MONUMENT AS NOTED
-  EXISTING DITCH

NOTE: PREPARATION OF THIS MAP IS FOR PURPOSES OF IDENTIFYING LOCATIONS OF WATER RIGHTS ONLY. IT HAS NO INTENT TO PROVIDE DIMENSIONS OR LOCATIONS OF PROPERTY BOUNDARIES.



FINAL PROOF SURVEY UNDER

APPLICATION NO. G-11742 PERMIT NO. G-10888

IN THE NAME OF
GEORGE CARLON

SURVEYED BY:
ANDERSON ENGINEERING & SURVEYING
618 SOUTH FIRST STREET
P.O. BOX 28
LAKEVIEW, OREGON 97630

MARCH 1, 1990

SHEET 1 OF 1