


RECEIVED

# T.34 S., R.1 W., W.M.

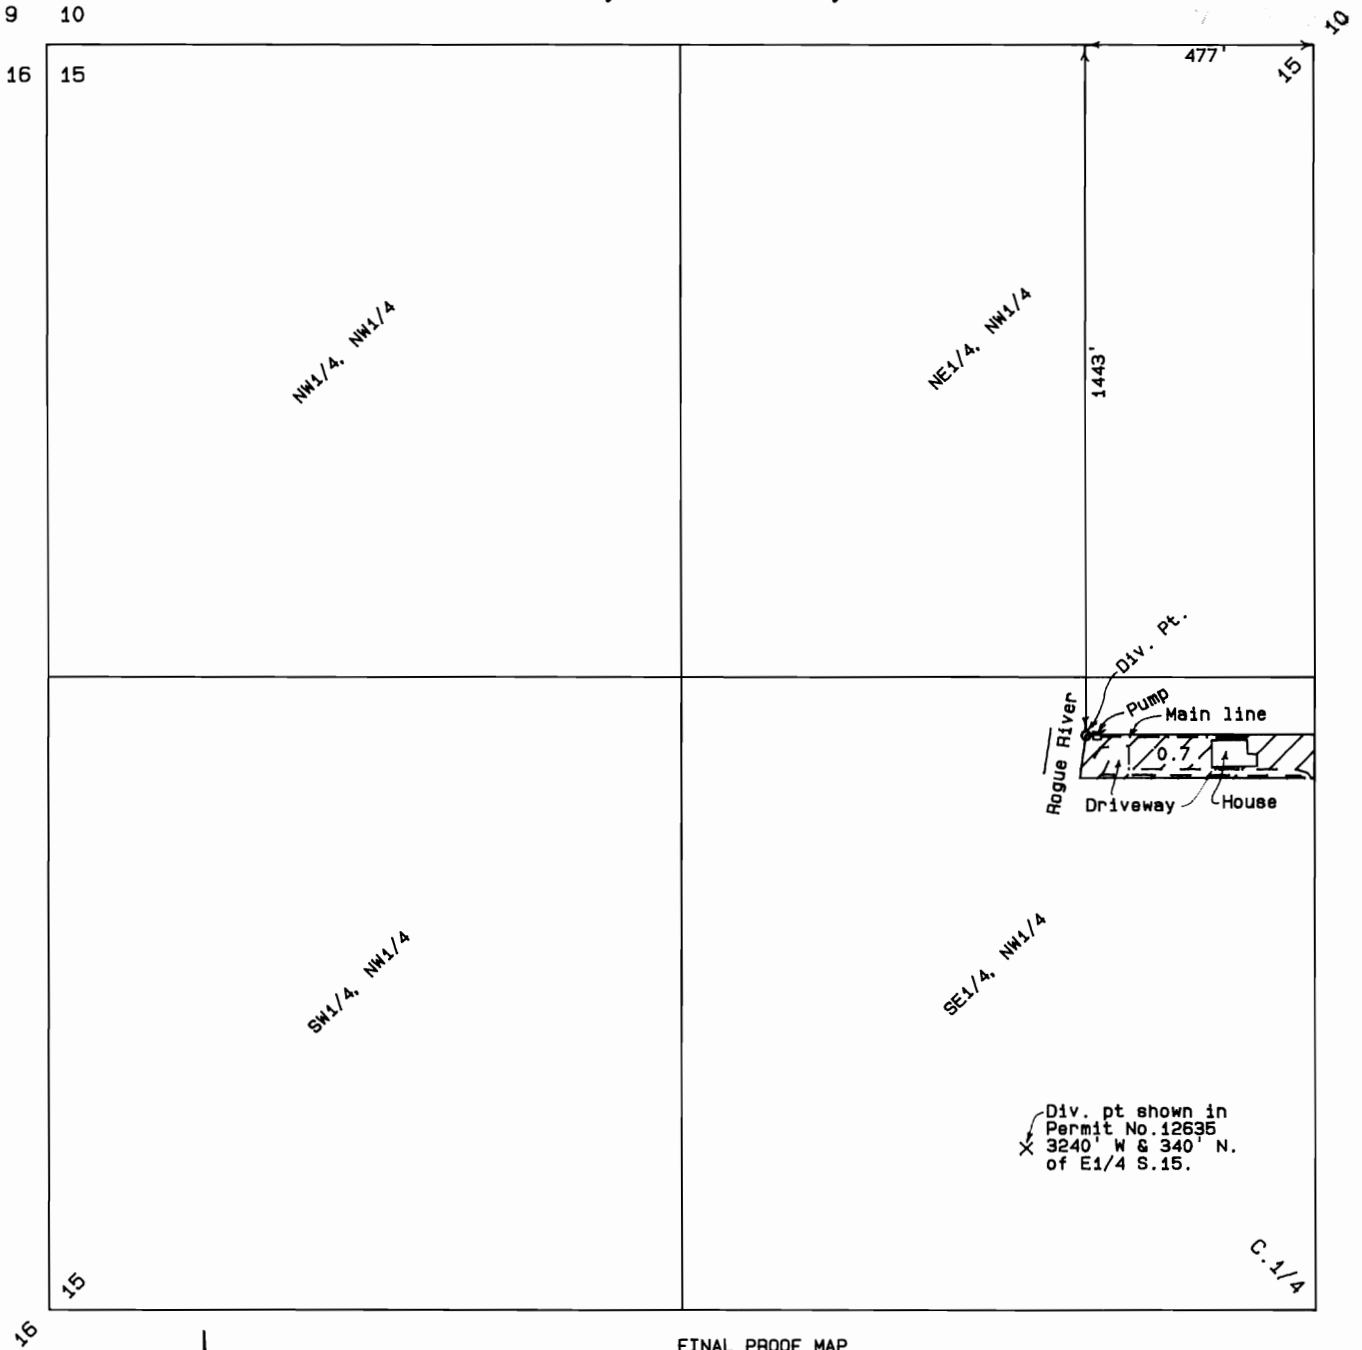

FINAL PROOF MAP  
 Application No. T-6765, Permit No. 12635,  
 in name of

PATRICIA M. MEHARRY

Mapped May 13, 1994 Scale 1" = 400'

Mapped by: L.J. Friar & Associates P.C.  
 Consulting Land Surveyors  
 304 South Holly Street  
 Medford, OR 97501  
 (503) 772-2782



THE PREPARATION OF THIS MAP WAS FOR THE PURPOSE OF IDENTIFYING THE WATER RIGHT AND HAS NO INTENT TO PROVIDE DIRECTION OR LOCATION OF PROPERTY OWNERSHIP LINES.

