


T.8S.,R.24E.,W.M.

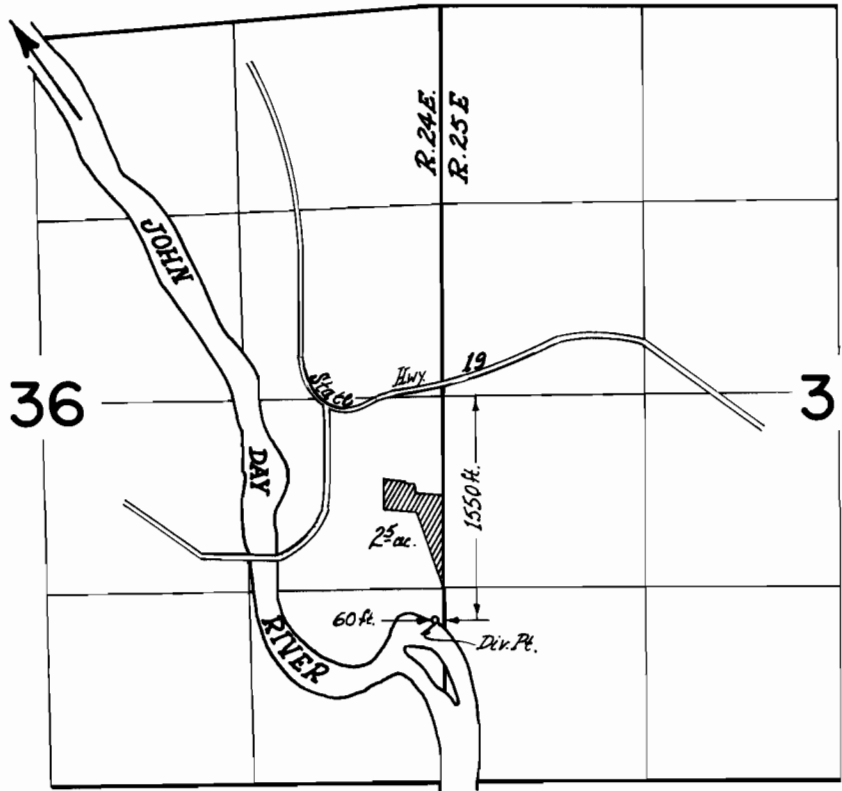

FINAL PROOF SURVEY
UNDER

Application No. 50459 Permit No. 38112
IN NAME OF

RALPH JACKSON

Surveyed Aug. 25 1977, by R.G. Mucken