




T. 35 S., R. 1 W., W.M.

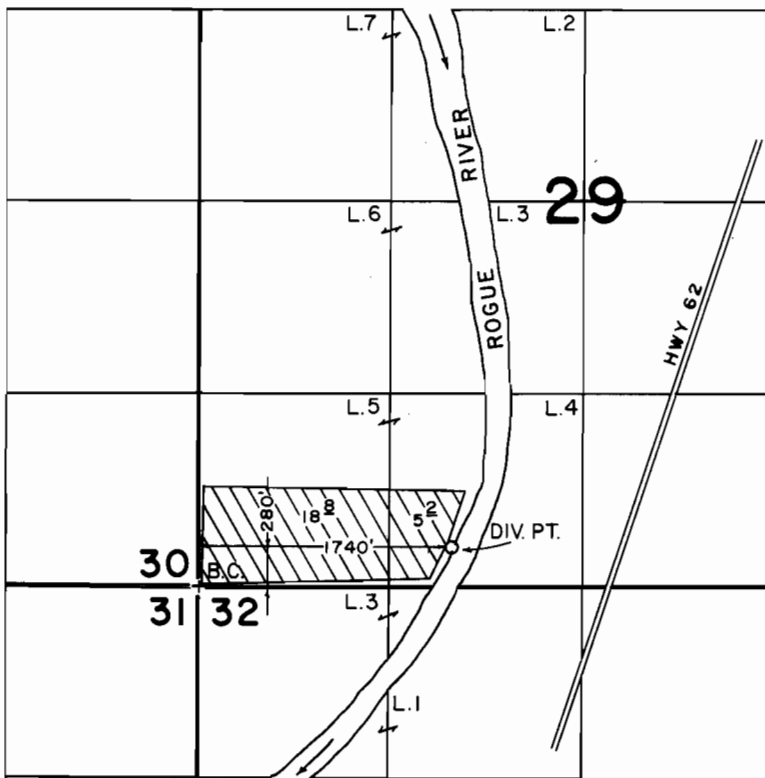

SCALE: 1" = 1320'

FINAL PROOF SURVEY
UNDER

69232 50173

Application No. 68533. Permit No. 49500.....

IN NAME OF

CARL J. STOKES

Surveyed MARCH 20 1990, by B. S. JAMES.....