


WATER RIGHT TRANSFER MAP SECTION 2, T1S, R3W, W.M.

RECEIVED

MAY 14 1988


WATER RESOURCES DEPT
SALEM, OREGON

FOR
EDMUND DUYCK
2020 S W 325 TH
HILLSBORO, OR 97123

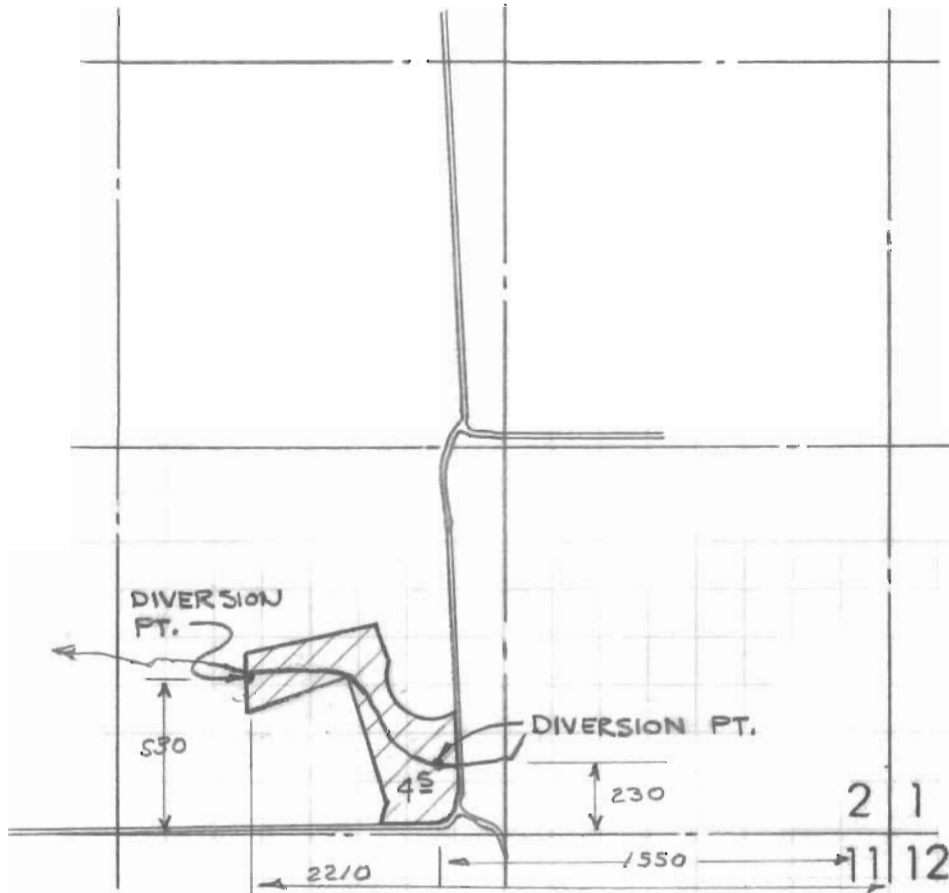

SCALE: 1" = 660'

PREPARED BY:
W. RICHARD VERBOORT, P. E.

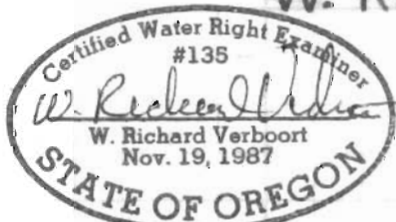

4/26/88

PREPARATION OF THIS MAP IS FOR THE
PURPOSE OF IDENTIFYING THE LOCATION OF
THE WATER RIGHT ONLY. THERE IS NO INTENT
TO PROVIDE DIMENSIONS OR LOCATION OF
PROPERTY OWNERSHIP LINES.