


RECEIVED


FEB 03 1999

WATER RESOURCES DEPT  
SALEM, OREGON

T.35S.,R.1W.,W.M.

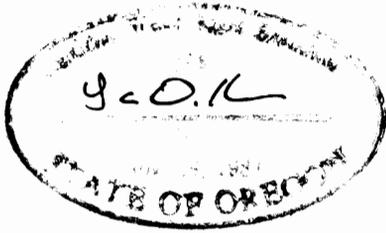

SCALE 1" = 400'

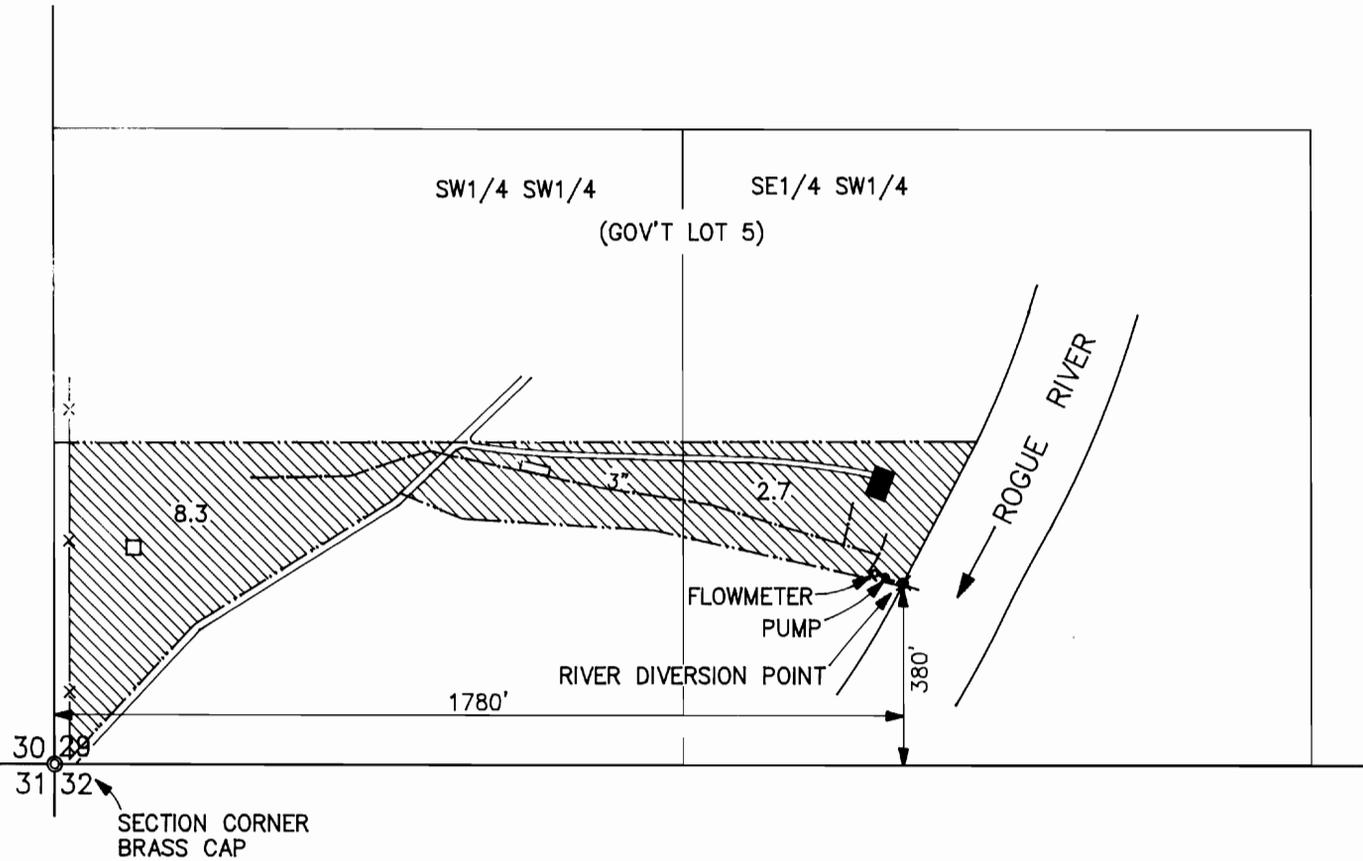

# FINAL PROOF MAP

APPLICATION No. I-7555


IN THE NAME OF  
CARL J. STOKES

NOTE: MAP PREPARED FOR  
WATER RIGHT PURPOSES ONLY,  
NOT FOR PROPERTY BOUNDARY  
LOCATIONS.

MAP PREPARED JANUARY 22, 1999 BY GARY D. KAISER



# T. 35 S., R. 1 W., W.M.

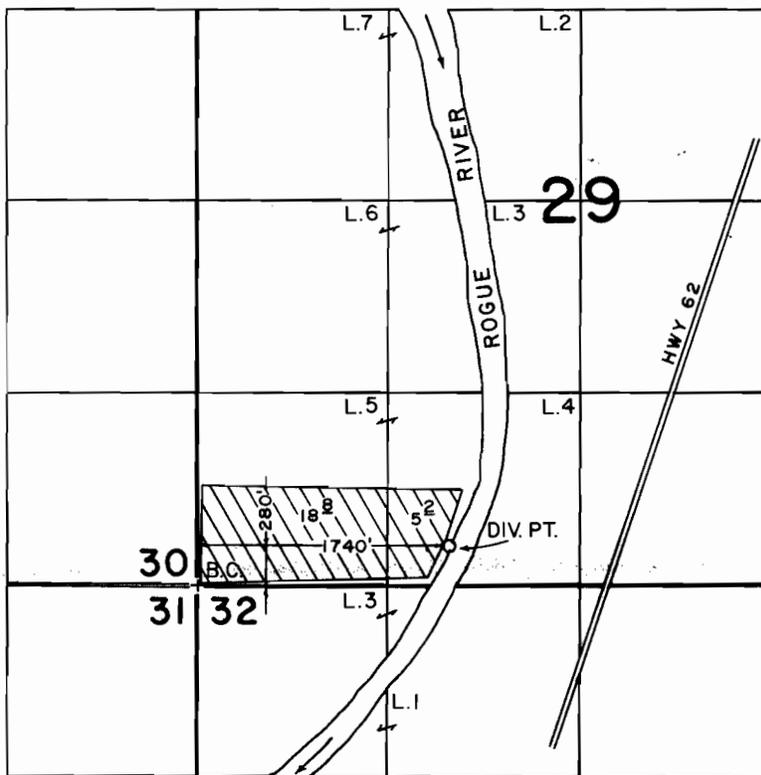

SCALE: 1" = 1320'

## FINAL PROOF SURVEY UNDER

69232                      50173

Application No. 68533 Permit No. 49500

IN NAME OF

**CARL J. STOKES**

Surveyed MARCH 20 19 90, by B. S. JAMES