




# T. 35 S., R. 1 W., W.M.

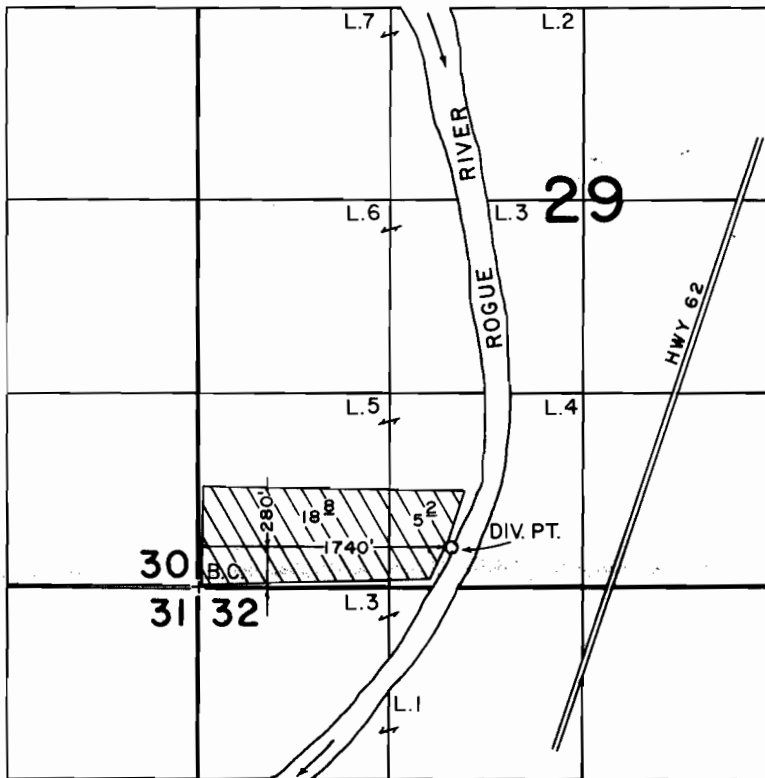

SCALE: 1" = 1320'

## FINAL PROOF SURVEY UNDER

69232                      50173

Application No. 68533 Permit No. 49500

IN NAME OF

**CARL J. STOKES**

Surveyed MARCH 20 19 90, by B. S. JAMES