


T.9S. R.39E. W.M.

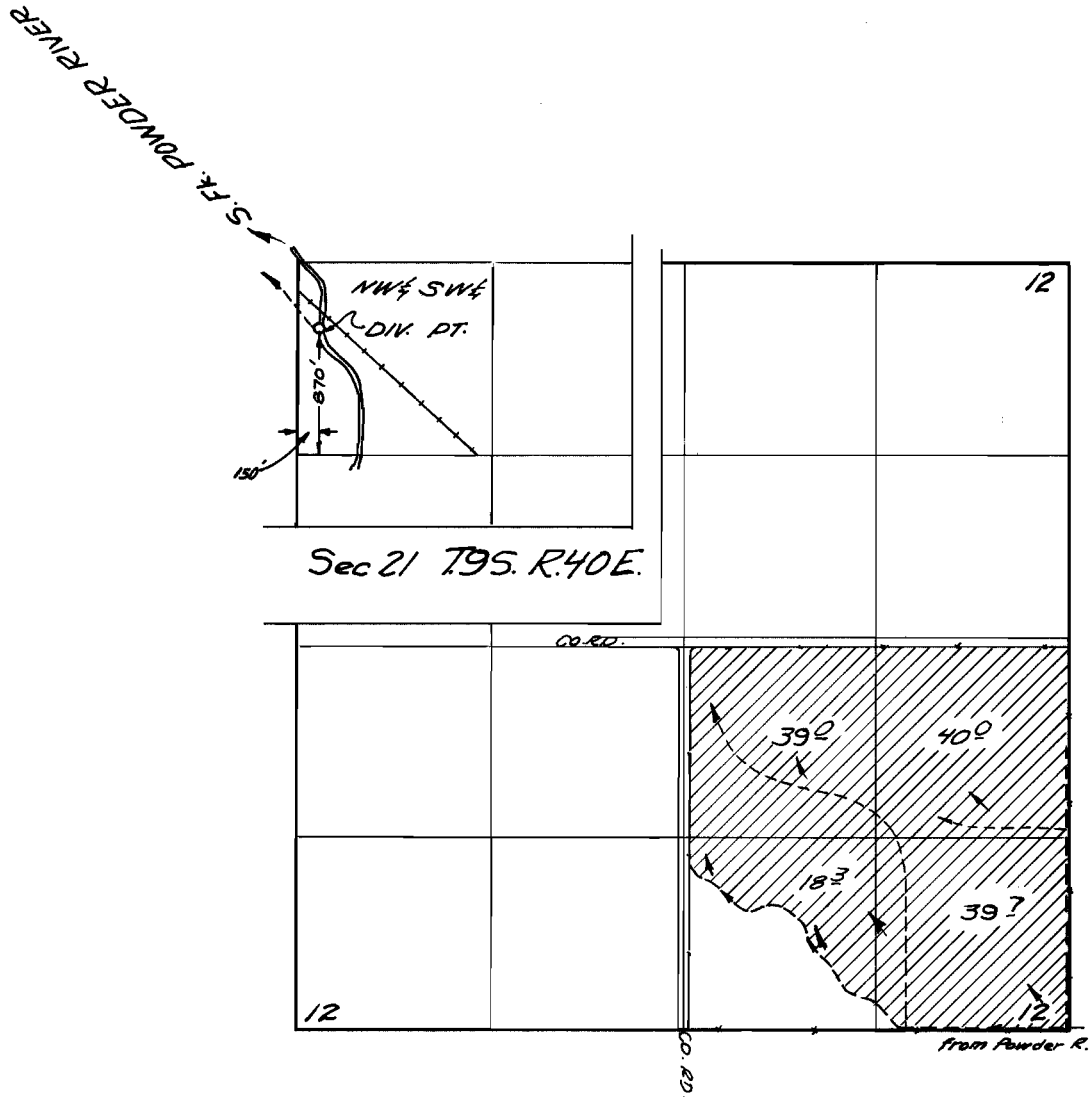

FINAL PROOF SURVEY UNDER

Application No. 40956... Permit No. 30544...
IN NAME OF

EDYTHE McELROY and ALENE BROWN

Surveyed July 26, 1967, by *V. Garner*.....