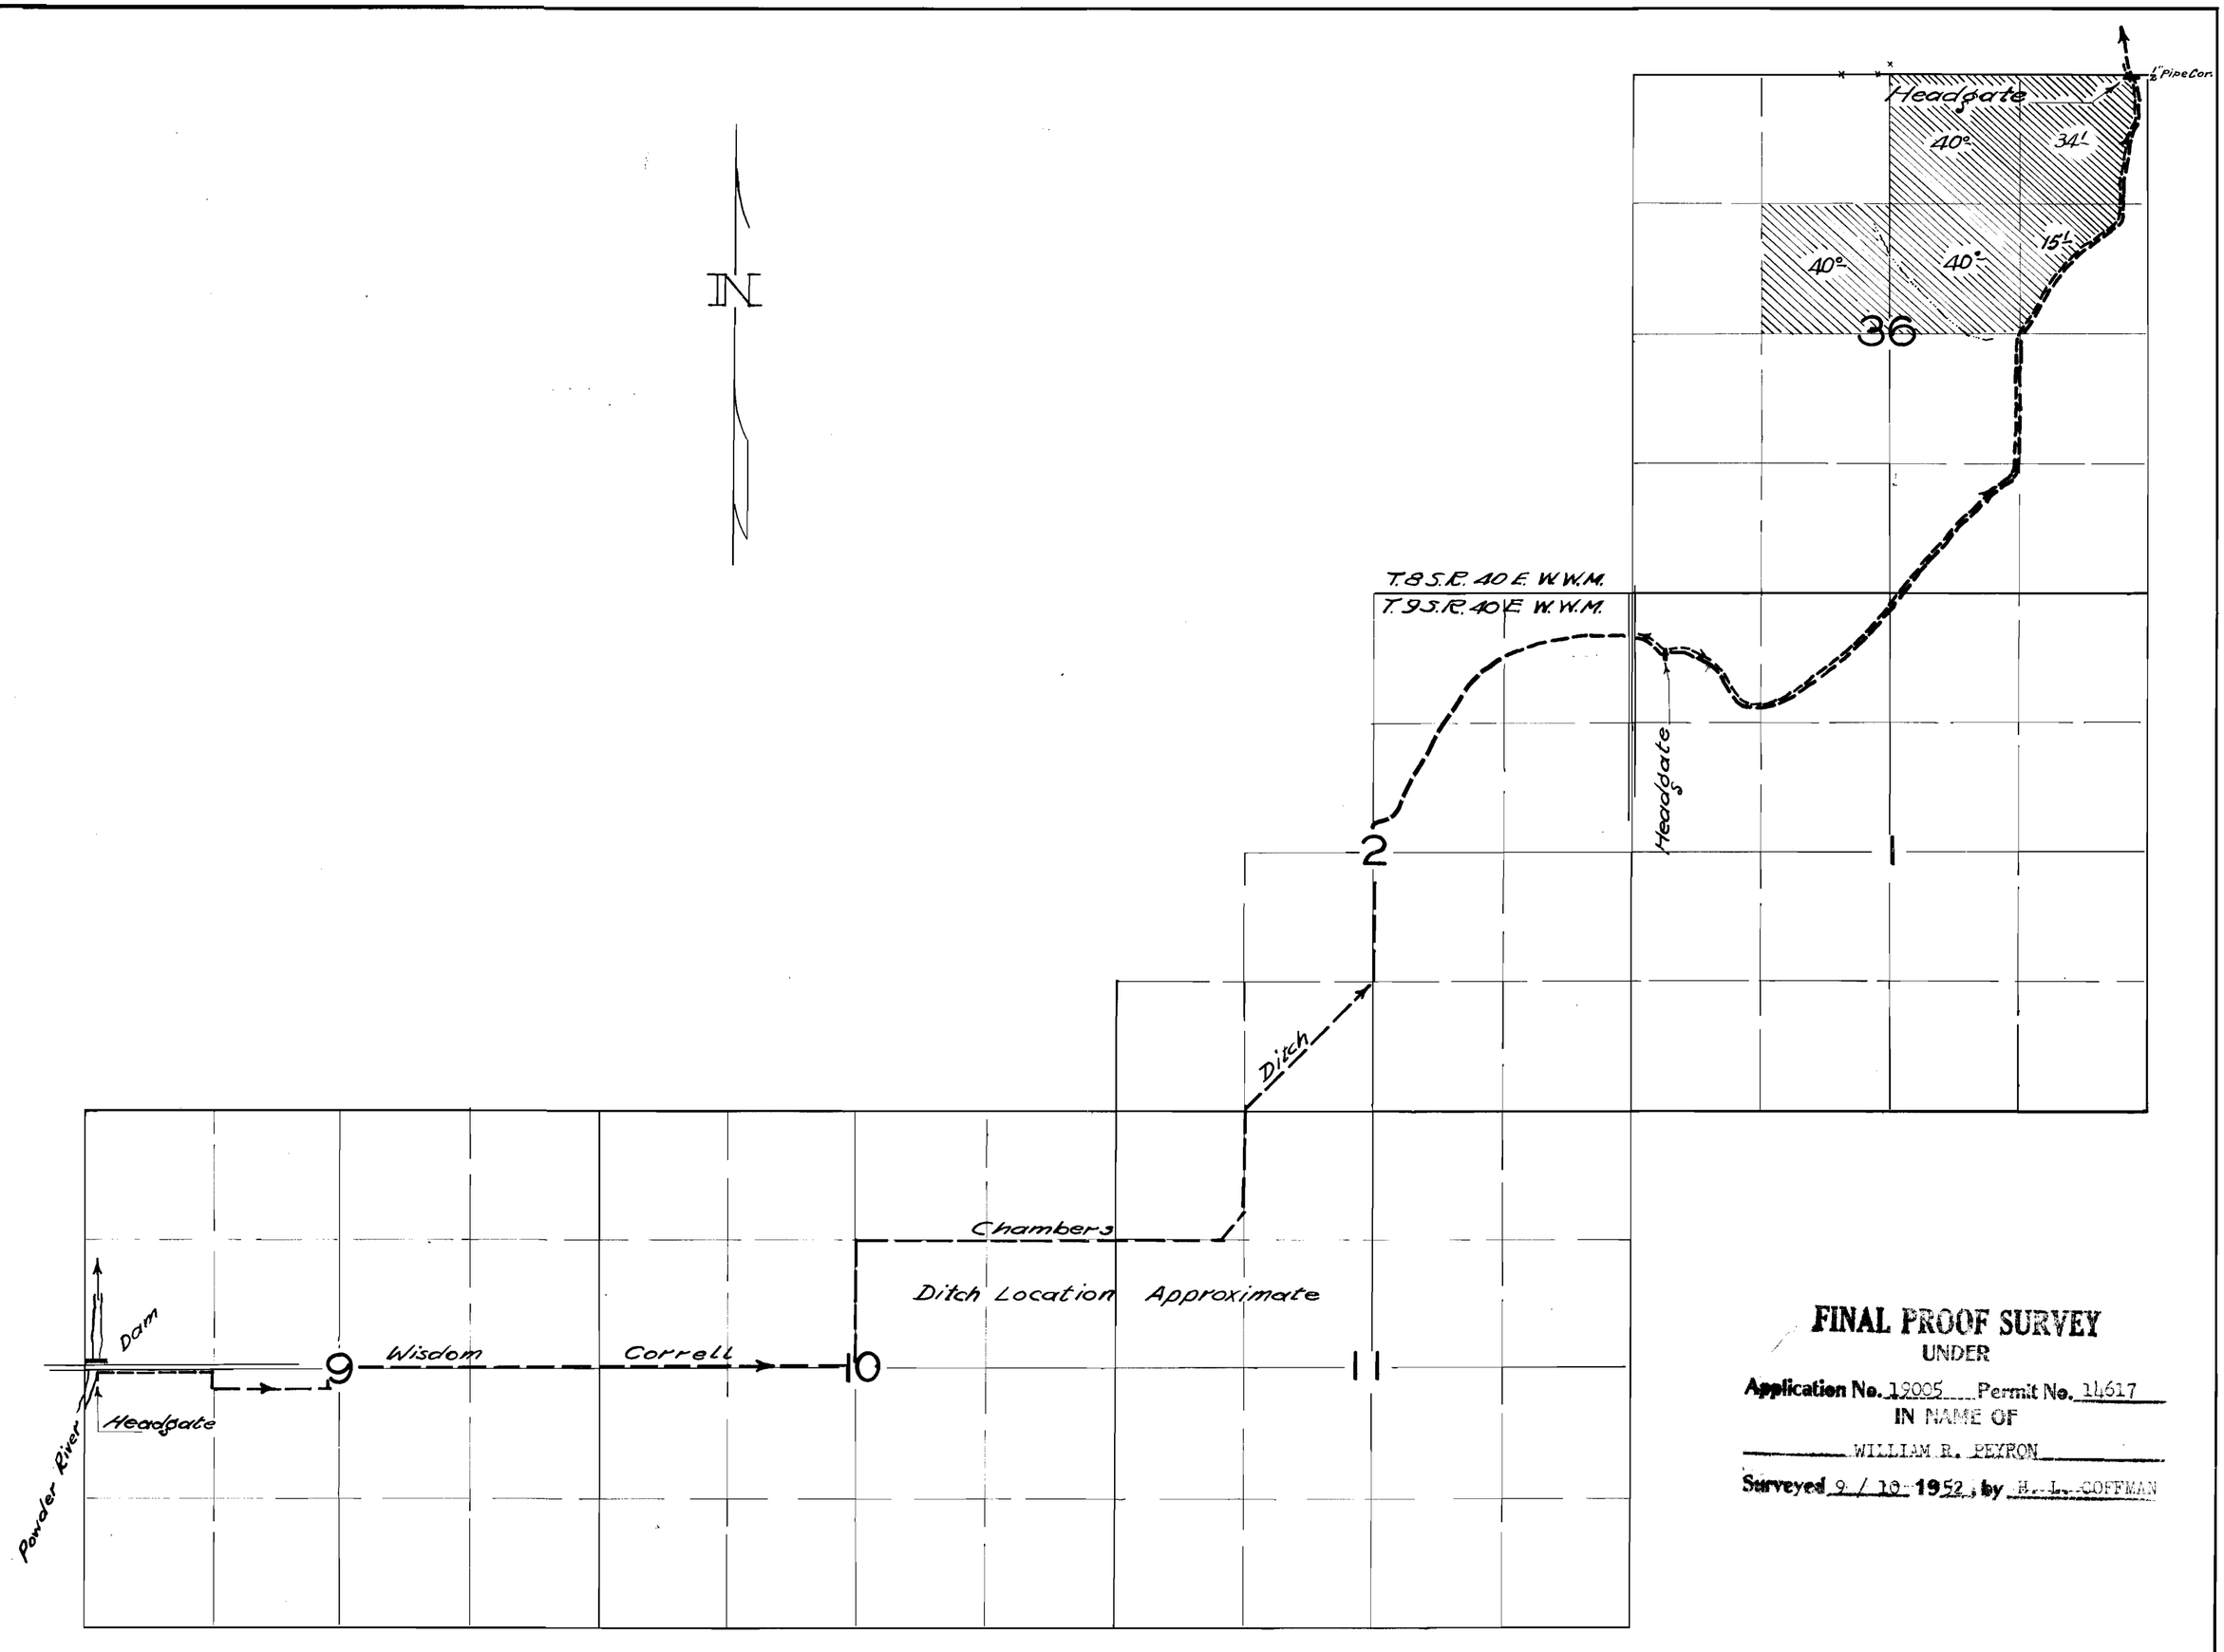

FINAL PROOF SURVEY
UNDER
Application No. 19005 Permit No. 11617
IN NAME OF
WILLIAM R. PEYRON
Surveyed 9 / 10 1952, by H. L. COFFMAN

1952 3