
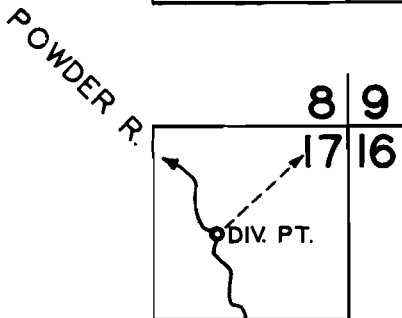


# T. 8 S. R. 40 E. W.M.

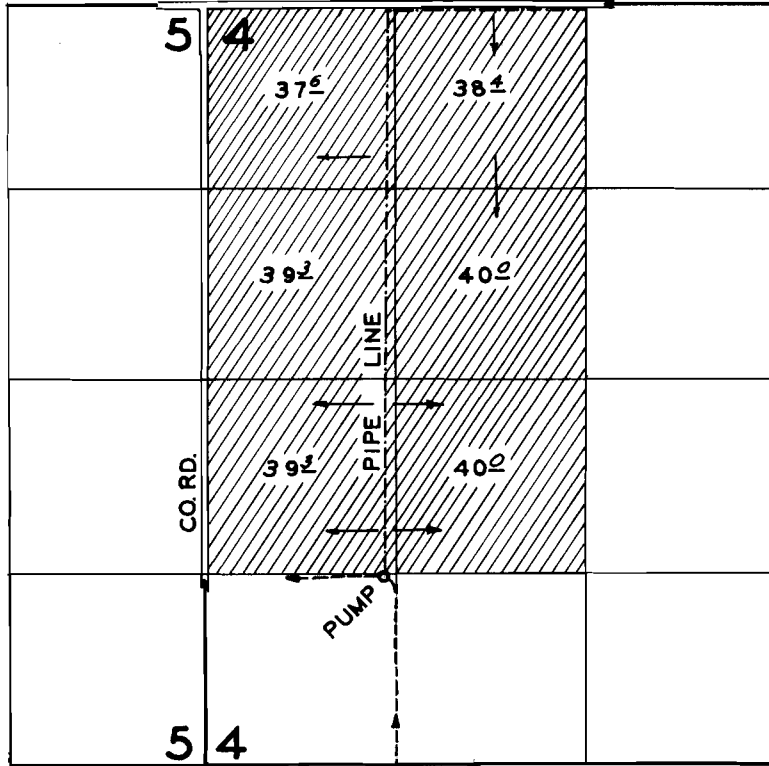

## FINAL PROOF SURVEY UNDER

Application No. 32365... Permit No. 25558...  
IN NAME OF

CHARLES. M. COLTON

Surveyed SEPT. 13. 19.60., by *L.H. Jackson*