



Application No. R-81288
Permit No. 1

RECEIVED
JAN - 3 1995
WATER RESOURCE
SALEM, OREGON

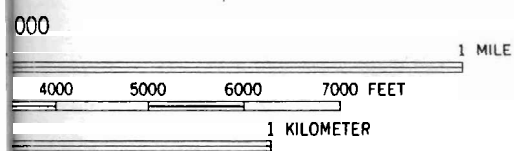

ROAD CLASSIFICATION
Medium-duty ——— Light-duty ———
Unimproved dirt =====

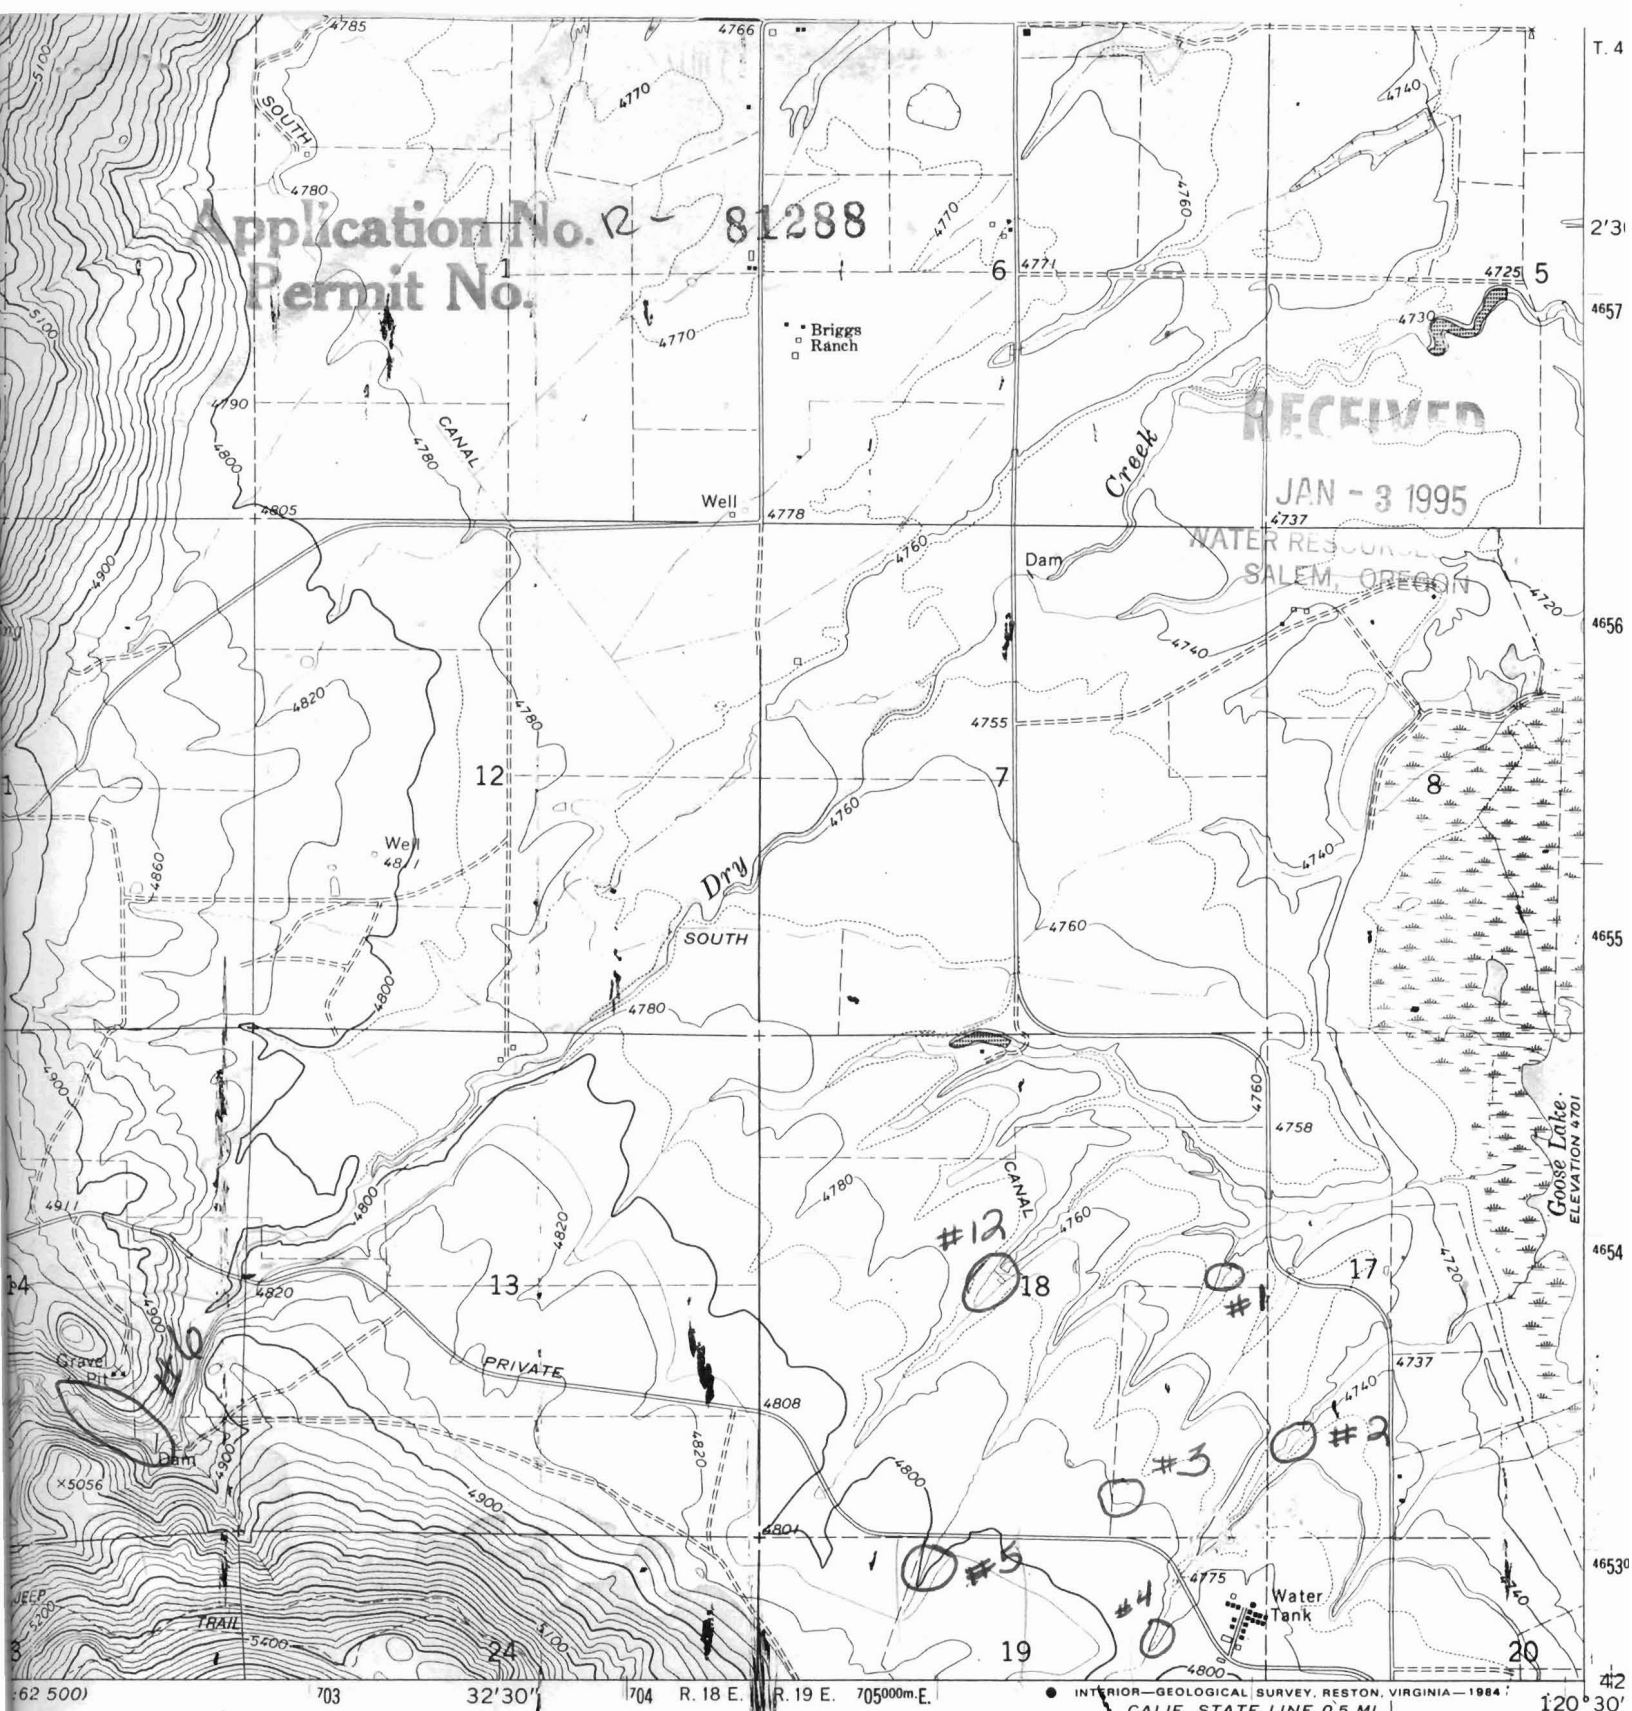

FITZWATER POINT, OREG.
N4200—W12030/7.5

1964
PHOTOREVISED 1980

MAP ACCURACY STANDARDS
COLORADO 80225, OR RESTON, VIRGINIA 22092
SYMBOLS IS AVAILABLE ON REQUEST

Revisions shown in purple compiled from aerial photographs
taken 1979 and other source data. This information not
field checked. Map edited 1980