


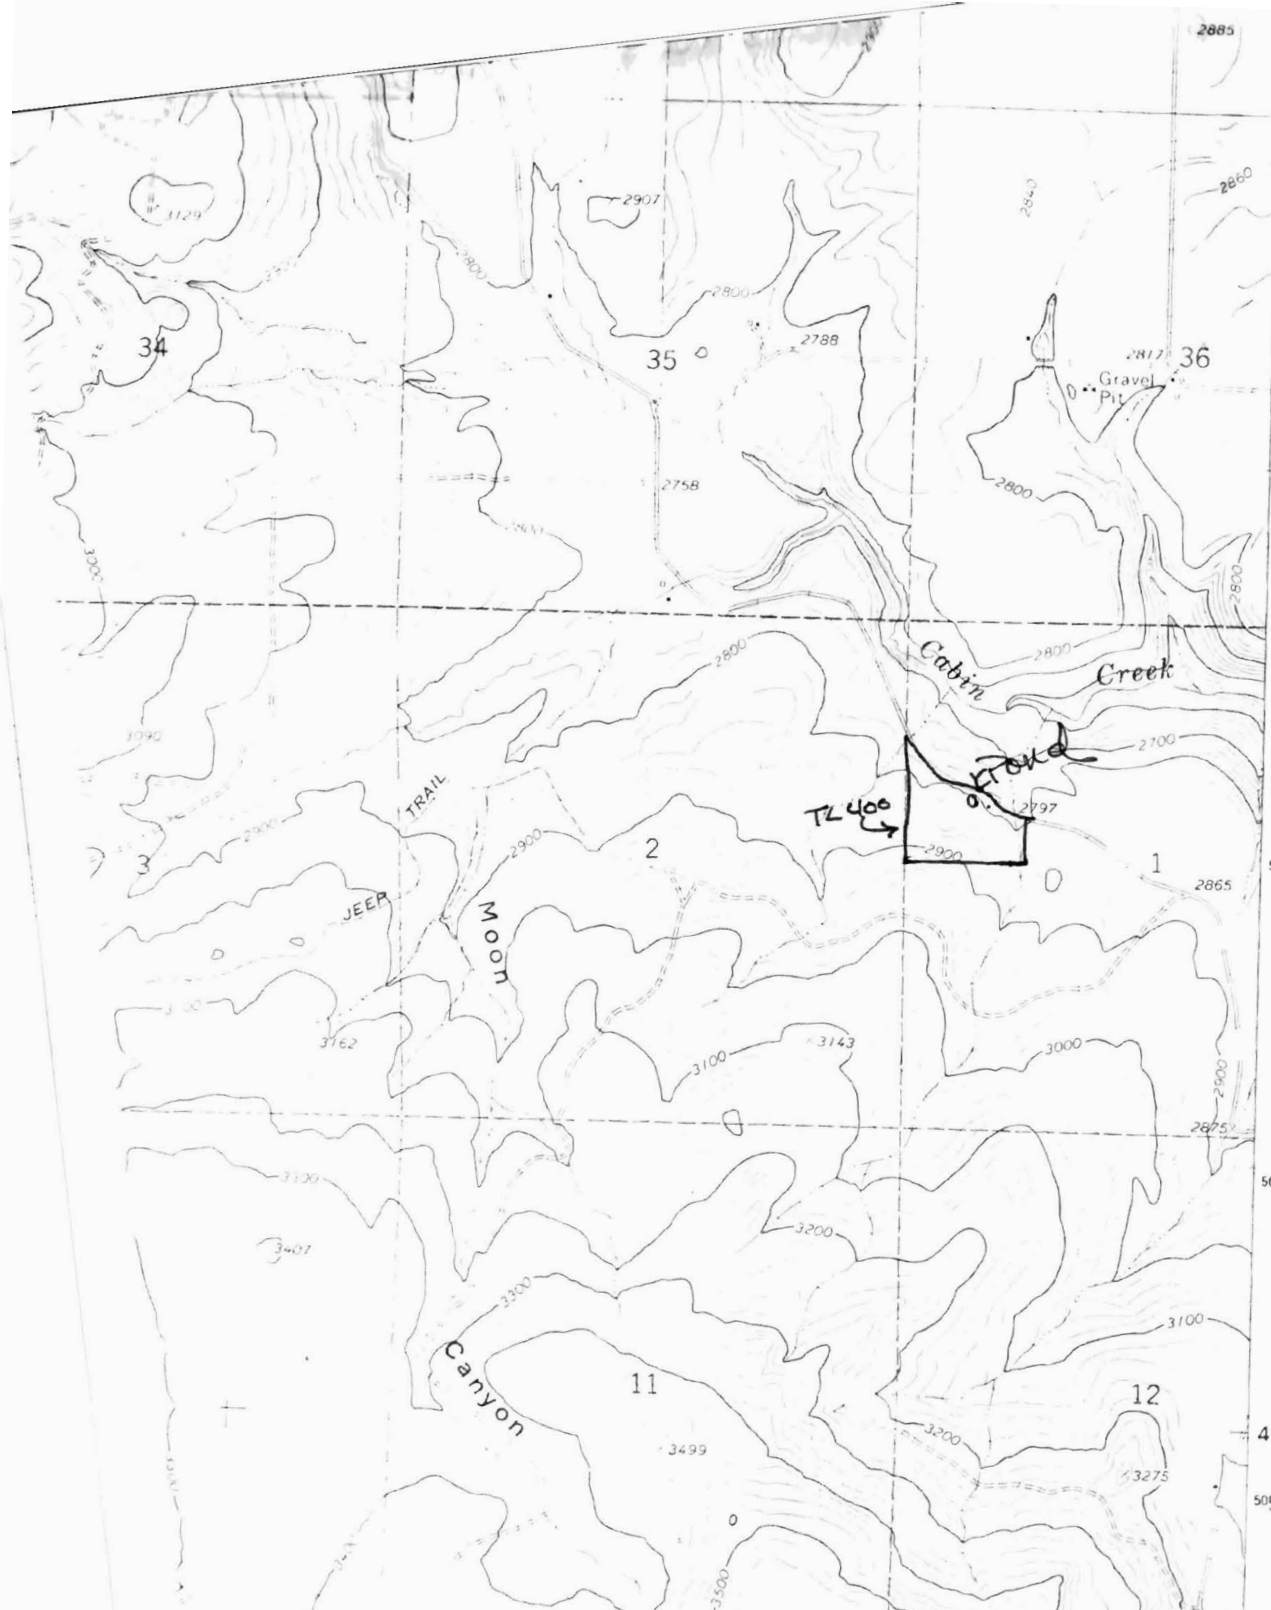

Twp 2N
R 39

RECEIVED

JUL 18 1996

WATER RESOURCES DEPT.
SALEM, OREGON

Application No. R-81322
Permit No. **RECEIVED**
JAN - 4 1995
WATER RESOURCES DEPT.
SALEM, OREGON