


Application No. E-81333
Permit No.

T. 31 S.
T. 32 S.
50'
1
MUD SPRING RESERVOIR 0.5 MI.
4743
12
DUHAIME FLAT WEST
JEEP
2169 IV SE
DUHAIME FLAT WEST

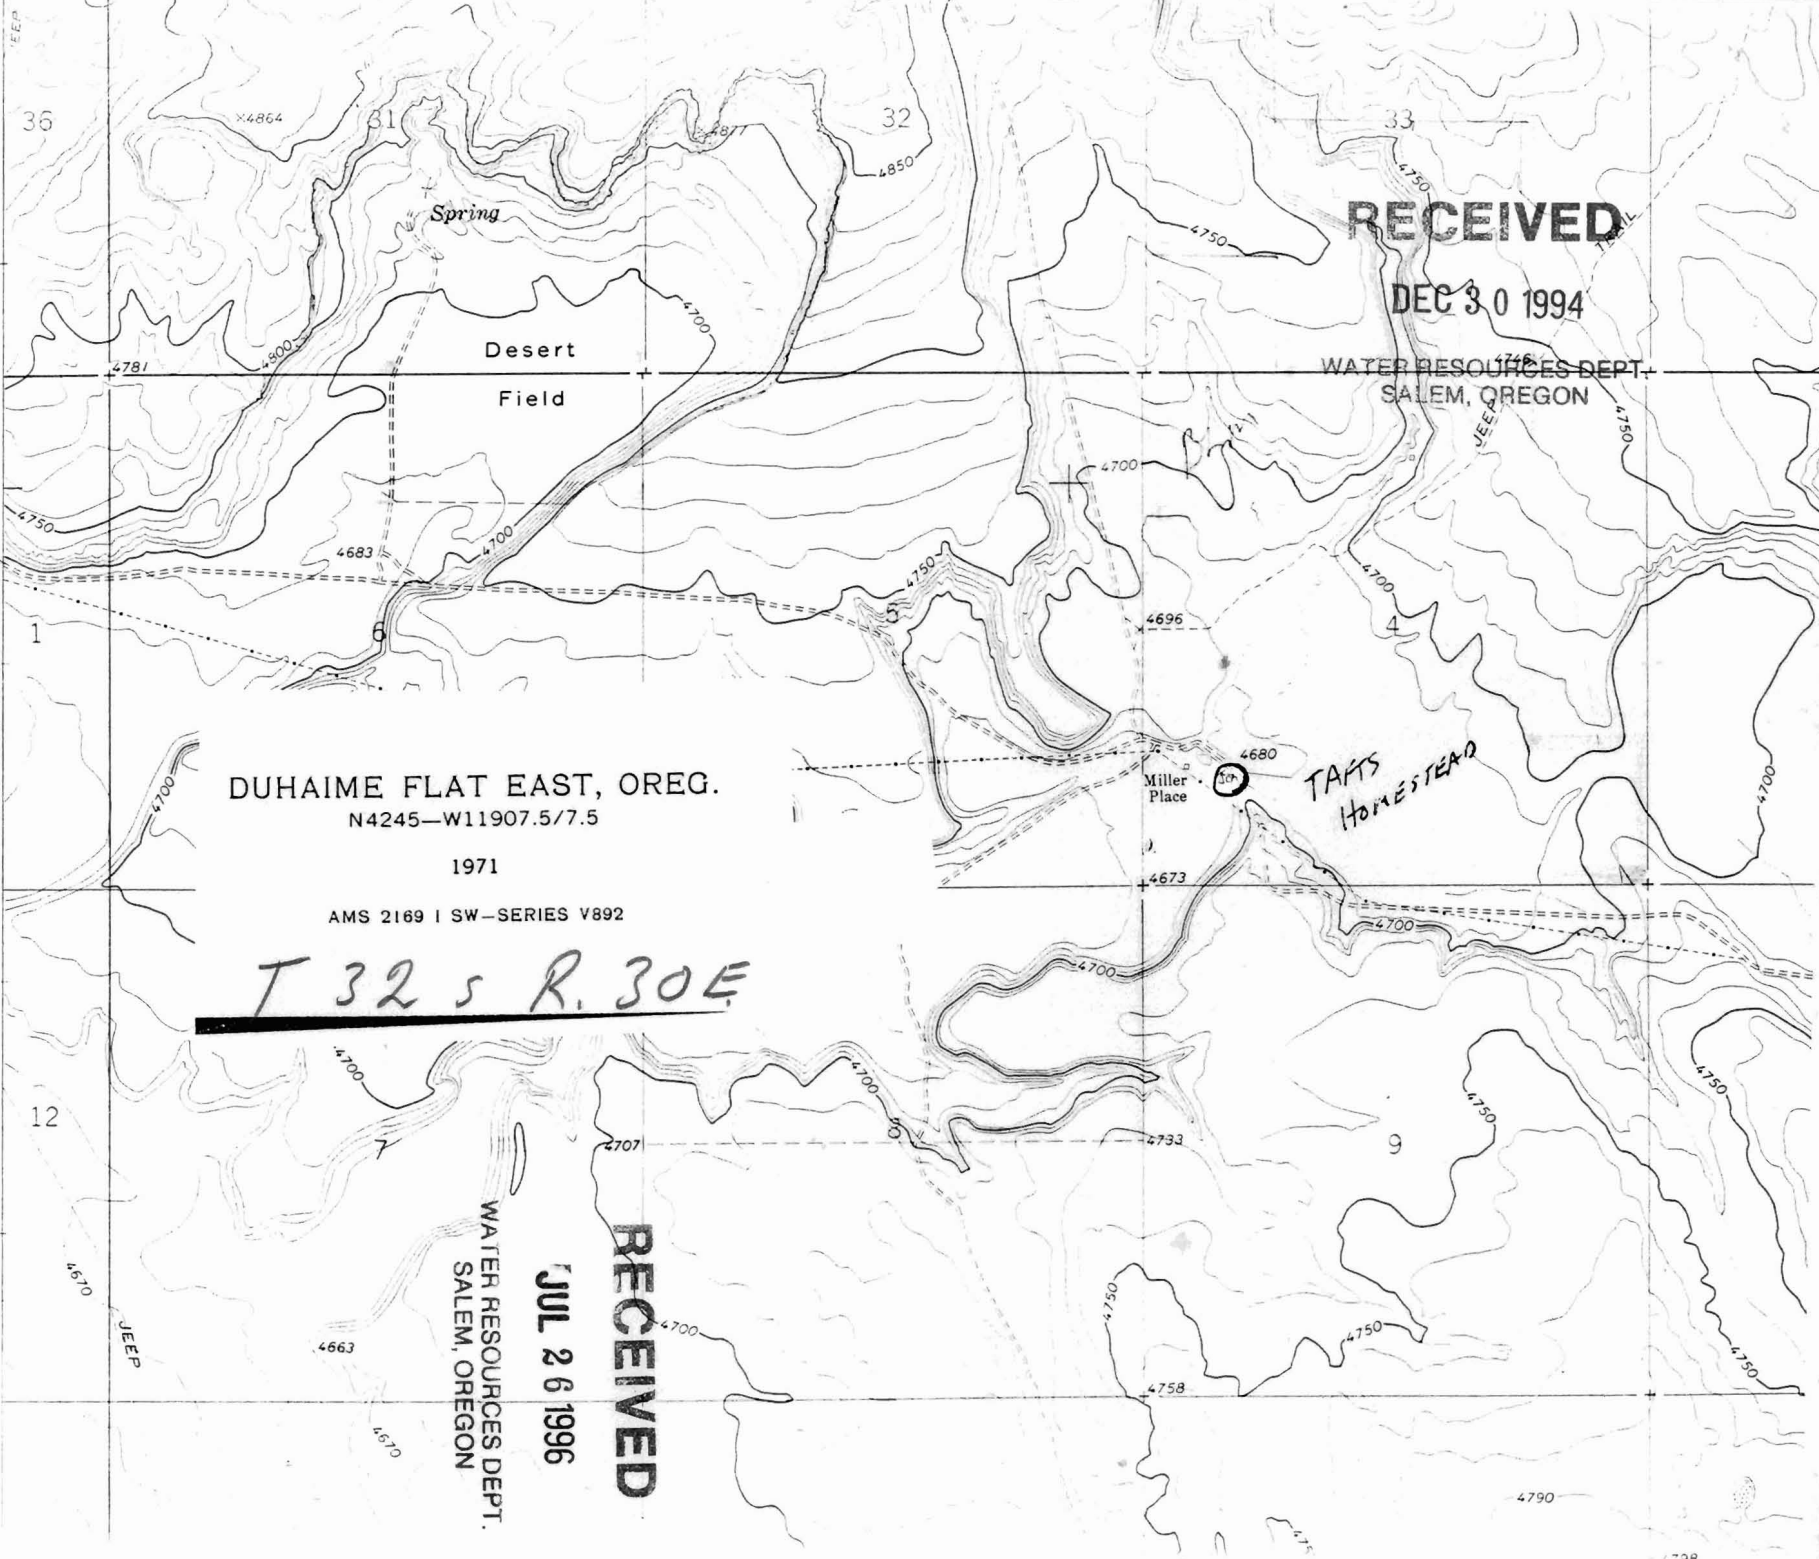

DUHAIME FLAT EAST, OREG.

N4245-W11907.5/7.5

1971

AMS 2169 I SW-SERIES V892

T 32 S R. 30 E

WATER RESOURCES DEPT.
SALEM, OREGON

JUL 26 1996

RECEIVED

RECEIVED

DEC 30 1994

WATER RESOURCES DEPT.
SALEM, OREGON