

RECEIVED

DEC 30 1994


WATER RESOURCES DEPT.
SALEM, OREGON

Application No. R-81350
Permit No.

RECEIVED

AUG - 1 1996

WATER RESOURCES DEPT.
SALEM, OREGON

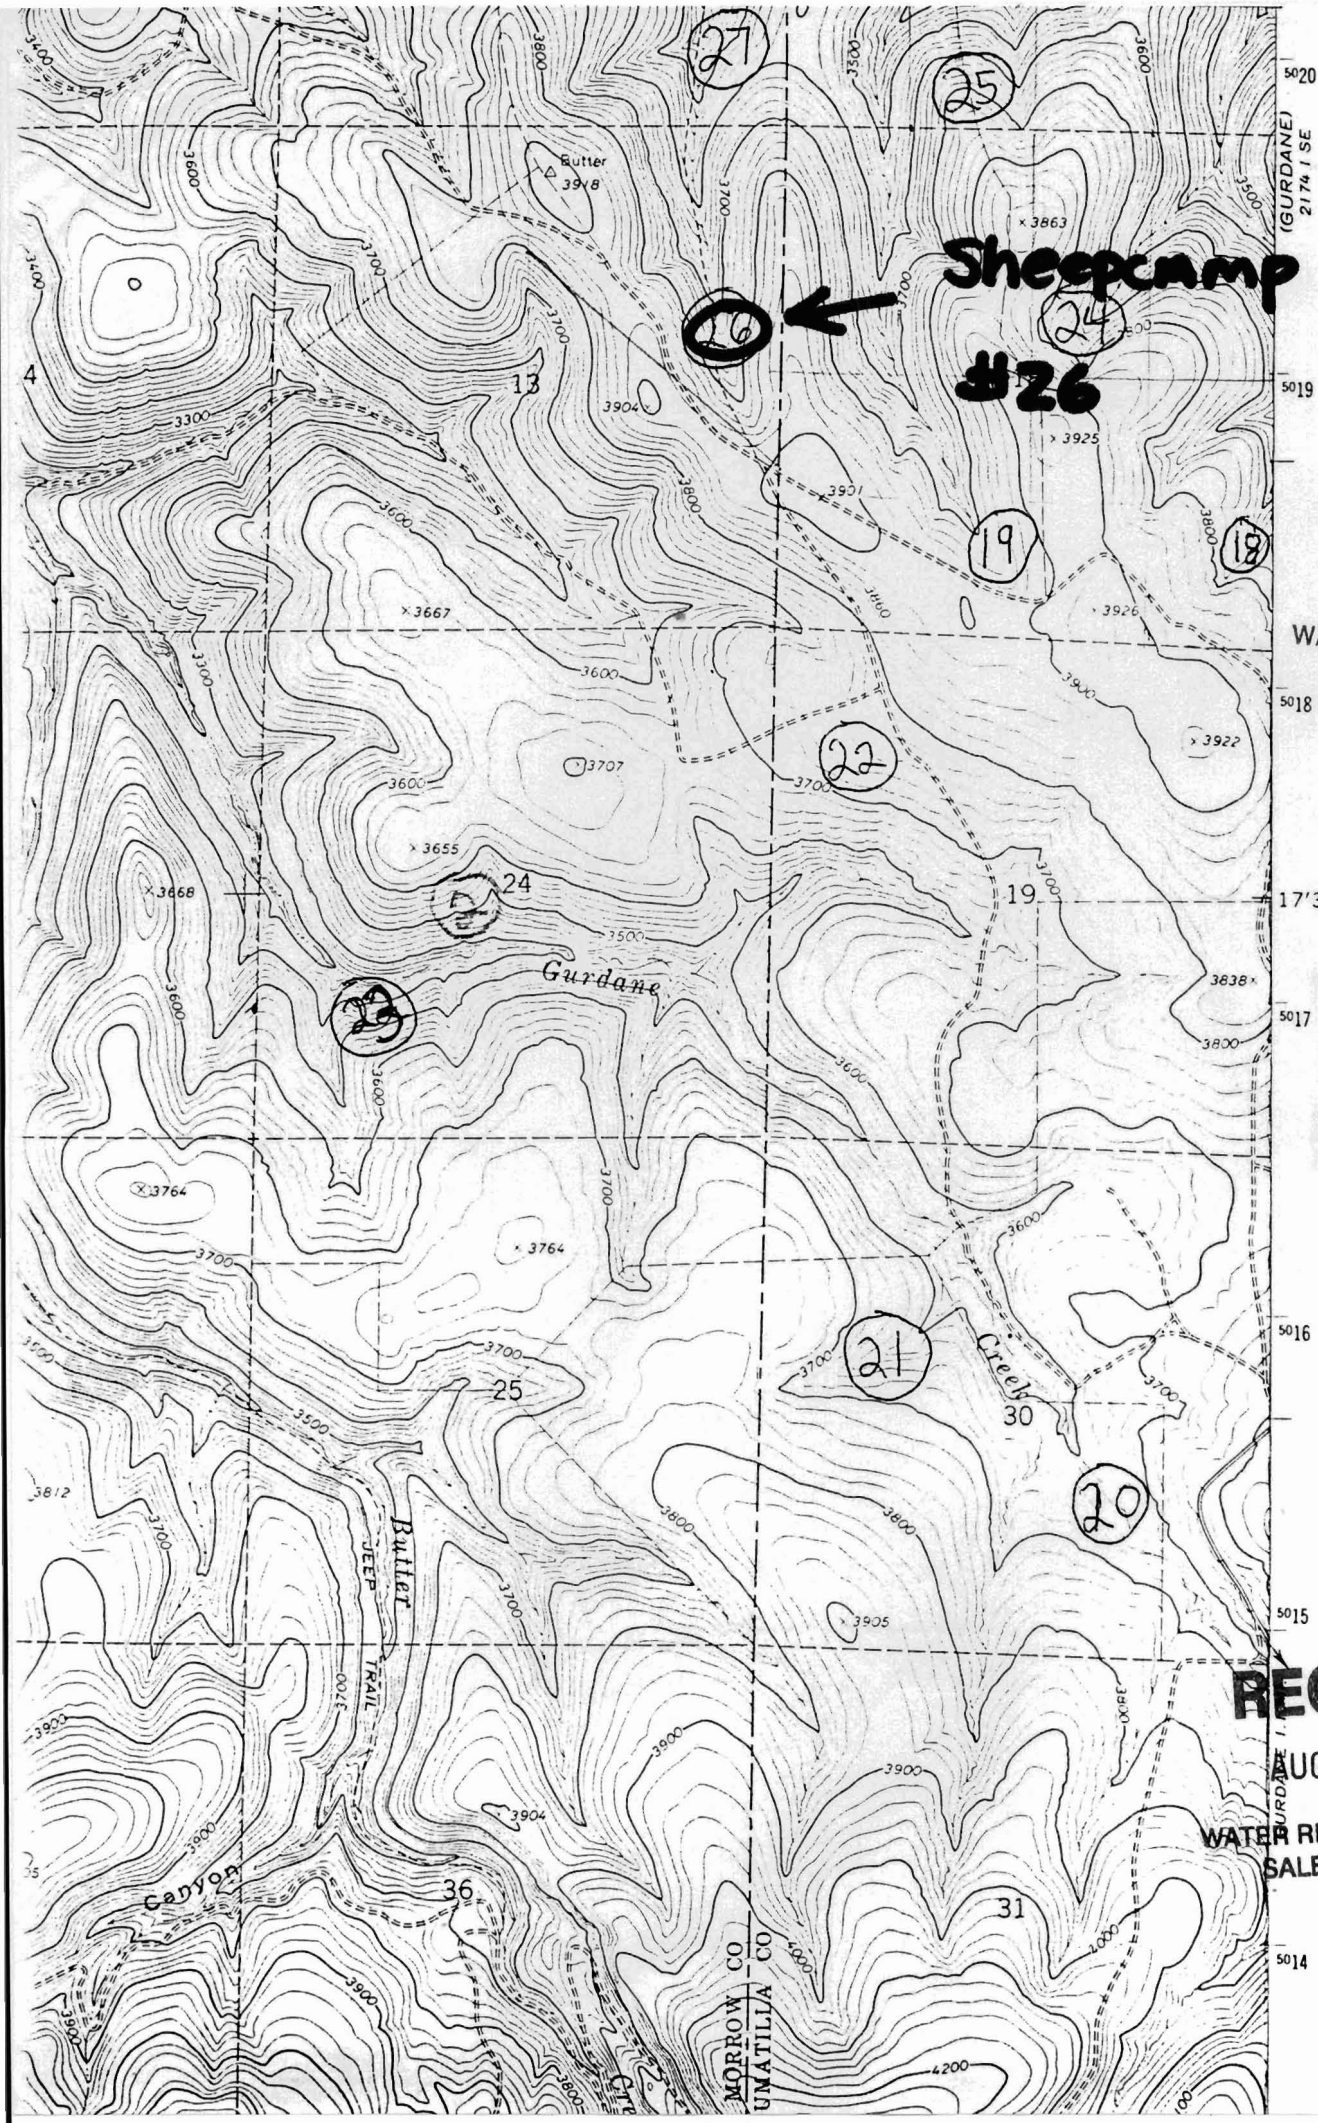

RECEIVED

DEC 30 1994

WATER RESOURCES DEPT.
SALEM, OREGON

Application No. R-813519
Permit No.

RECEIVED

AUG - 1 1996

WATER RESOURCES DEPT.
SALEM, OREGON