


RECEIVED

DEC 30 1994

WATER RESOURCES DEPT.  
SALEM, OREGON

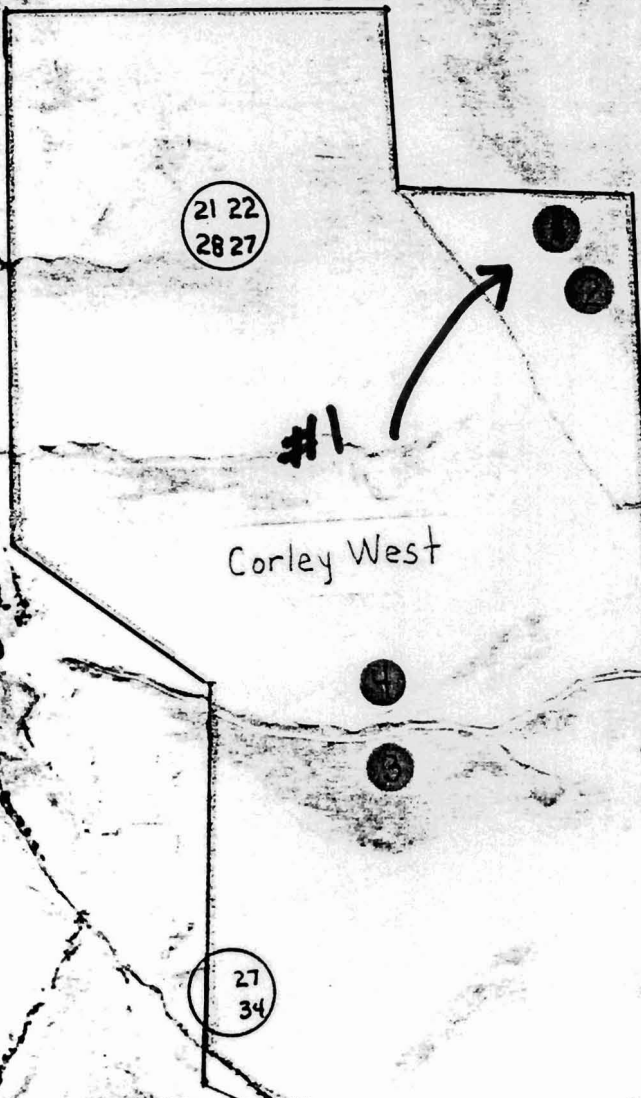

22 23  
27 26

RECEIVED


AUG - 1 1996

WATER RESOURCES DEPT.  
SALEM, OREGON

Cunningham  
Sheep  
Co.

27 26  
34 35



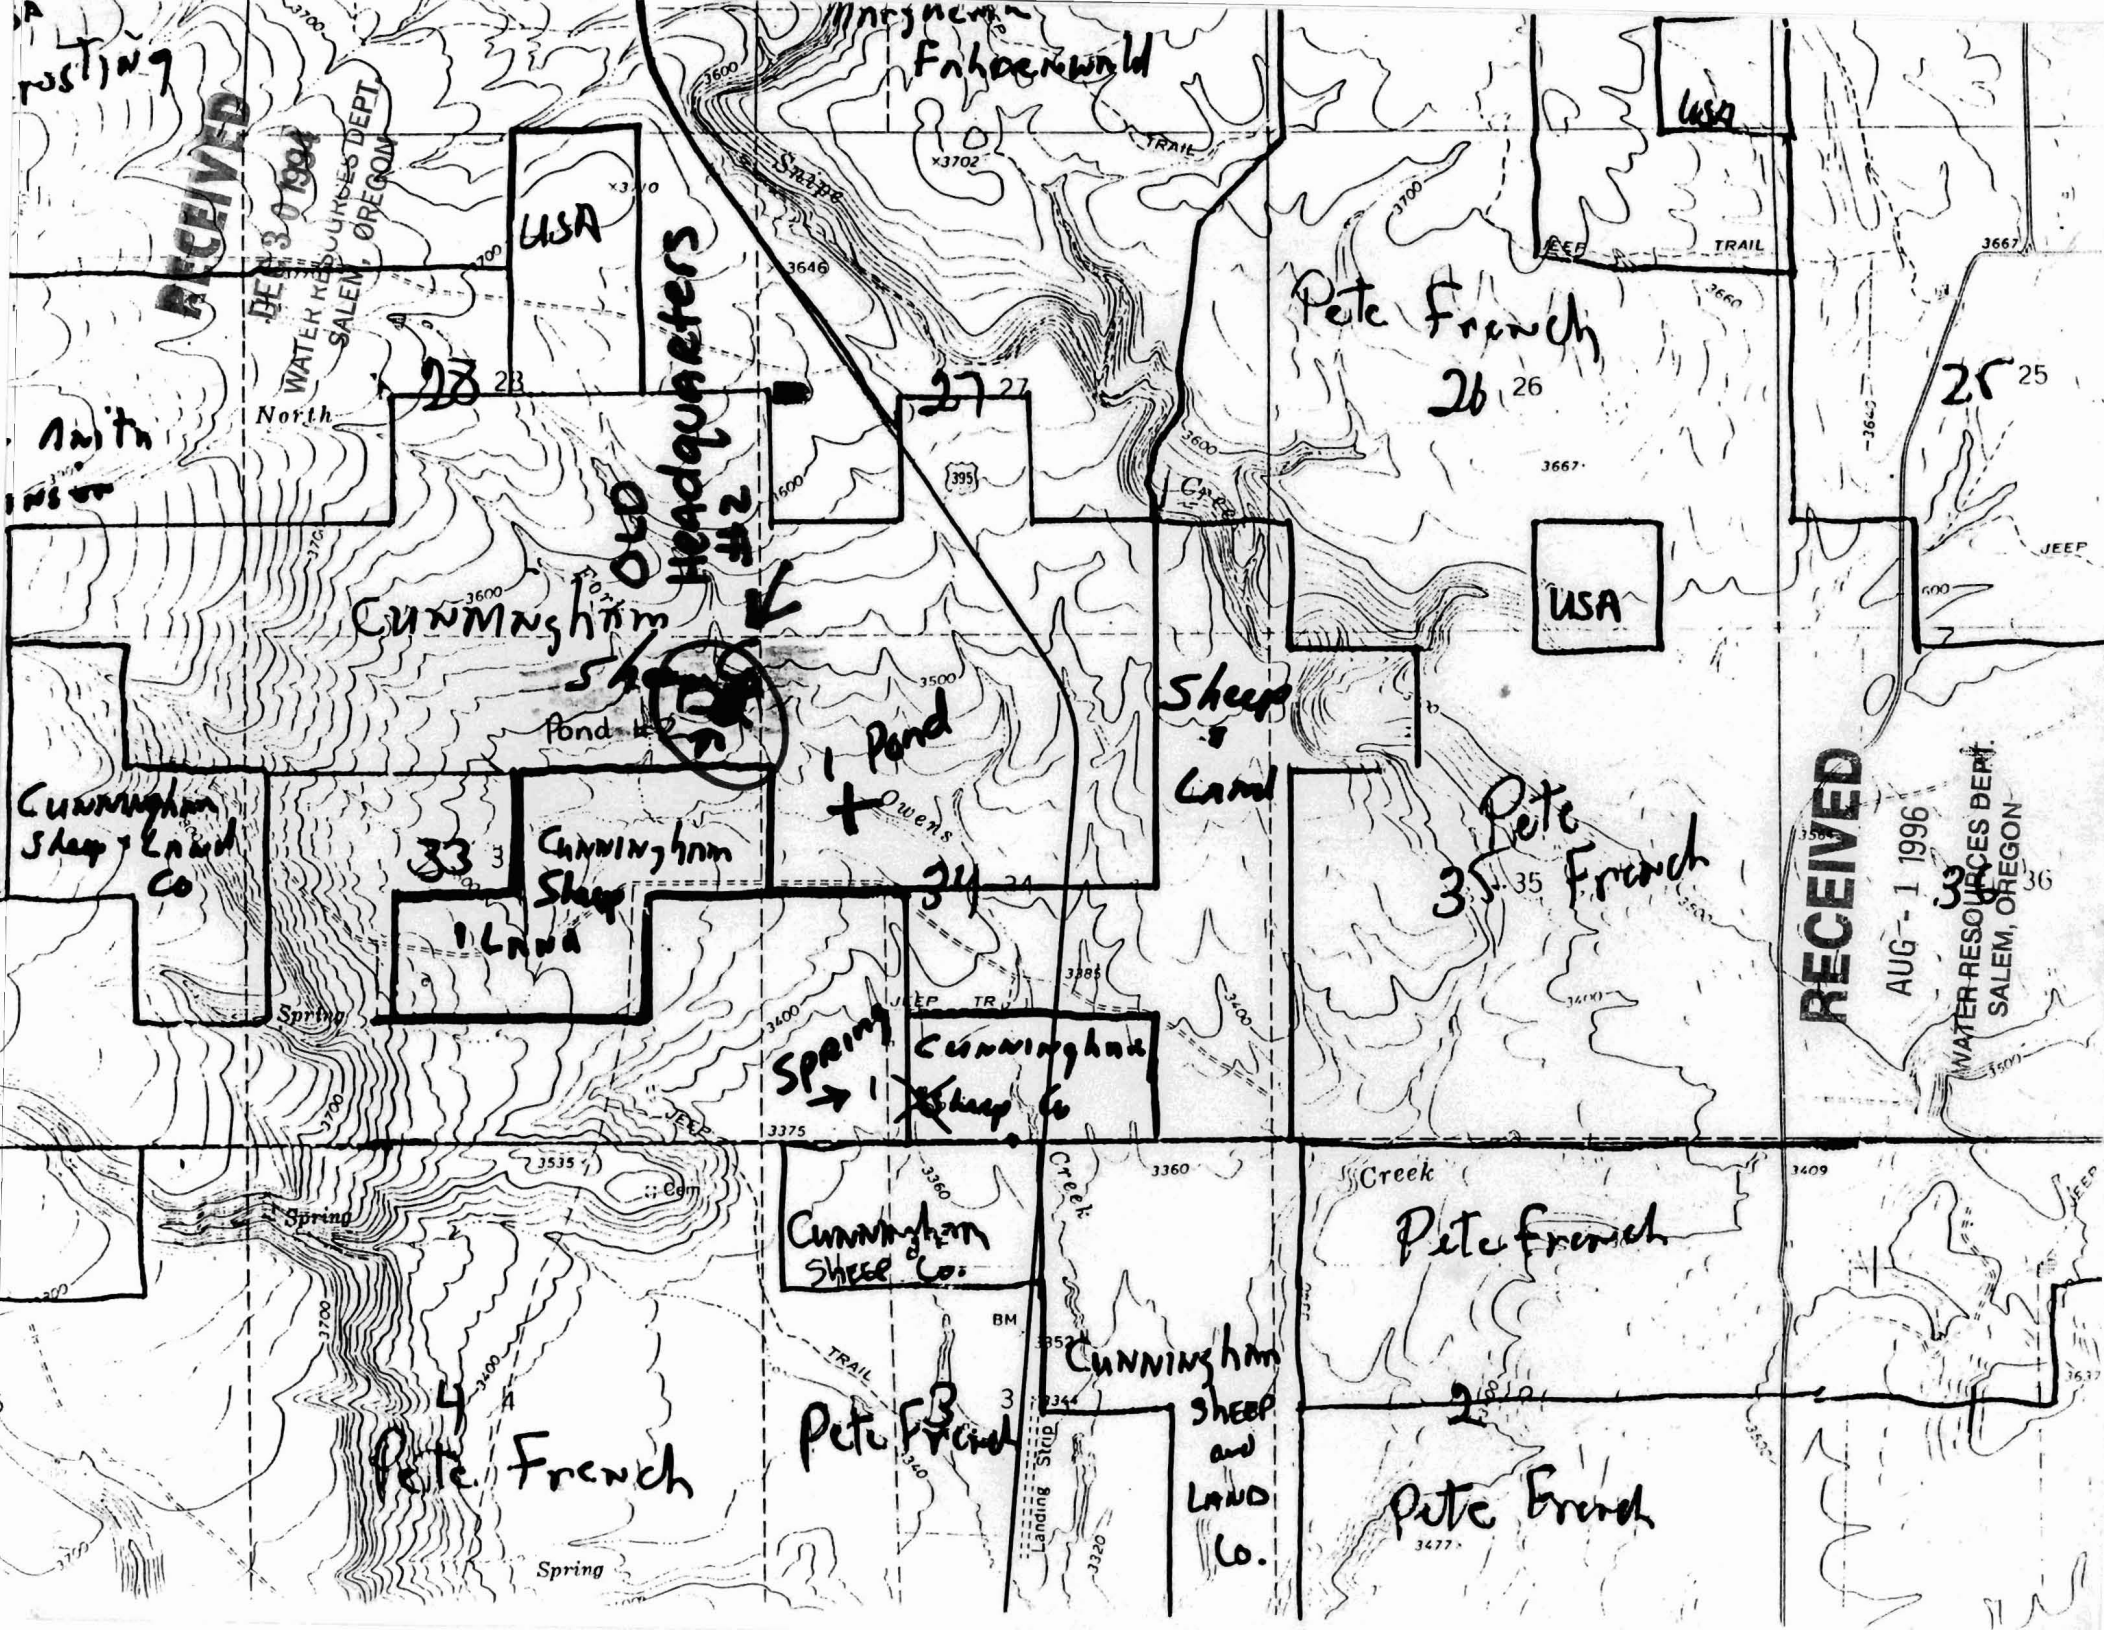

RECEIVED

HEB 30 1994  
WATER RESOURCES DEPT  
SALEM, OREGON

RECEIVED  
AUG - 1 1996  
WATER RESOURCES DEPT  
SALEM, OREGON

resting

Anita

INS OF

North

Mingnewm Finnerwald

USA

USA

JEEP

TRAIL

28 28

27 27

Pete French  
26 26

25 25

Old Headquarters #2

CUNNINGHAM

USA

Sheep Land

Pond  
+ Owens

Pete French  
35 35

Cunningham Sheep Land Co

33 33

CUNNINGHAM  
Sheep Land

34 34

Spring

Spring  
→

Cunningham  
Sheep Co

Cunningham  
SHEEP Co.

Pete French

Pete French  
4

Pete French  
3

CUNNINGHAM  
SHEEP and  
LAND Co.

Pete French  
2

Spring

Landing Strip

36 36

JEEP


JEEP

JEEP

RECEIVED

DEC 30 1994

WATER RESOURCES DEPT.  
SALEM, OREGON

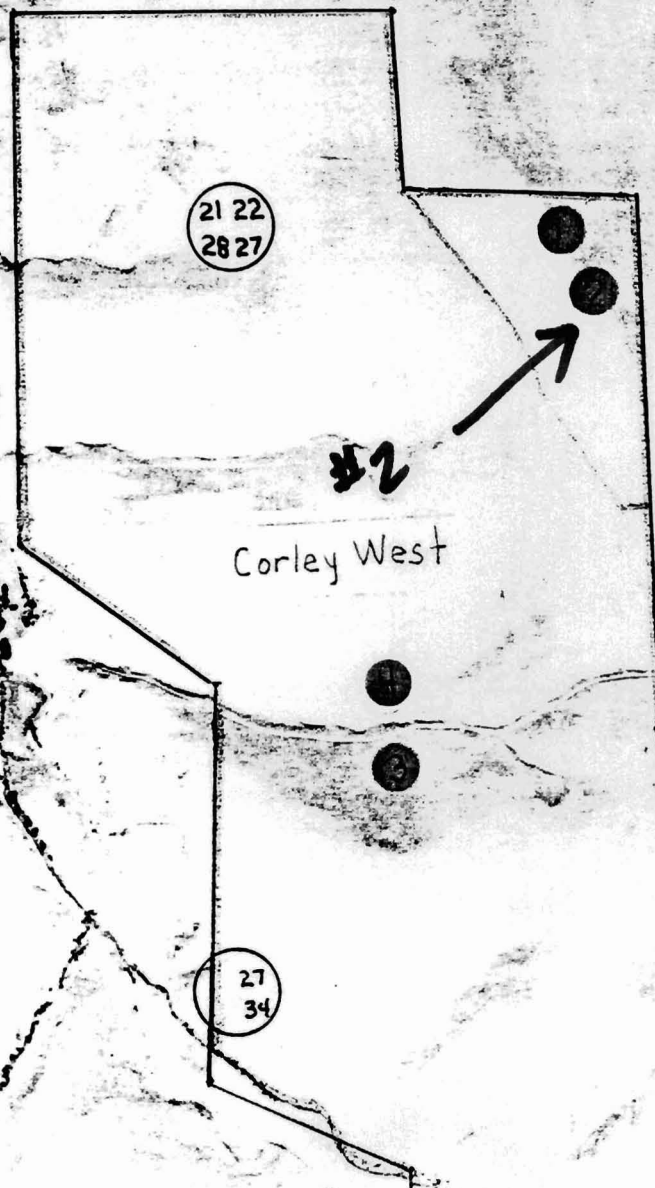

21 22  
28 27


Corley West

27  
34

22 23  
27 26


RECEIVED

AUG - 1 1996

WATER RESOURCES DEPT.  
SALEM, OREGON

Cunningham  
Sheep  
Co.

27 26  
34 35

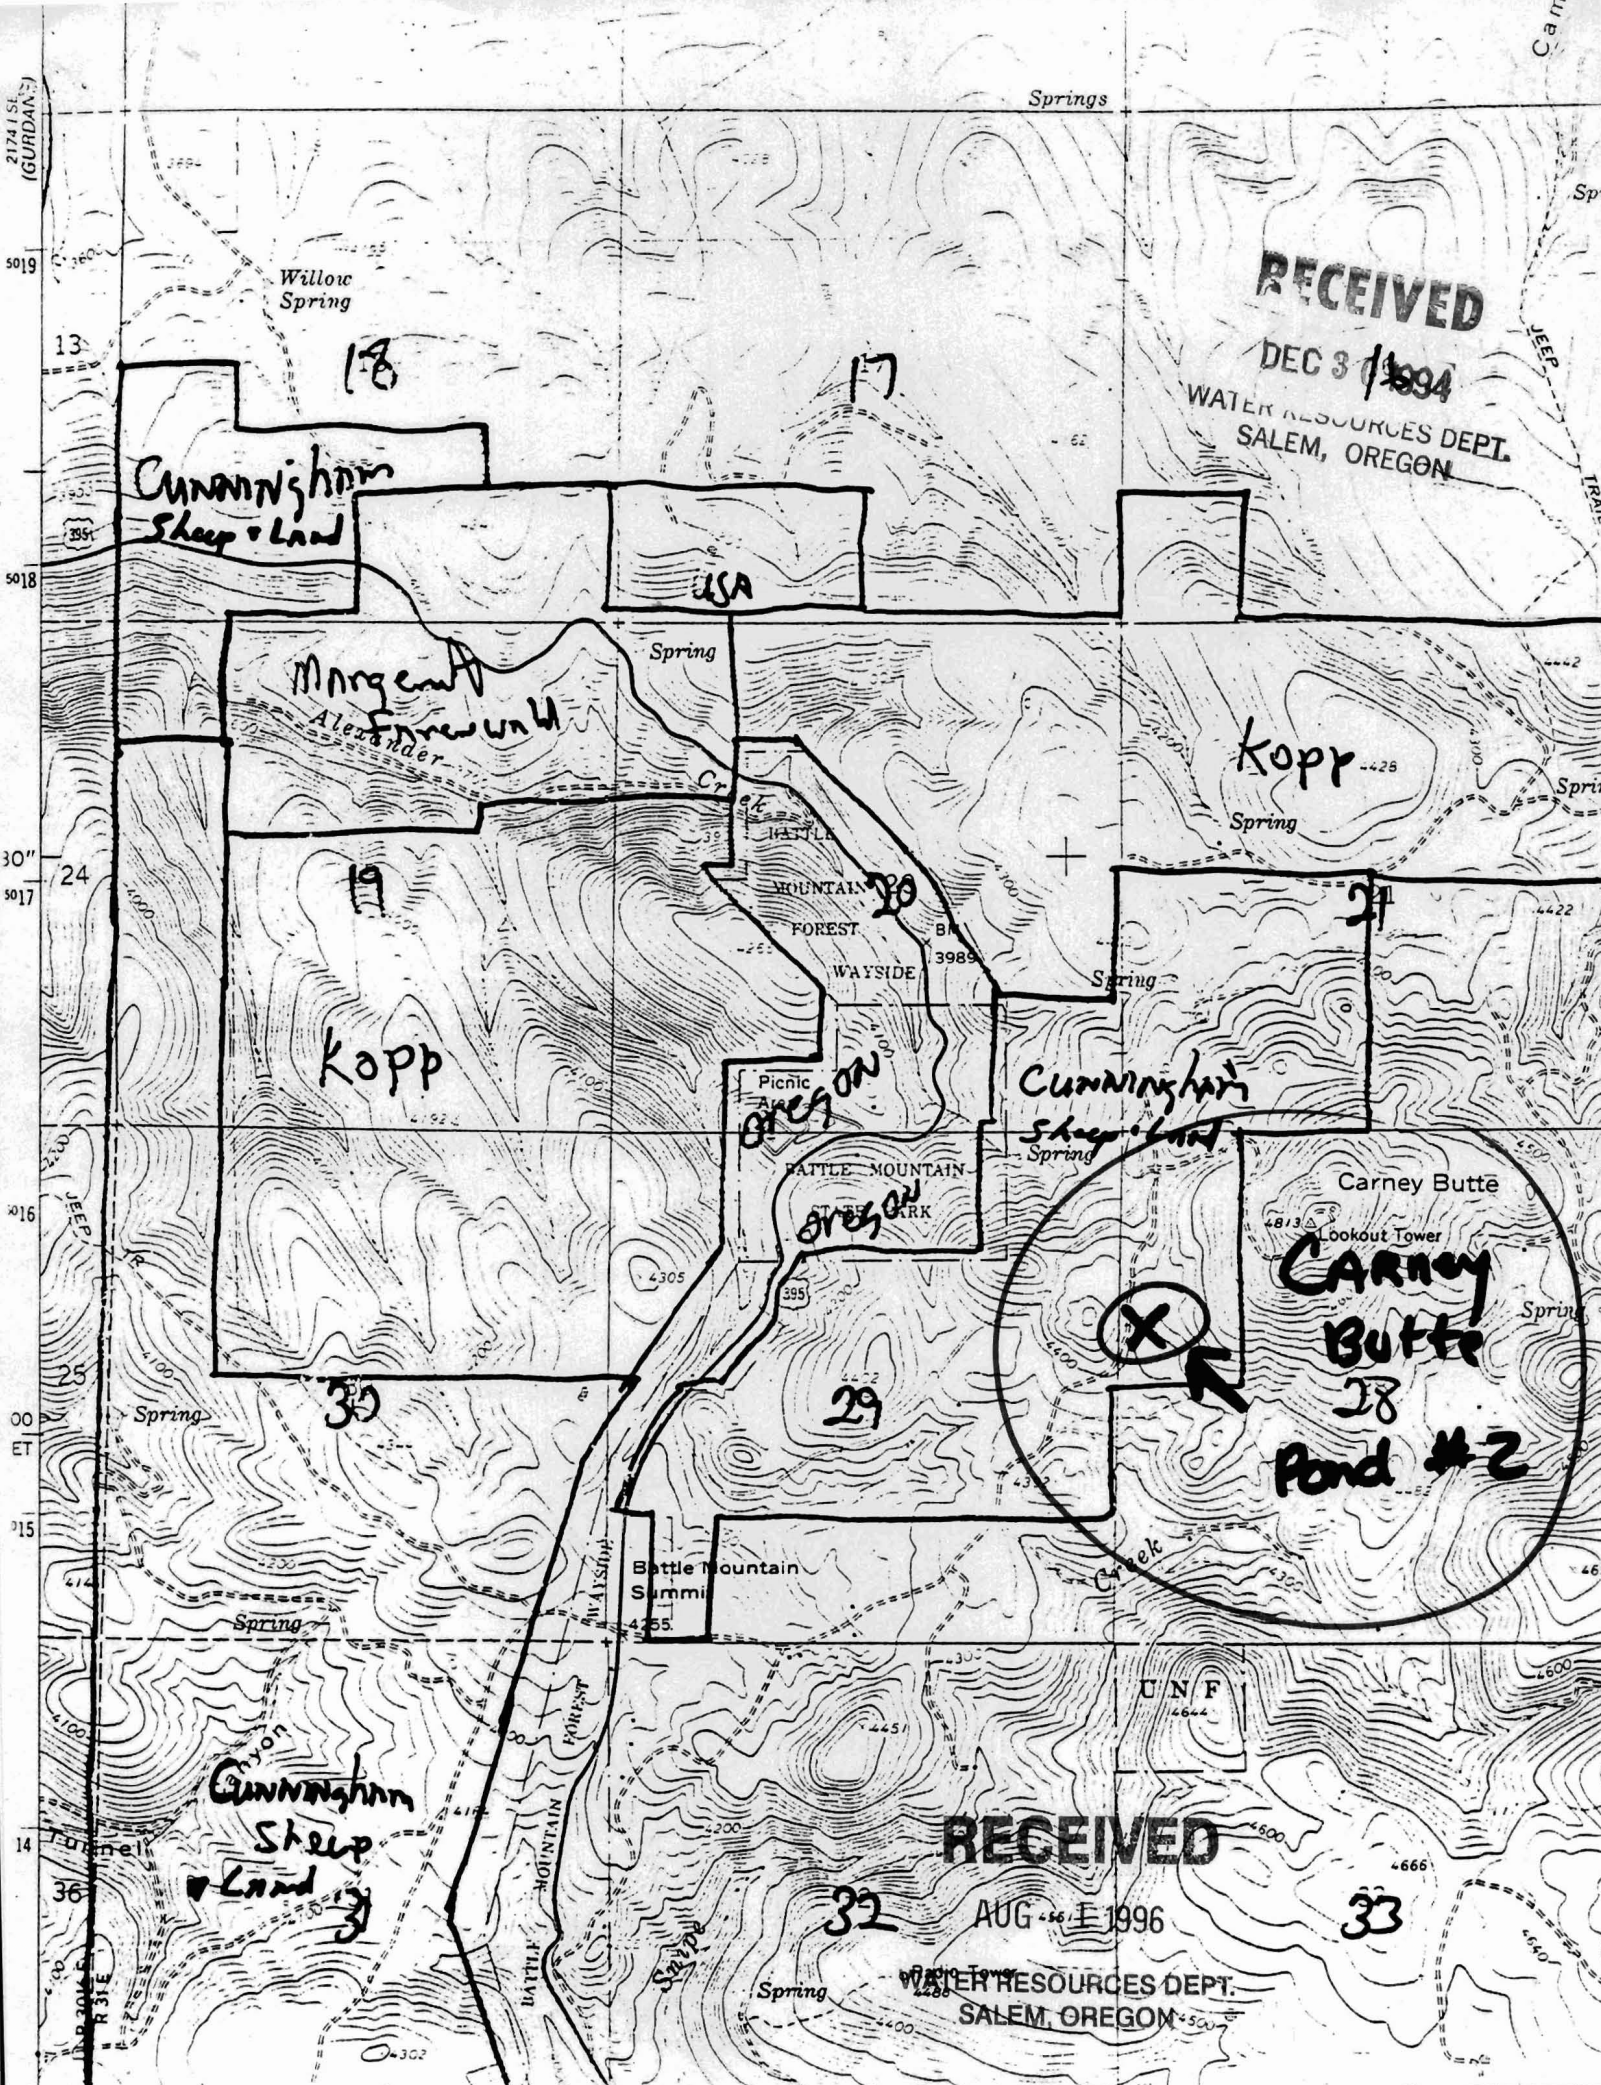

2174 1 ST (GURDAN)

Springs

5019

Willow Spring

RECEIVED

DEC 3 1994

WATER RESOURCES DEPT.  
SALEM, OREGON

13

18

17

Cunningham  
Sheep & Land

USA

5018

Margen A  
Alexander

Spring

Kopp

Spring

30"

5017

24

19

BATTLE MOUNTAIN FOREST

20

21

Kopp

OREGON

Cunningham  
Sheep & Land

Spring

5016

25

30

29

Carney Butte  
Lookout Tower

Carney Butte  
28  
Pond #2

00

ET

5015

Battle Mountain  
Summit  
4255

RECEIVED

AUG 26 1996

WATER RESOURCES DEPT.  
SALEM, OREGON

14

Cunningham  
Sheep & Land

32

33

Spring

RECEIVED

DEC 30 1994

WATER RESOURCES DEPT.  
SALEM, OREGON

21 22  
28 27

22 23  
27 26

Corley West

#3



27  
34

RECEIVED

AUG - 1 1996

WATER RESOURCES DEPT.  
SALEM, OREGON


Cunningham  
Sheep  
Co.

27 26  
34 35

RECEIVED

DEC 30 1994

WATER RESOURCES DEPT.  
SALEM, OREGON

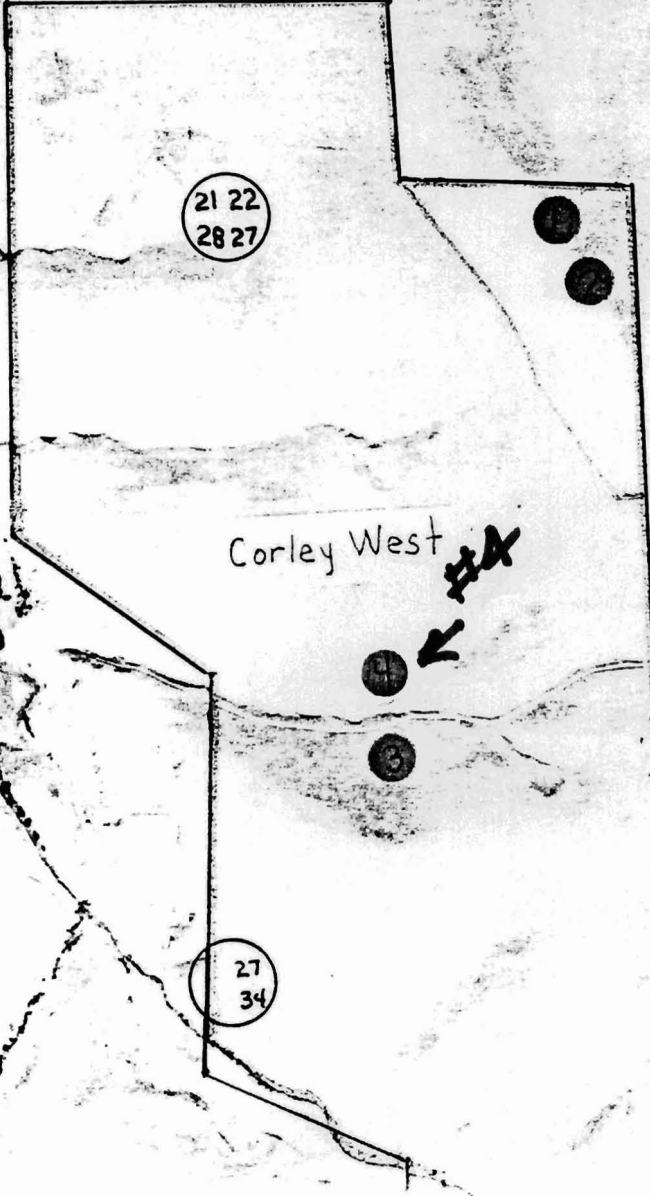

21 22  
28 27

22 23  
27 26

Corley West

RECEIVED

AUG - 1 1996

WATER RESOURCES DEPT.  
SALEM, OREGON

27  
34

Cunningham  
Sheep  
Co.

27 26  
34 35