

RECEIVED

DEC 30 1994

WATER RESOURCES DEPT.
SALEM, OREGON

18 17
19 20

17
20

ALAKALI
MIDDLE
#2

20 21
29 30

BECKNER

Beckner EAST

RECEIVED

AUG - 1 1996

WATER RESOURCES DEPT.
SALEM, OREGON

RECEIVED

DEC 30 1994

WATER RESOURCES DEPT.
SALEM, OREGON

18 17
19 20

17
20

ALAKALI
MIDDLE
#3

26 21
29 20

BECKNER

Beckner East

RECEIVED

AUG - 1 1996

WATER RESOURCES DEPT.
SALEM, OREGON

RECEIVED

DEC 30 1994

WATER RESOURCES DEPT.
SALEM, OREGON

18 17
19 20

17
20

ALKALI
MIDDLE
4

26 21
29 27


PENDLETON

Beckner EAST

RECEIVED

AUG - 1 1996

WATER RESOURCES DEPT.
SALEM, OREGON

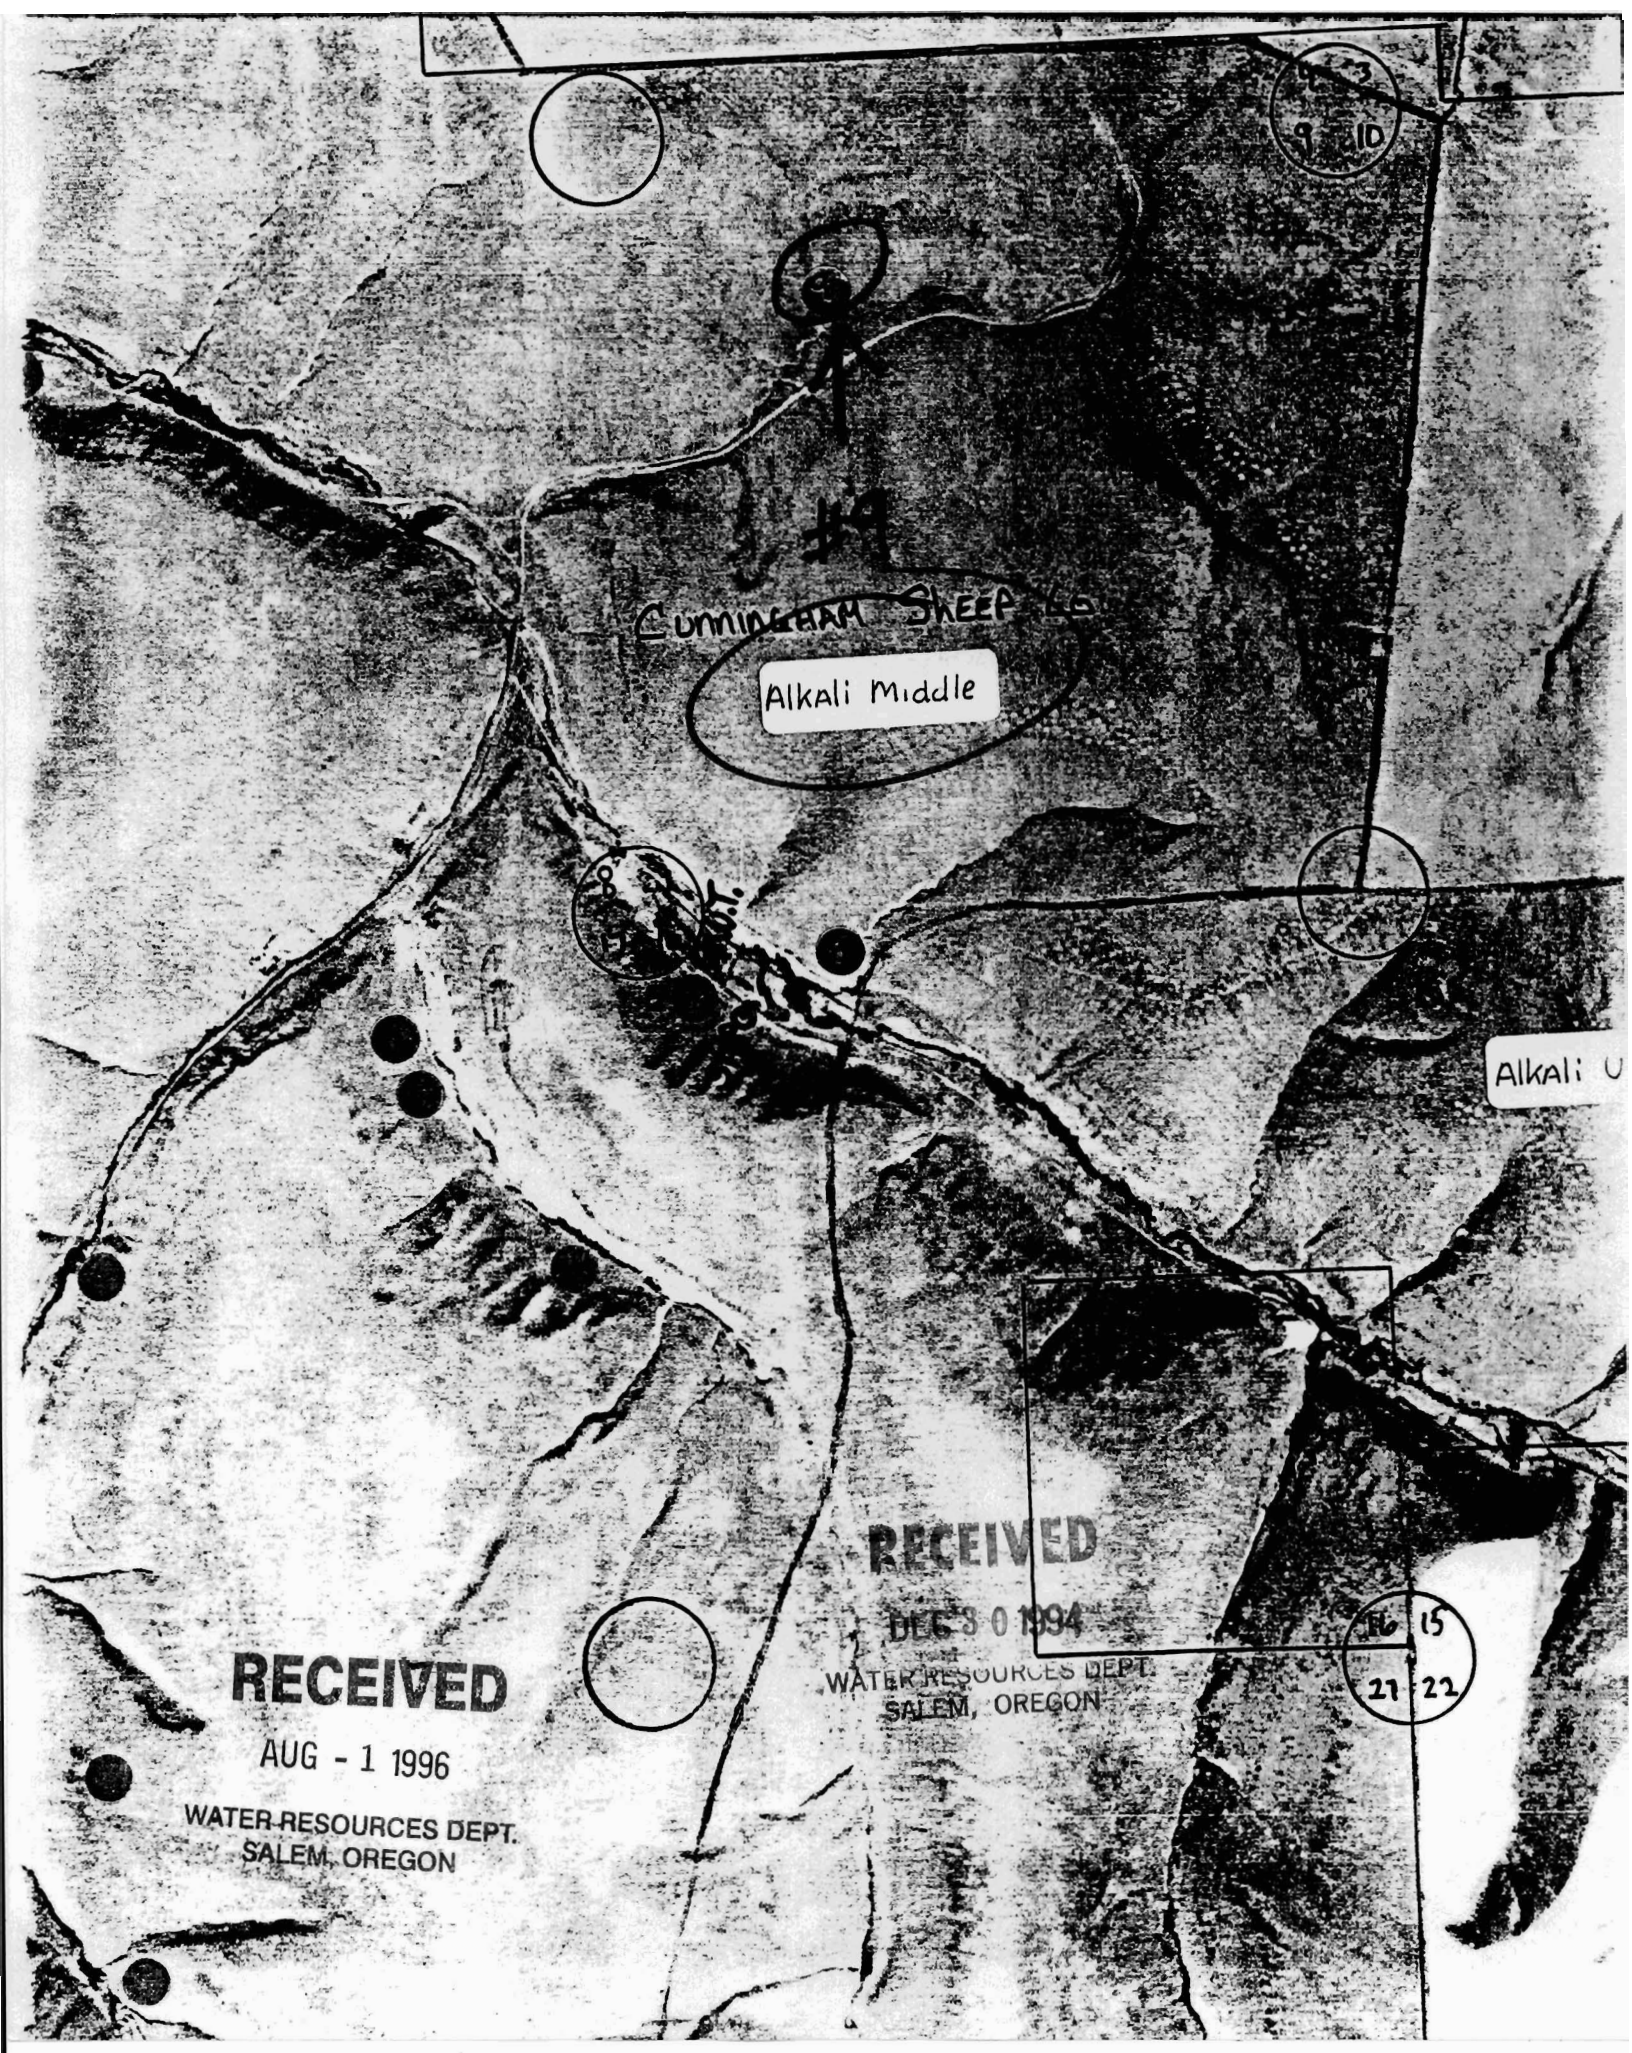

Alkali Middle

Alkali U

RECEIVED

DEC 30 1994

WATER RESOURCES DEPT
SALEM, OREGON

RECEIVED

AUG - 1 1996

WATER RESOURCES DEPT.
SALEM, OREGON

9 210

16 15
21 22

CUMMINS RIVER SHEEP LE

#9

RECEIVED

DEC 30 1994

WATER RESOURCES DEPT.
SALEM, OREGON

Cunningham Sheep Co.
Alkali middle

12 7
13 18

18 17
19 20

DALLAS (EAST) # 10

RECEIVED

AUG - 1 1996

WATER RESOURCES DEPT.
SALEM, OREGON

24 19
25 30

Beckner West

1

