

**RECEIVED**

DEC 30 1994

WATER RESOURCES DEPT.  
SALEM, OREGON

**RECEIVED**

AUG - 1 1996

WATER RESOURCES DEPT.  
SALEM, OREGON

Hollow

Spring

Creek

Ely

Creek

Buckhorn

**Egg Barns #15**

Gurdane Cem

Gurdane

Grave

Springs

14

15

12

11

5

6

8

9

17

10

16

20

21

22

29

28

27

32

33

Borrow Pit

Cares

396

399

378

3755

3855

3625

3810

3990

3821

4043

3700

3733

3666

3845

3985

3895

3965

3903

3565

3585

3727

3931

4128

3335

3559

3725

4001

4005

3999

3690

3700

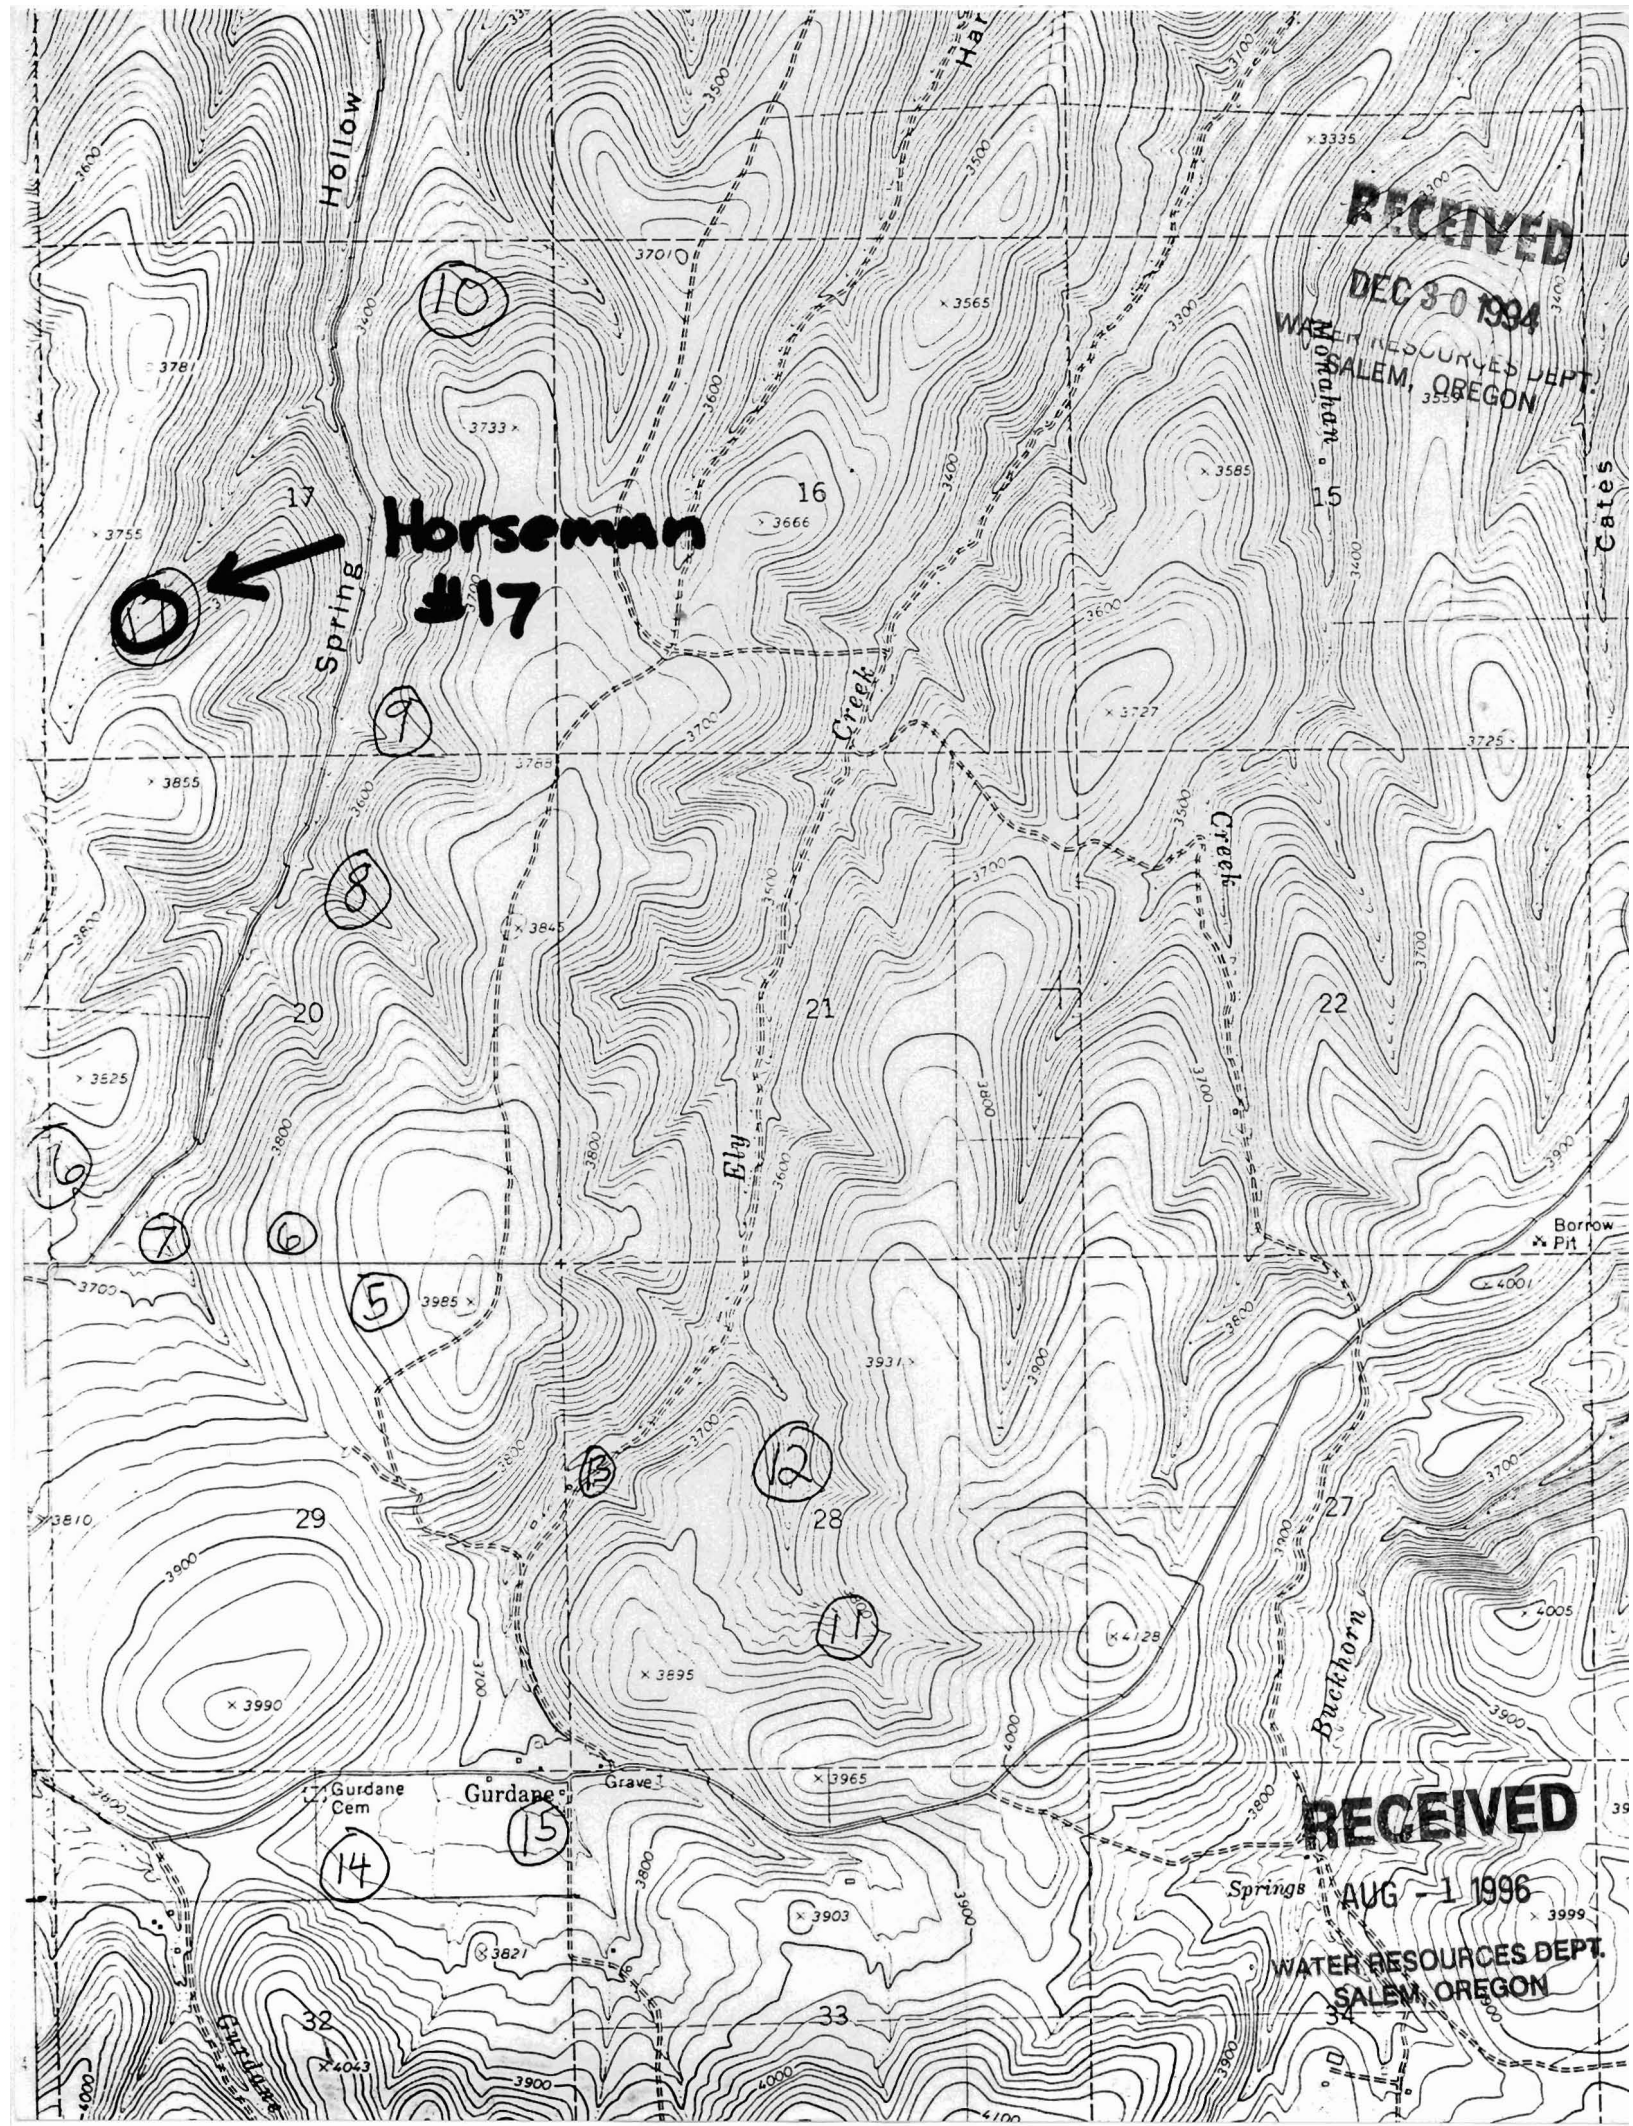

RECEIVED

DEC 30 1994

WATER RESOURCES DEPT.  
SALEM, OREGON

Horseman  
17

0

10  
17  
18  
19  
20  
21  
22  
23  
24  
25  
26  
27  
28  
29  
30  
31  
32  
33

Hollow  
Spring

Ely  
Creek

Creek

Buckhorn

Gurdane  
Cem

Gurdane

Grave 1

Springs


RECEIVED

AUG -1 1996

WATER RESOURCES DEPT.  
SALEM, OREGON

Cates

Borrow  
Pit

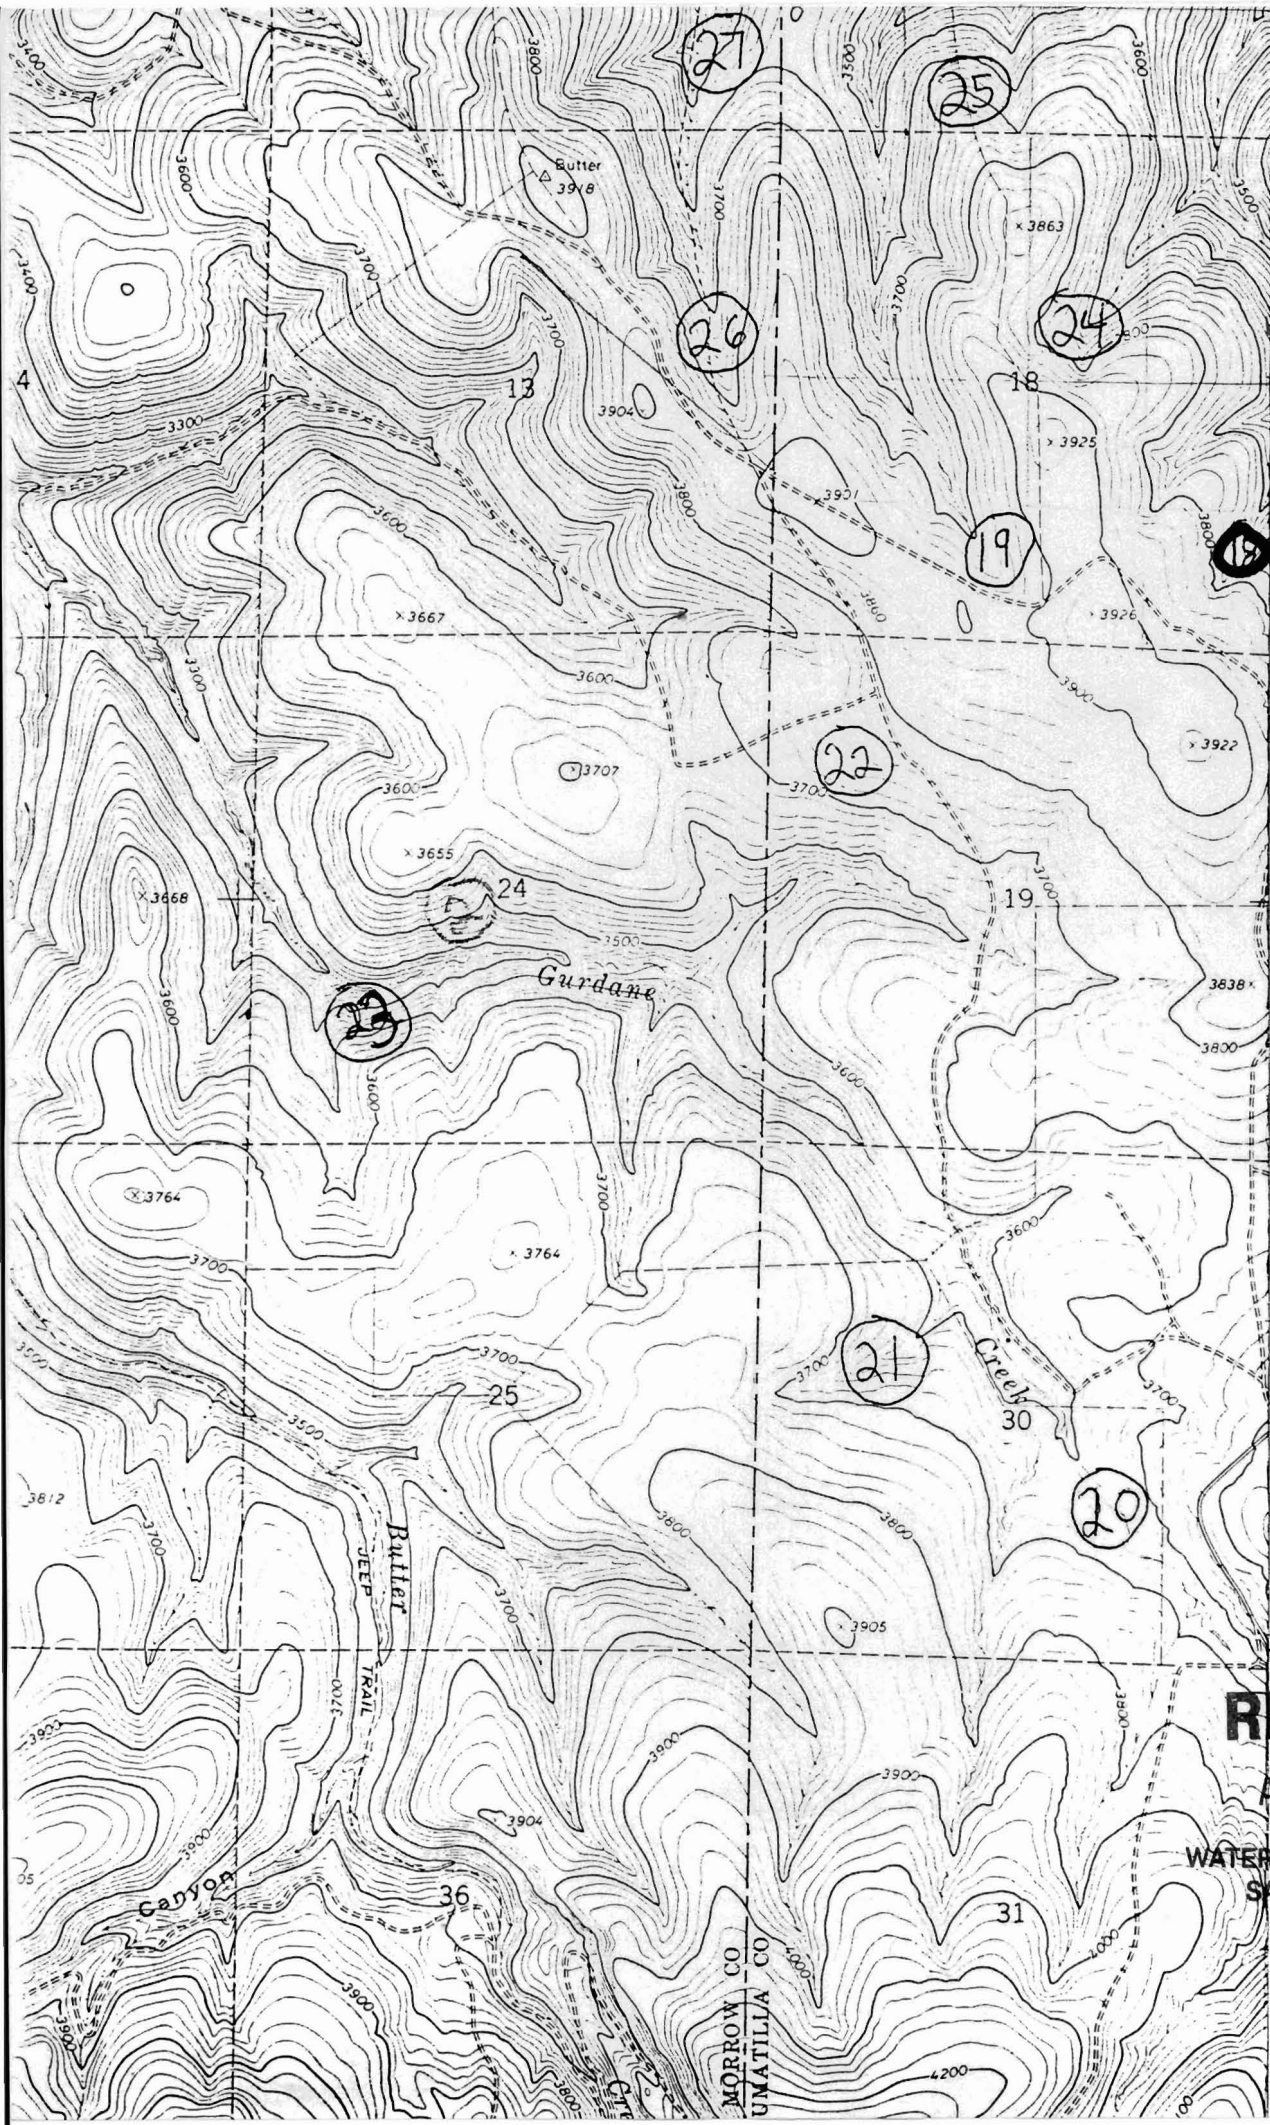

5020  
(GURDANE) 2174 I SE  
5019  
5018  
17'30"  
5017  
5016  
5015  
5014

**RECEIVED**

DEC 30 1994

WATER RESOURCES DEPT.  
SALEM, OREGON




**Horseman  
# 18**

**RECEIVED**

AUG - 1 1996

WATER RESOURCES DEPT.  
SALEM, OREGON



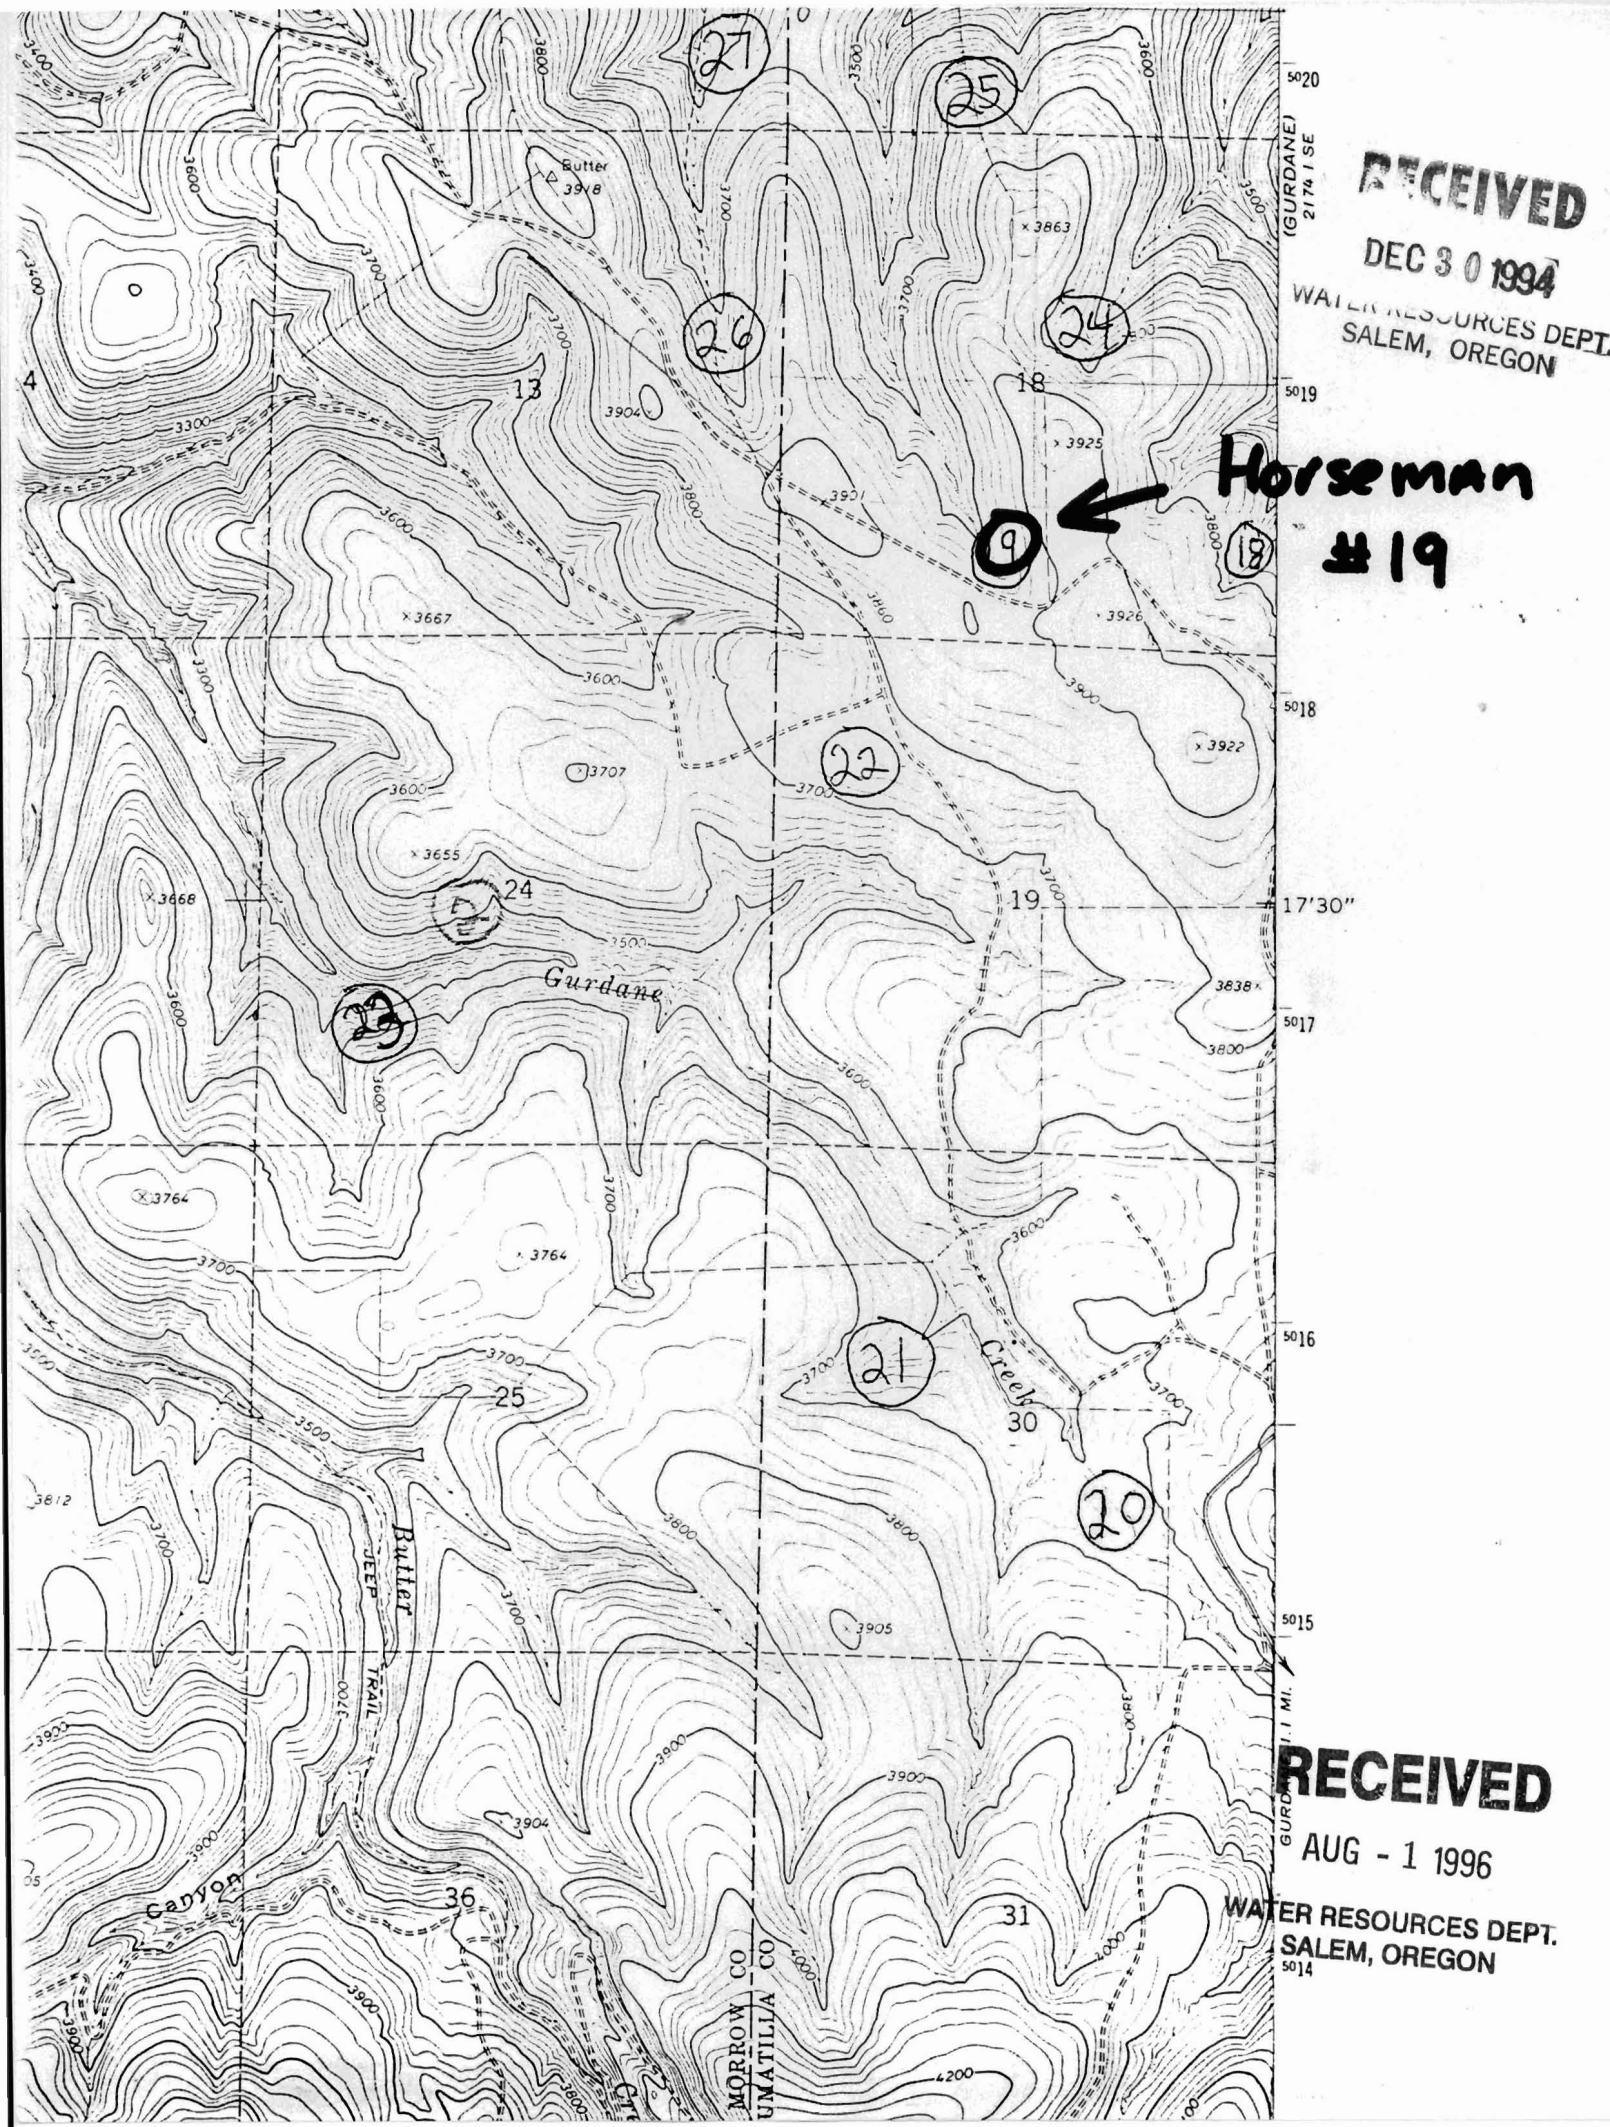

RECEIVED

DEC 30 1994

WATER RESOURCES DEPT.  
SALEM, OREGON

**Horseman  
#19**

5020  
5019  
5018  
5017  
5016  
5015  
5014

RECEIVED

AUG - 1 1996

WATER RESOURCES DEPT.  
SALEM, OREGON

27

25

26

24

9

18

22

24

23

19

21

20

25

36

31

Gurdane


Creek

Butler  
DEEP  
TRAIL


Canyon

MORROW CO  
UMATILLA CO

1.1 MI.

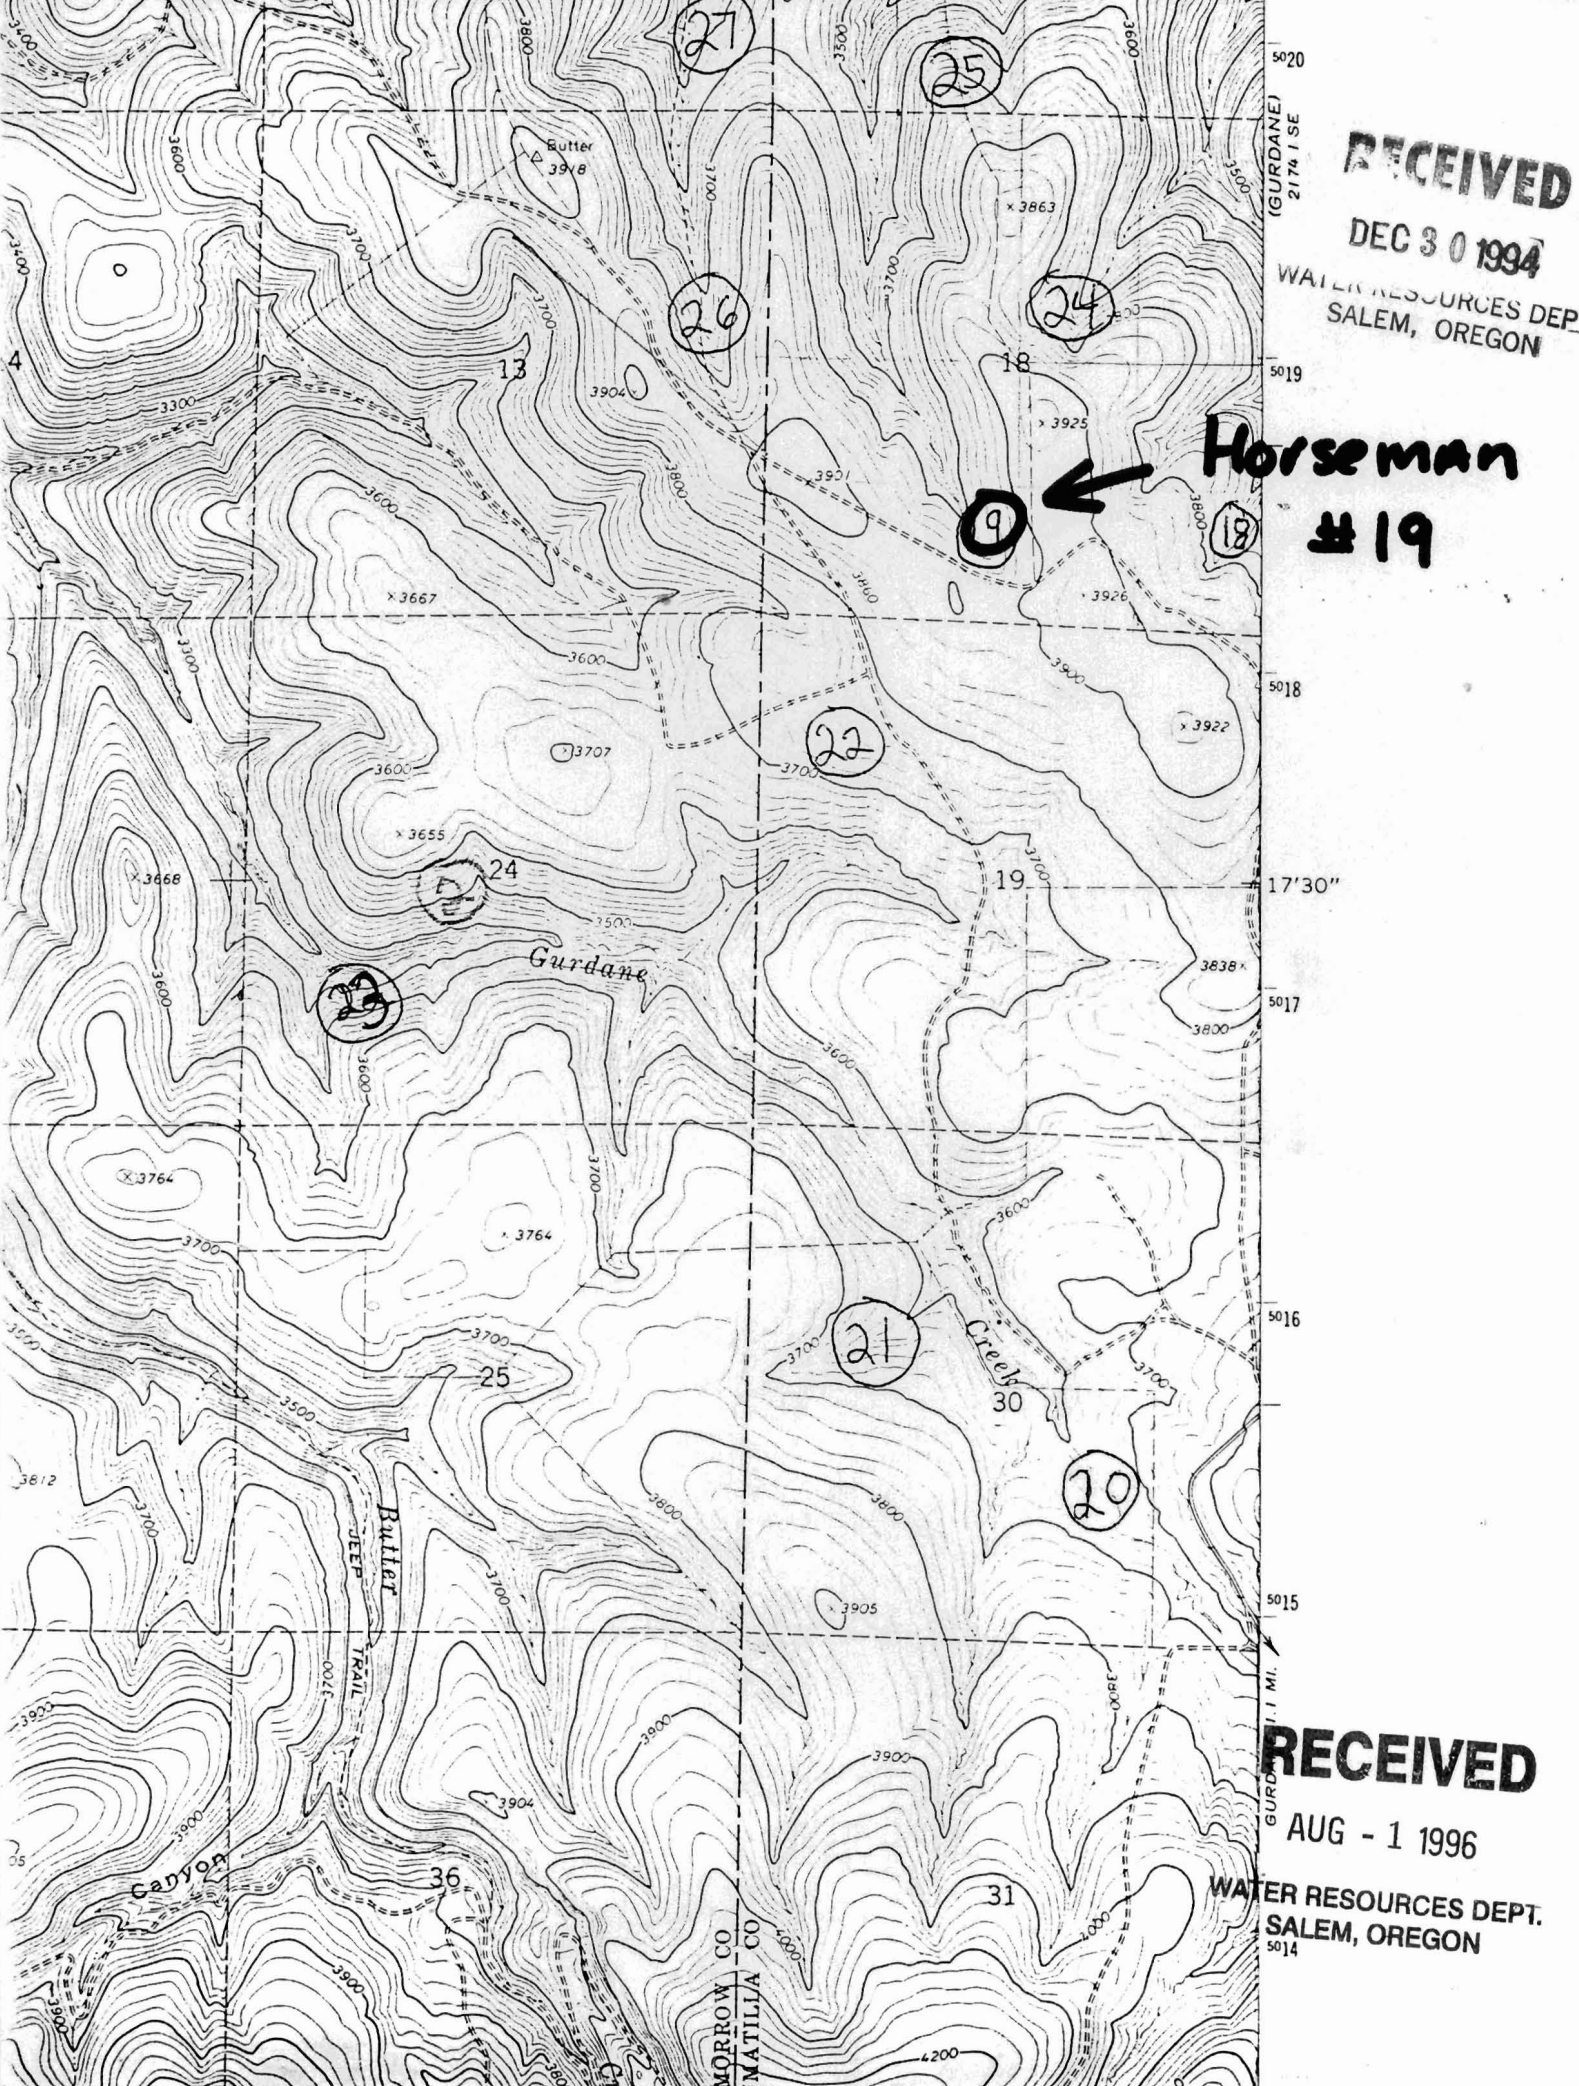



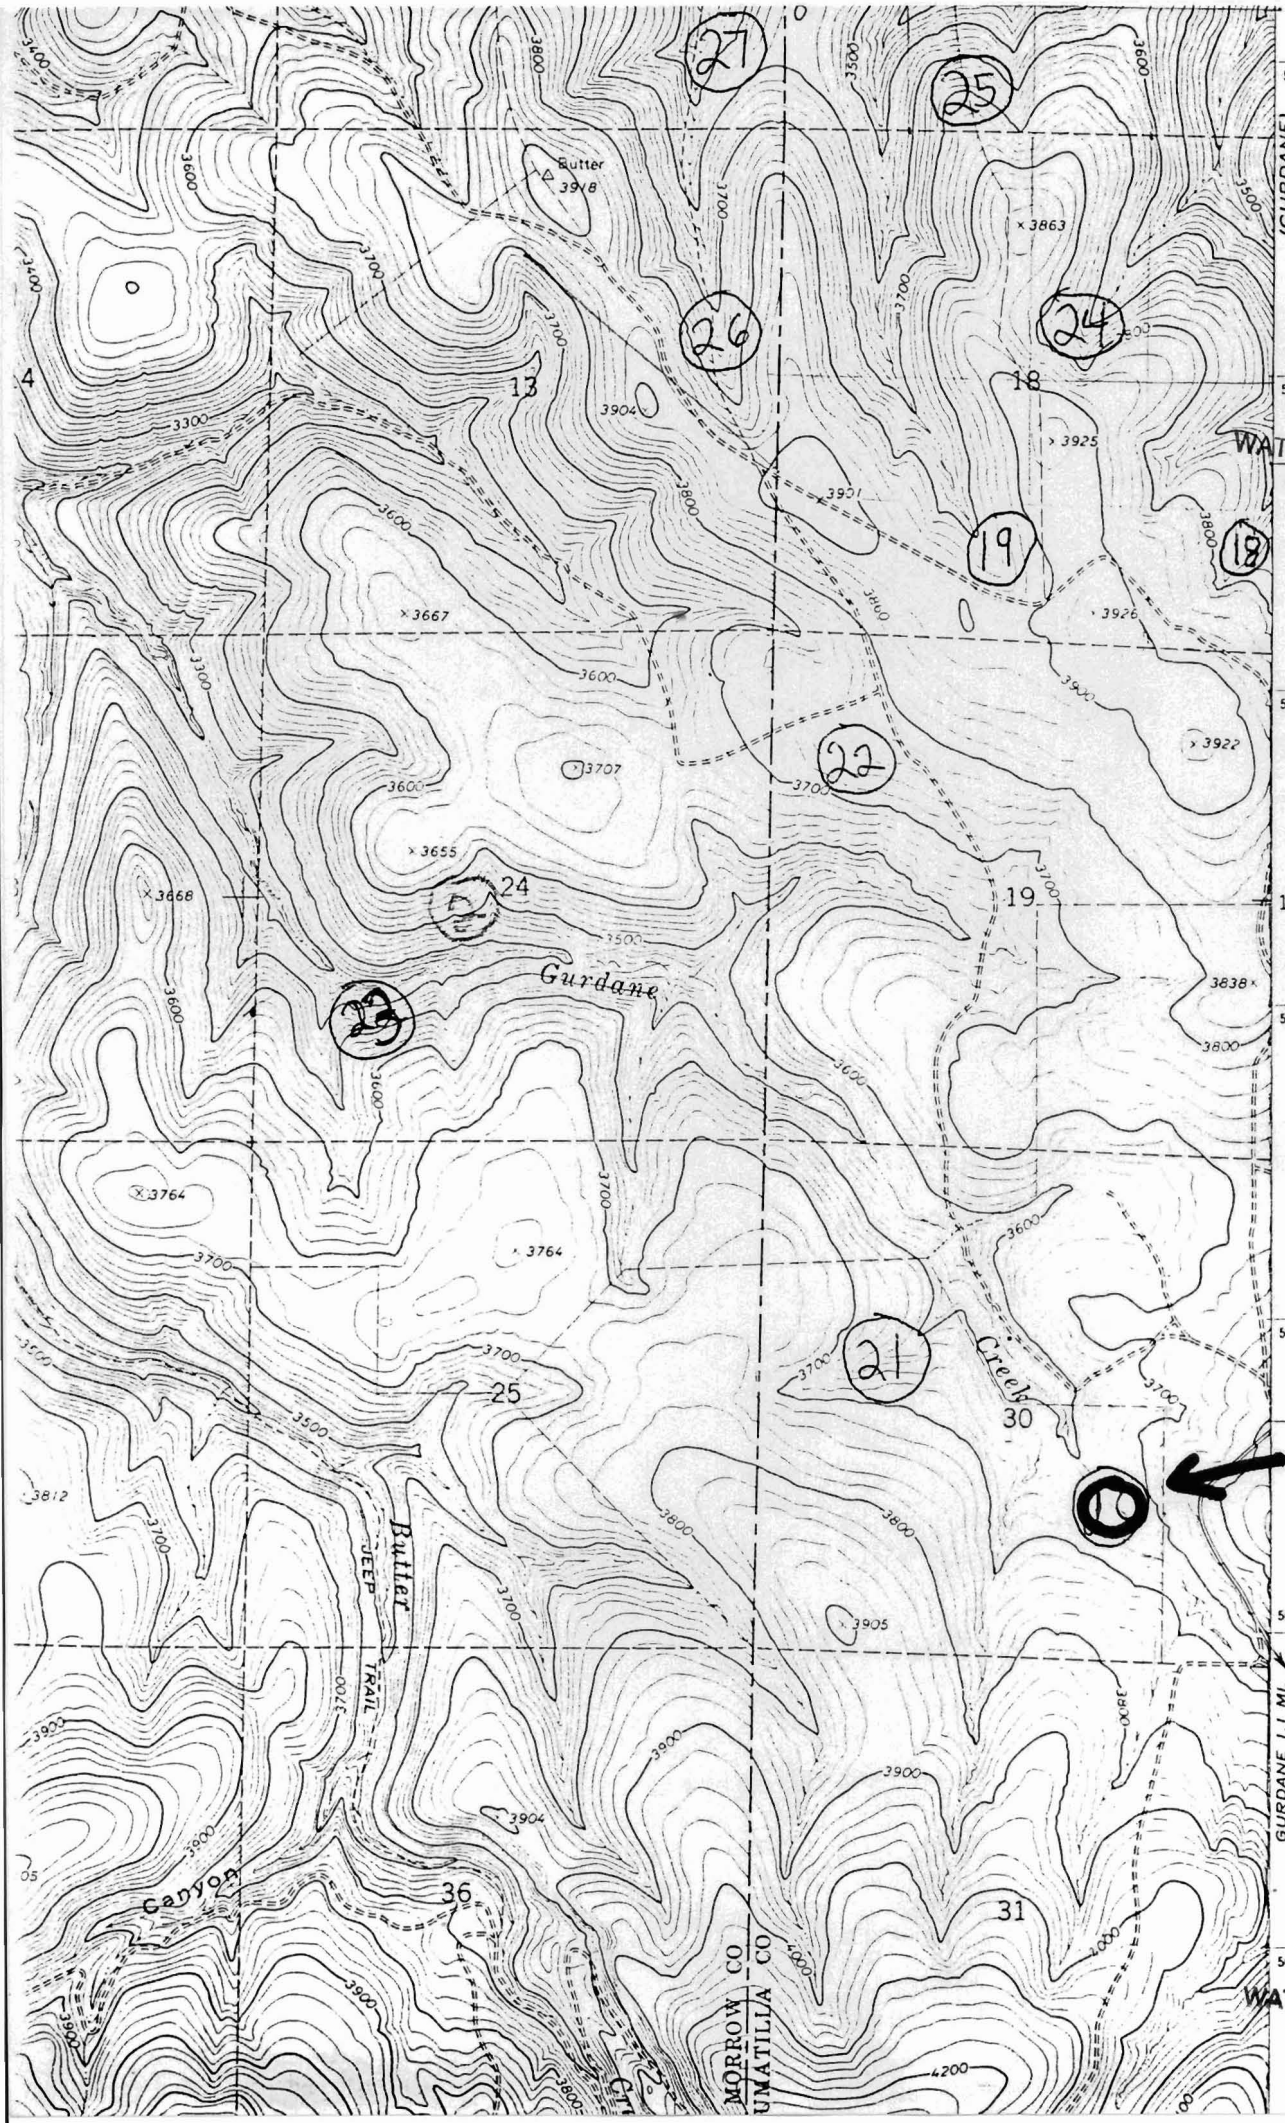

5020  
2174 1 SE  
5018  
17'30"  
5017  
5016  
5015  
5014  
GURDANE 1.1 MI.

**RECEIVED**

**DEC 30 1994**

WATER RESOURCES DEPT.  
SALEM, OREGON

**RECEIVED**

**AUG - 1 1996**

WATER RESOURCES DEPT.  
SALEM, OREGON


**Horseman #20**









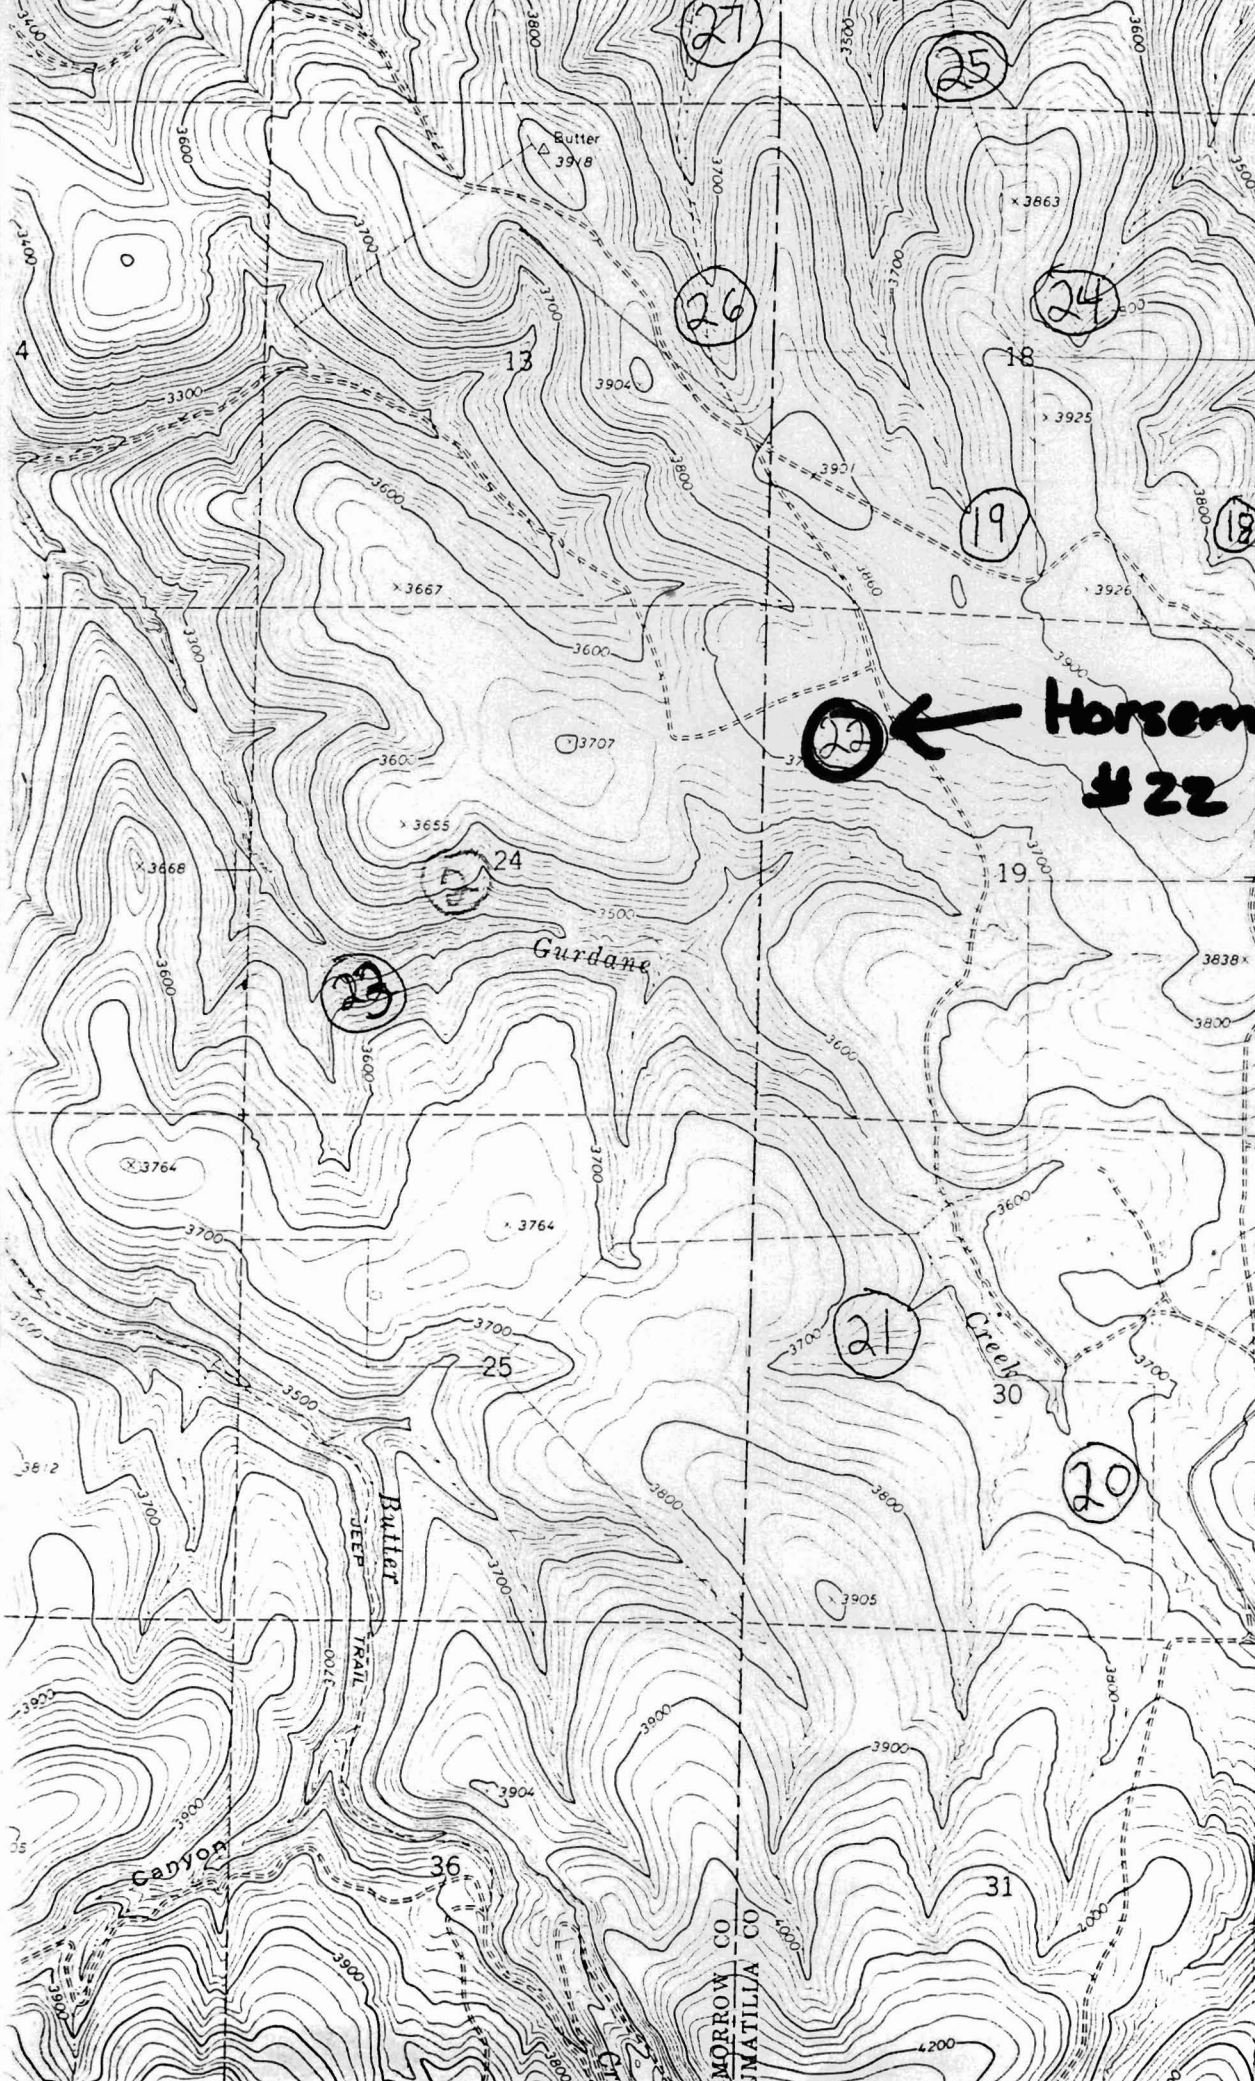

**RECEIVED**

DEC 30 1994

WATER RESOURCES DEPT.  
SALEM, OREGON

**Horseman  
#22**


**RECEIVED**

AUG - 1 1996

WATER RESOURCES DEPT.  
SALEM, OREGON

5020  
5019  
5018  
17'30"  
5017  
5016  
5015  
5014  
GURDANE 1.1 MI.

MORROW CO  
UMATILLA CO

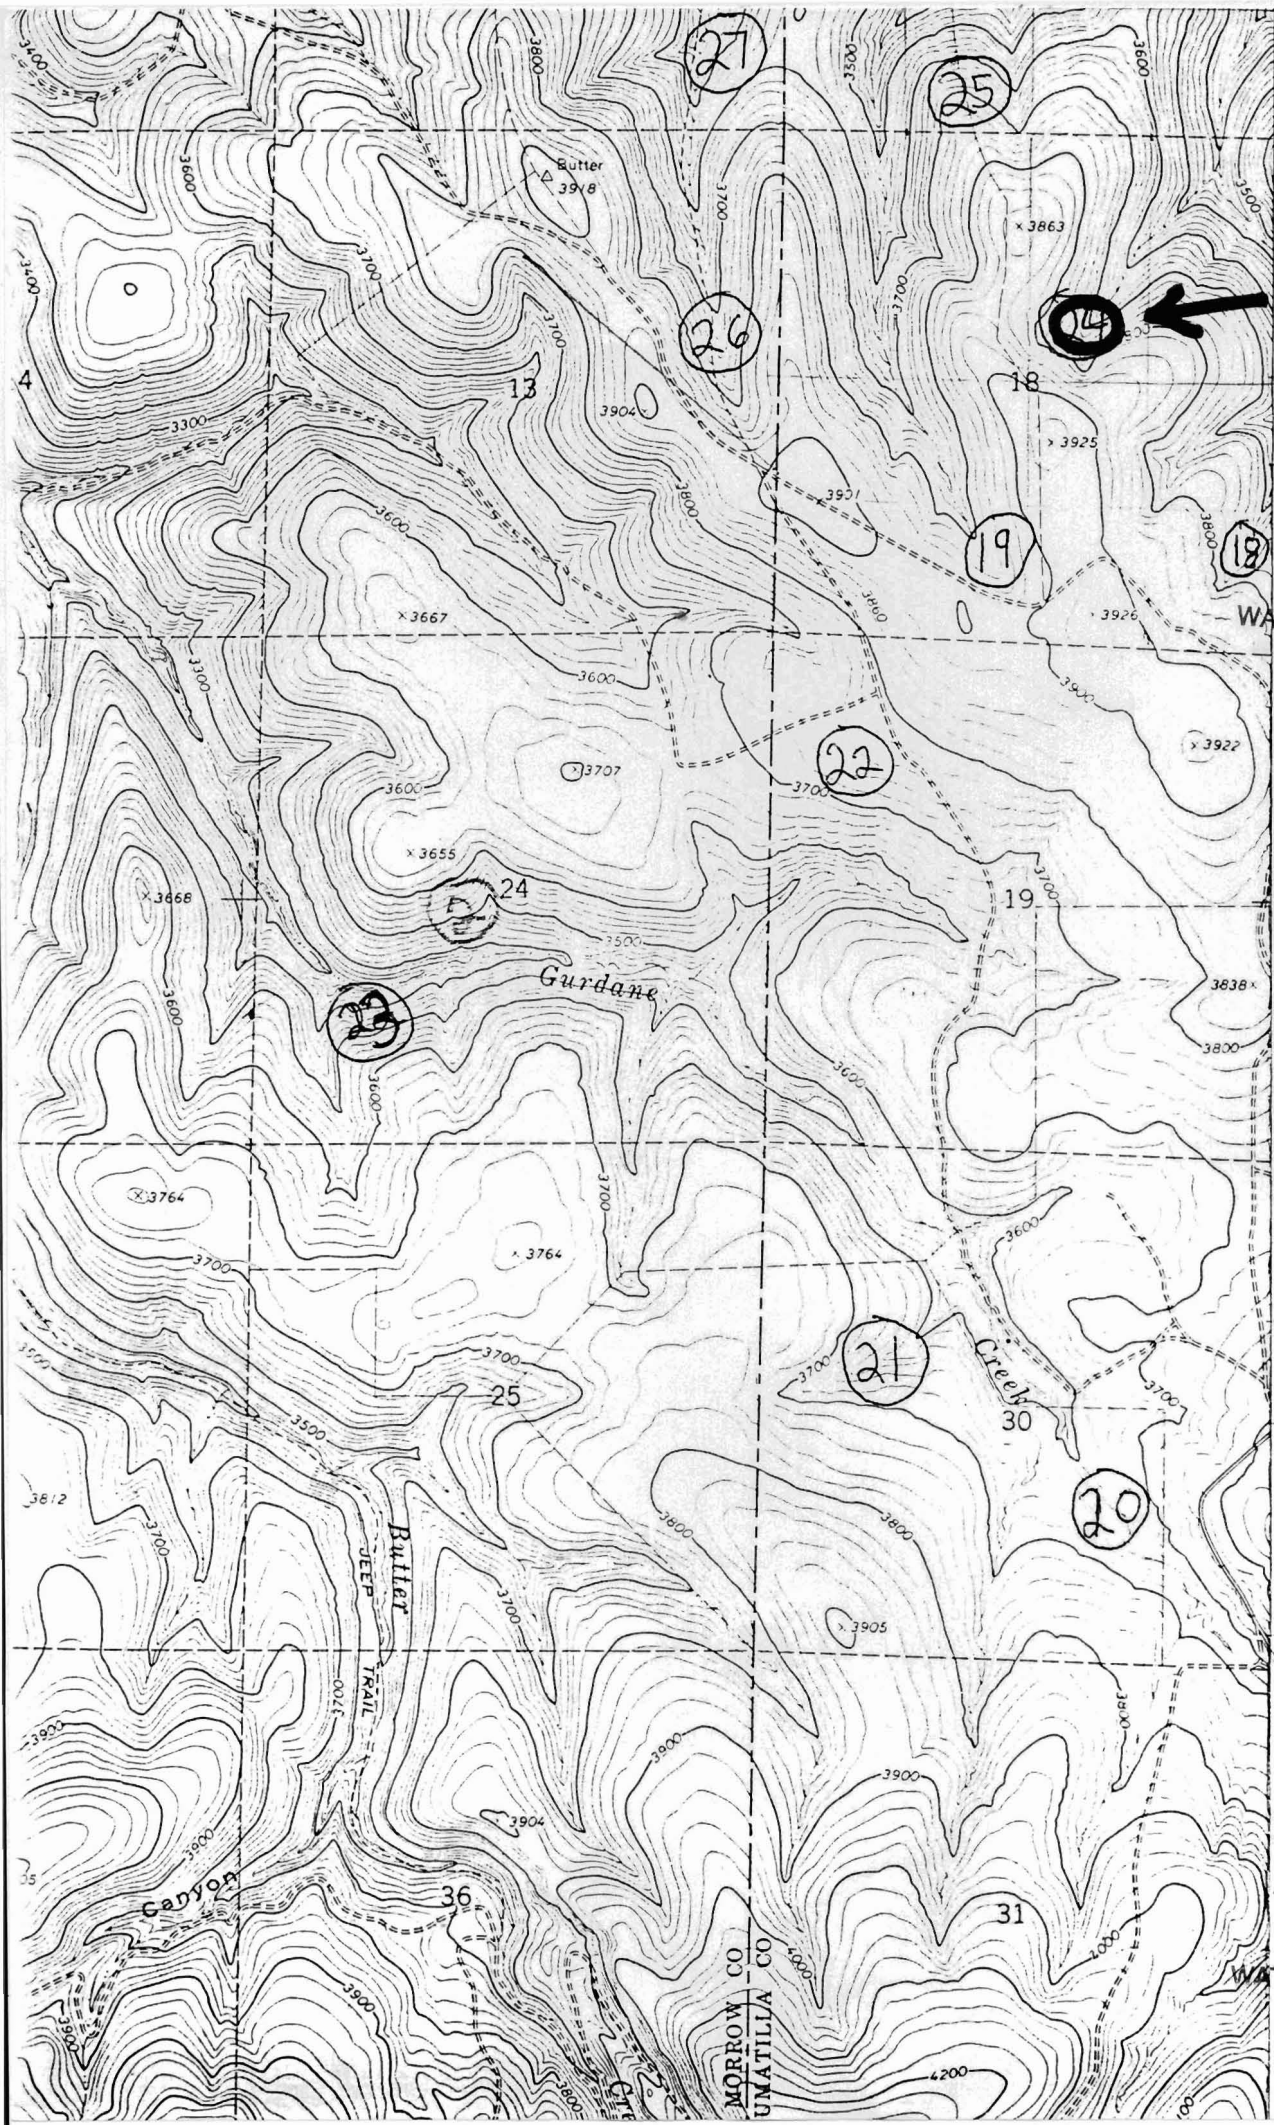

5020  
(GURDANE) 2174 I SE  
5019  
5018  
17'30"  
5017  
5016  
5015  
GURDANE 1.1 MI.

**Sheepcamp  
#24**

**RECEIVED**

**DEC 30 1994**

WATER RESOURCES DEPT.  
**SALEM, OREGON**


**RECEIVED**

**AUG - 1 1996**

WATER RESOURCES DEPT.  
**SALEM, OREGON**

MORROW CO  
UMATILLA CO



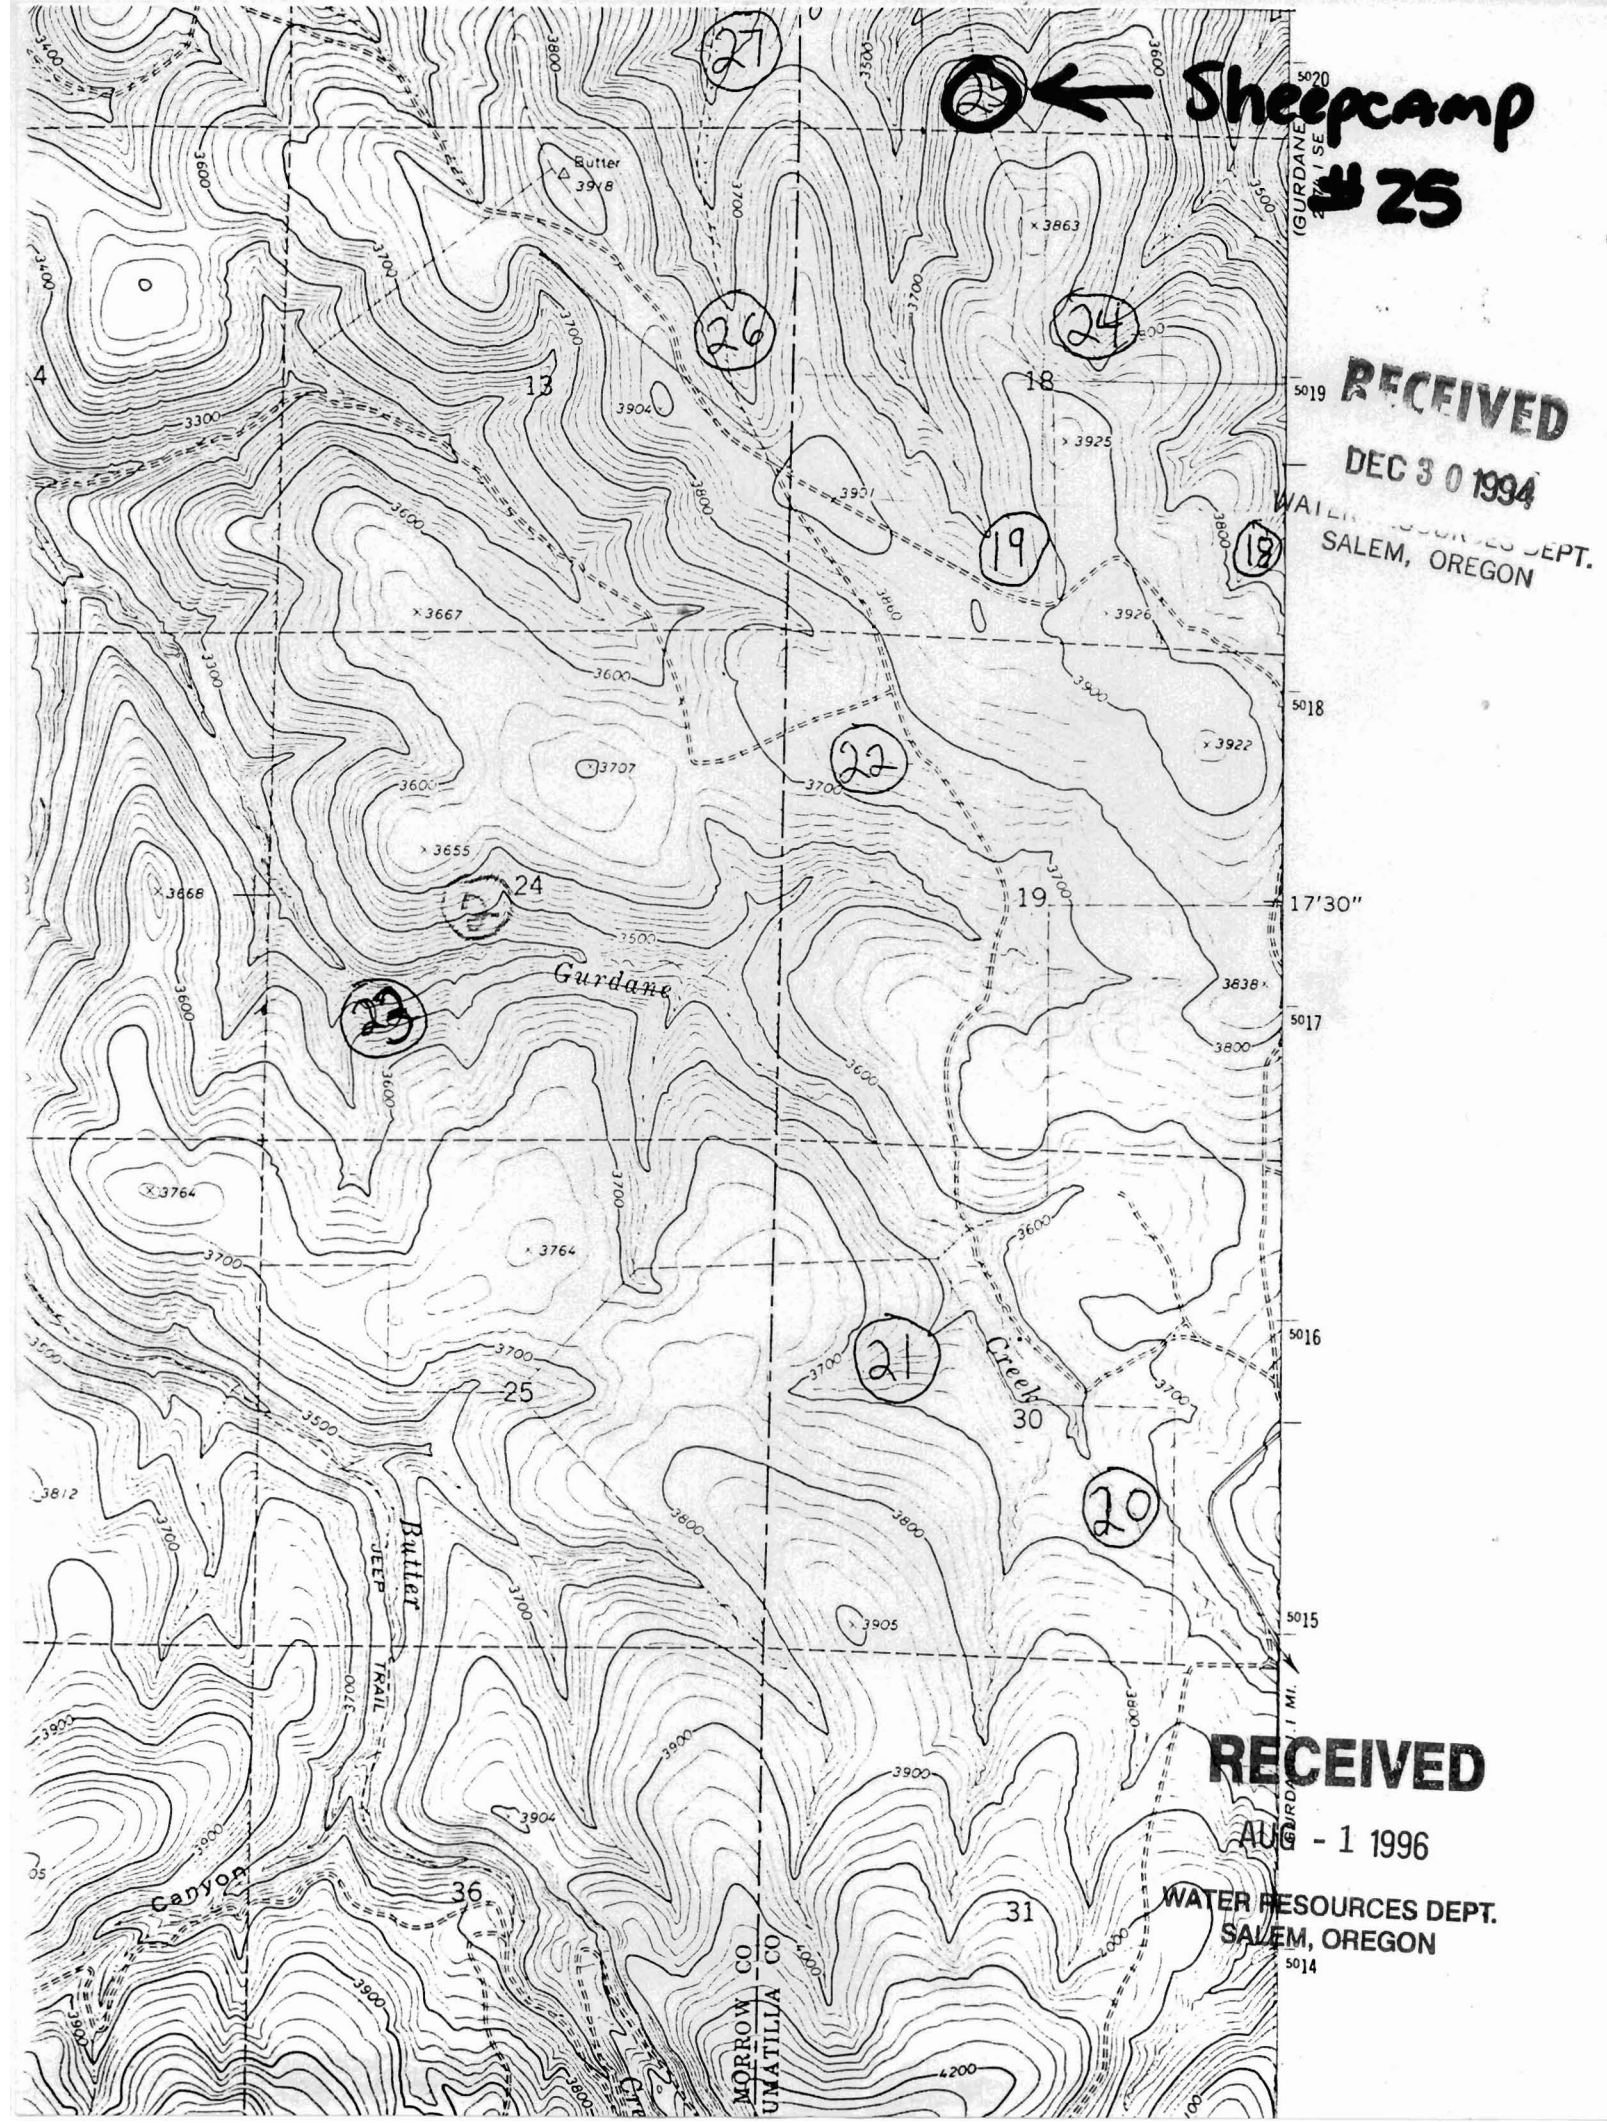

Sheepcamp  
#25

RECEIVED

DEC 30 1994

WATER RESOURCES DEPT.  
SALEM, OREGON

RECEIVED

AUG - 1 1996

WATER RESOURCES DEPT.  
SALEM, OREGON

27

26

24

19

18

22

24

19

21

20

25

30

36

31

Butter  
3948

Gurdane

Butter  
JEEP  
TRAIL

Creek

Canyon

MORROW CO  
UMATILLA CO

GURDANE  
4 1/2 SE

5019

5018

5017

5016

5015

5014












4

38/2

05





















