

RECEIVED

DEC 29 1994

WATER RESOURCES DEPT.
SALEM, OREGON

T1N R29E

T1S R30E

*R7
destroy
9/0*

36

31

6

5

RECEIVED

JUL 16 1996

WATER RESOURCES DEPT.
SALEM, OREGON

2
224.0 HEL

3
208
HEL

4
54.1
HEL

*OLD FENCE
LINE*

*SE 1/4 - SE 1/4
Sec. 6*

#11

7ED

DEC 29 1994

WATER RESOURCES DEPT.
SALEM, OREGON

WATER RESOURCES DEPT.
SALEM, OREGON

JUL 16 1996

RECEIVED

T10414

MABLE VEY

T3878

I 198

101.8
WAT

1 HEL
107.2

34471
35' strip
out for ACR

T869
I-396

35' strip - WAT
to maw for ACR
5.4

35' strip
out for ACR

OP OWENS
OW. VEY

5.4
ACR
standing
crops

UMATILLA

T 9839

T1S R29E

15
NW 1/4 - NE 1/4
AC. 1

MORROW

35 36

UMATILLA

RECEIVED

DEC 29 1994

WATER RESOURCES DEPT.
SALEM, OREGON

T1S R30E

FRANKLIN HILL QUADRANGLE OREGON


15 MINUTE SERIES (TOPOGRAPHIC)

2175 II SE
(ECHO SE)

RECEIVED

JUL 16 1995

WATER RESOURCES DEPT.
SALEM, OREGON

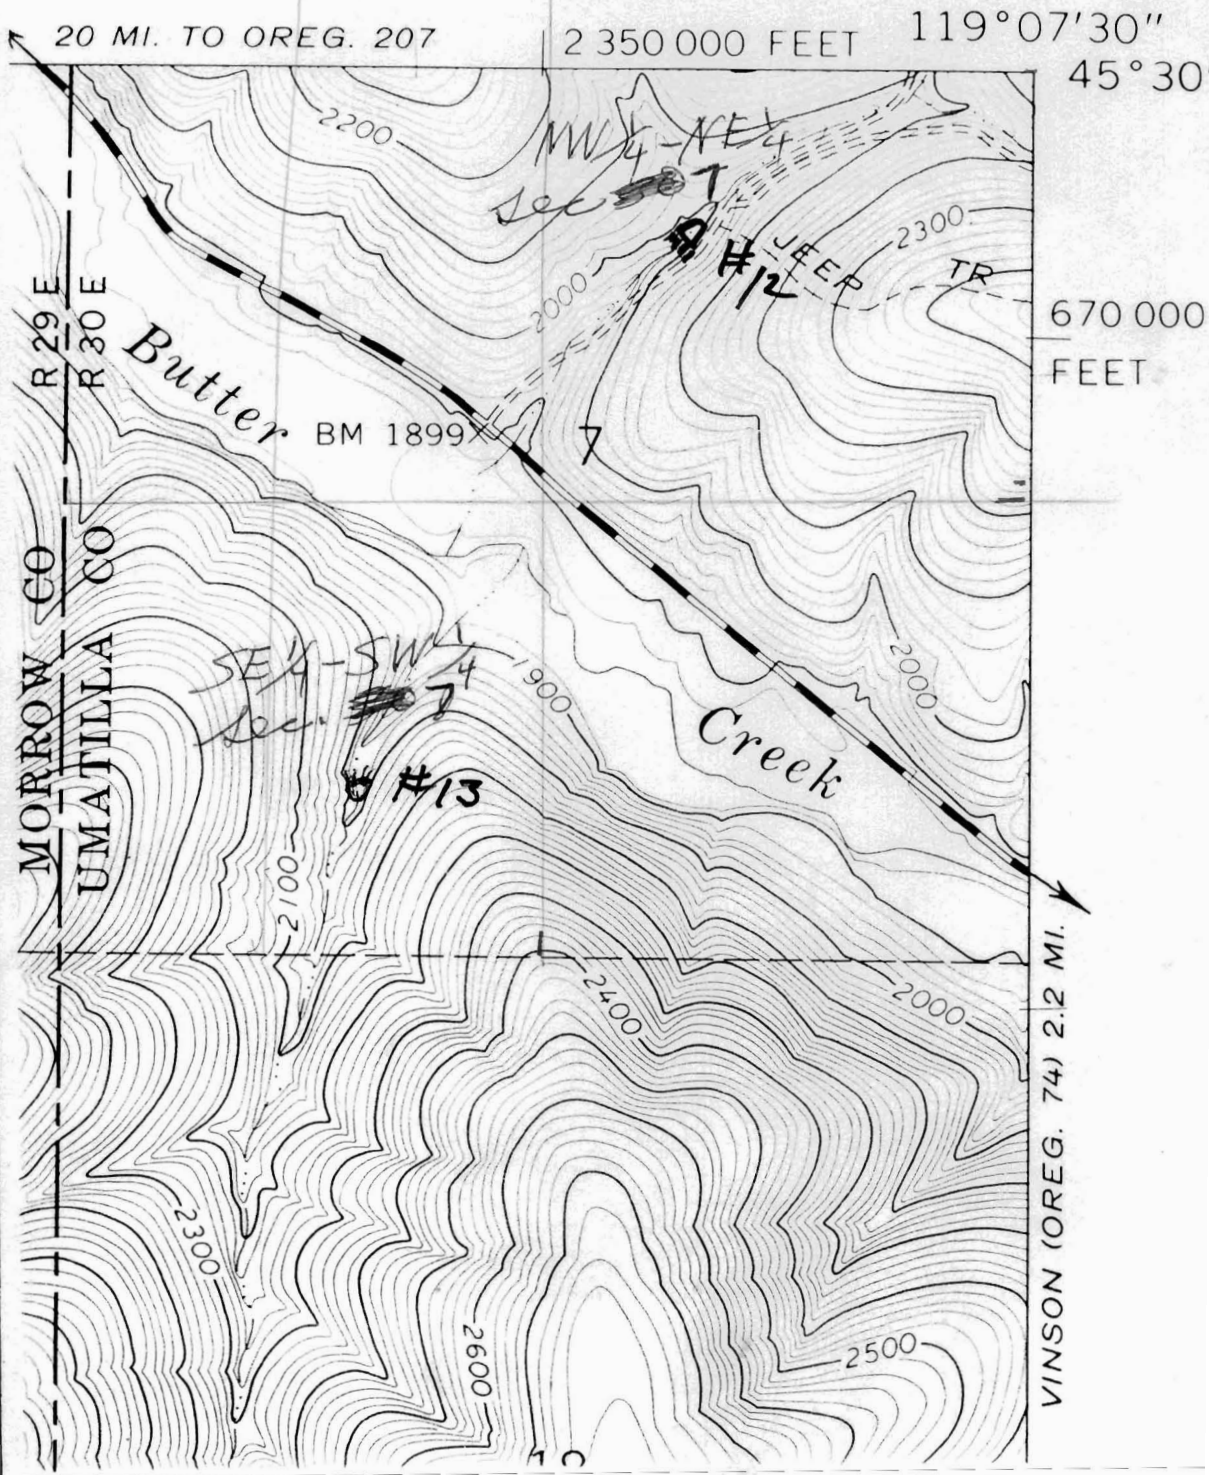

DEC 29 1994

RECEI

Л.

NTY

COUNTY

WATER RESOURCES DEPT.
SALEM, OREGON

IS JUL 29 1996

WATER RESOURCES DEPT.
SALEM, OREGON

CANCELLED

T.L. NOS

102

104

105

106
107

109

200

304

700

110
140

1500


1600

180

1802

COUNTY

SEC. 1
T.L. 300 DETAIL
1" = 400'

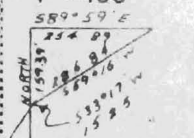

SEC. 24
T.L. 103 DETAIL
1" = 400

