


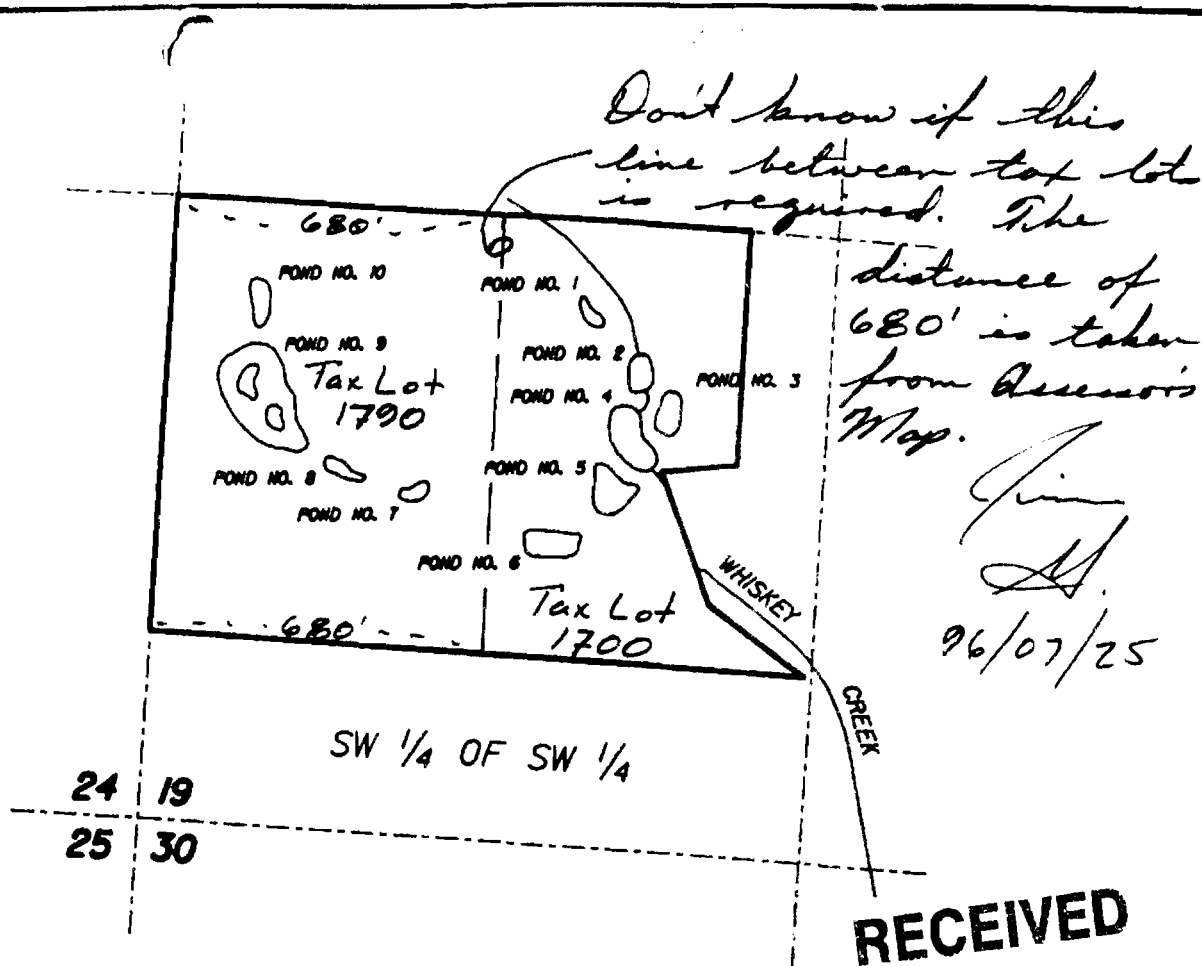

NOTE: POND NO. 4 IS NOT PART OF THIS APPLICATION. IT WAS INCLUDED IN CERTIFICATE NO. 10689.


JUL 29 1996
WATER RESOURCES DEPT.
SALEM, OREGON



SCALE: 1" = 400'

This drawing is an exhibit for a Reservoir Permit. It is not a Land Survey. Property lines and/or other lines of occupation shown hereon are not represented by the undersigned to meet accuracy standards of Land Surveys.

**SECTION 19, T.2S., R.6E., W.M.
CLACKAMAS COUNTY, OREGON**

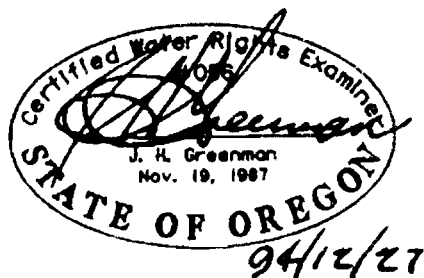

Application No. 181383

Permit No. _____




**HANER, ROSS &
SPORSEEN, INC.**

**MICHAEL D. KAISER
APPLICATION FOR**

RECEIVED

JUL 29 1998

WATER RESOURCES DEPT
SALEM, OREGON

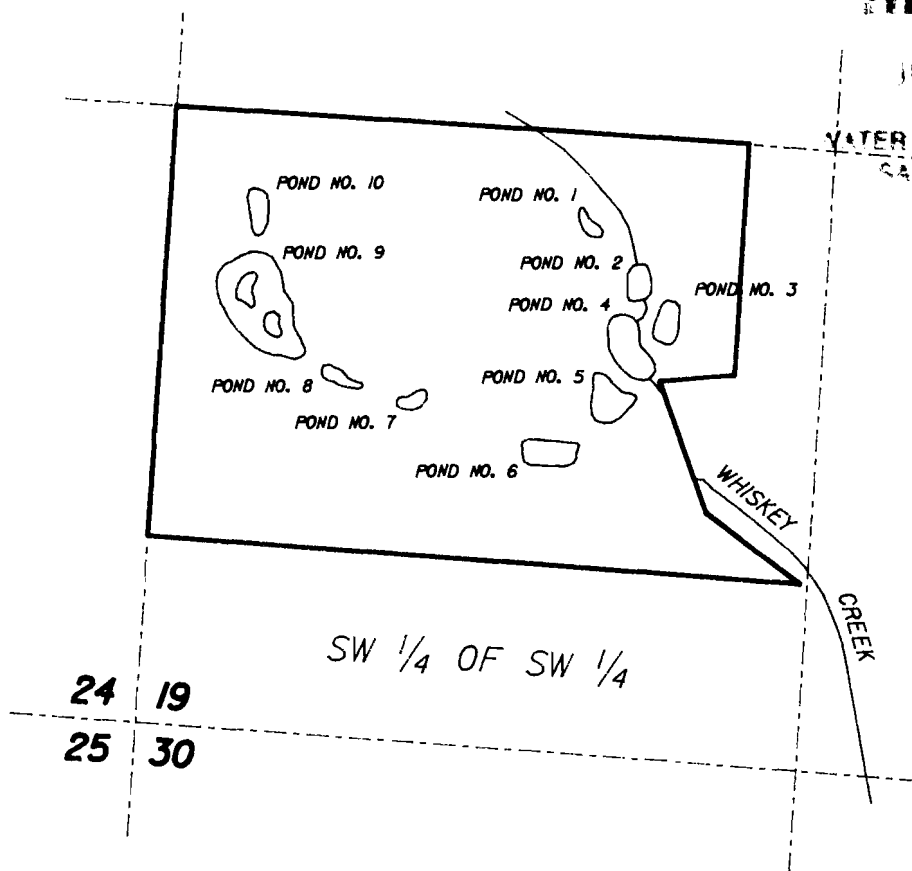

NOTE: POND NO. 4 IS NOT PART OF THIS APPLICATION. IT WAS INCLUDED IN CERTIFICATE NO. 10689.


4.



SCALE: 1" = 400'

This drawing is an exhibit for a Reservoir Permit. It is not a Land Survey. Property lines and/or other lines of occupation shown hereon are not represented by the undersigned to meet accuracy standards of Land Surveys.


SECTION 19, T.2S., R.6E., W.M.
CLACKAMAS COUNTY, OREGON

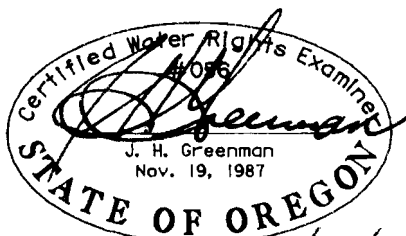

94/12/27

Application No. 181383

Permit No. _____

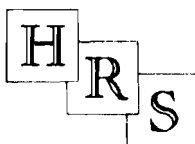

HANER, ROSS &
SPORSEEN, INC.

15 S.E. 82ND DRIVE
GLADSTONE, OREGON 97027

MICHAEL D. KAISER
APPLICATION FOR
A RESERVOIR PERMIT

630K