


T. 9 S., R. 3 E., W.M.

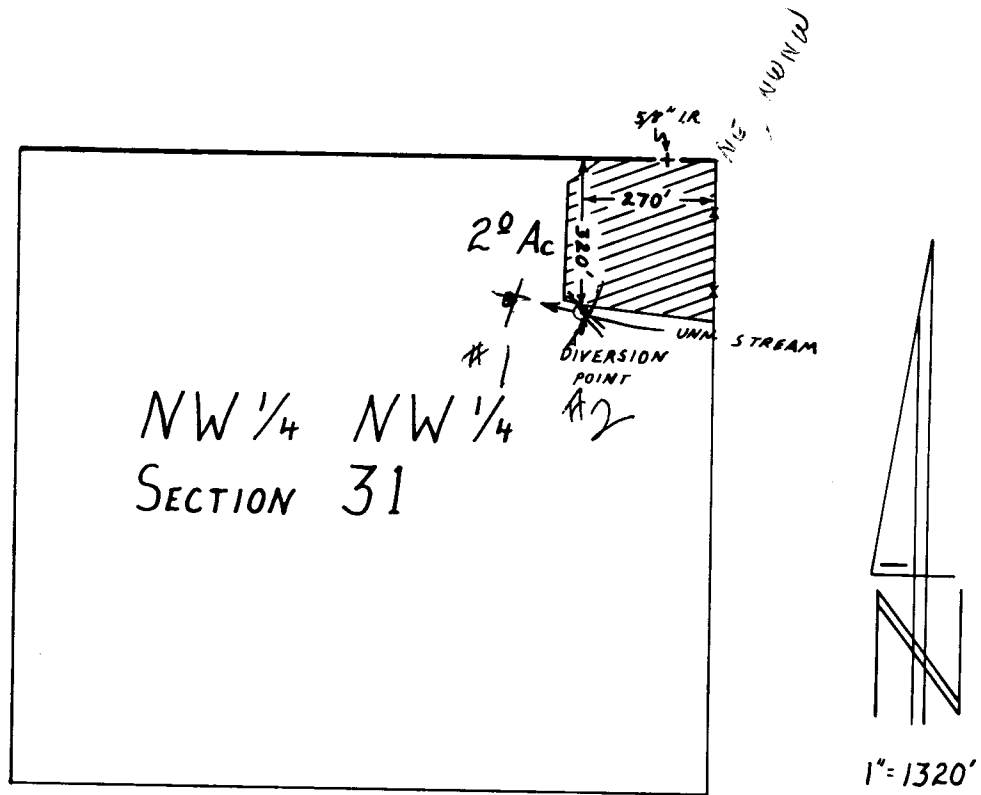

Application No. R-21388
Permit No.

RECEIVED

AUG 08 1996

WATER RESOURCES DEPT.
SALEM, OREGON

FINAL PROOF SURVEY

UNDER

Application No. 65158 Permit No. 47583
IN NAME OF

VICKI WARD

Surveyed APRIL 12, 1991, by R.W. Klassen