

T. 31 R. 28

RECEIVED

DEC 30 1994

WATER RESOURCES DEPT.
SALEM, OREGON

RECEIVED


JUL 26 1996

WATER RESOURCES DEPT.
SALEM, OREGON

1. UPPER RES.

2. LOWER RES.

FOREJANA CANYON
2169 IV SW

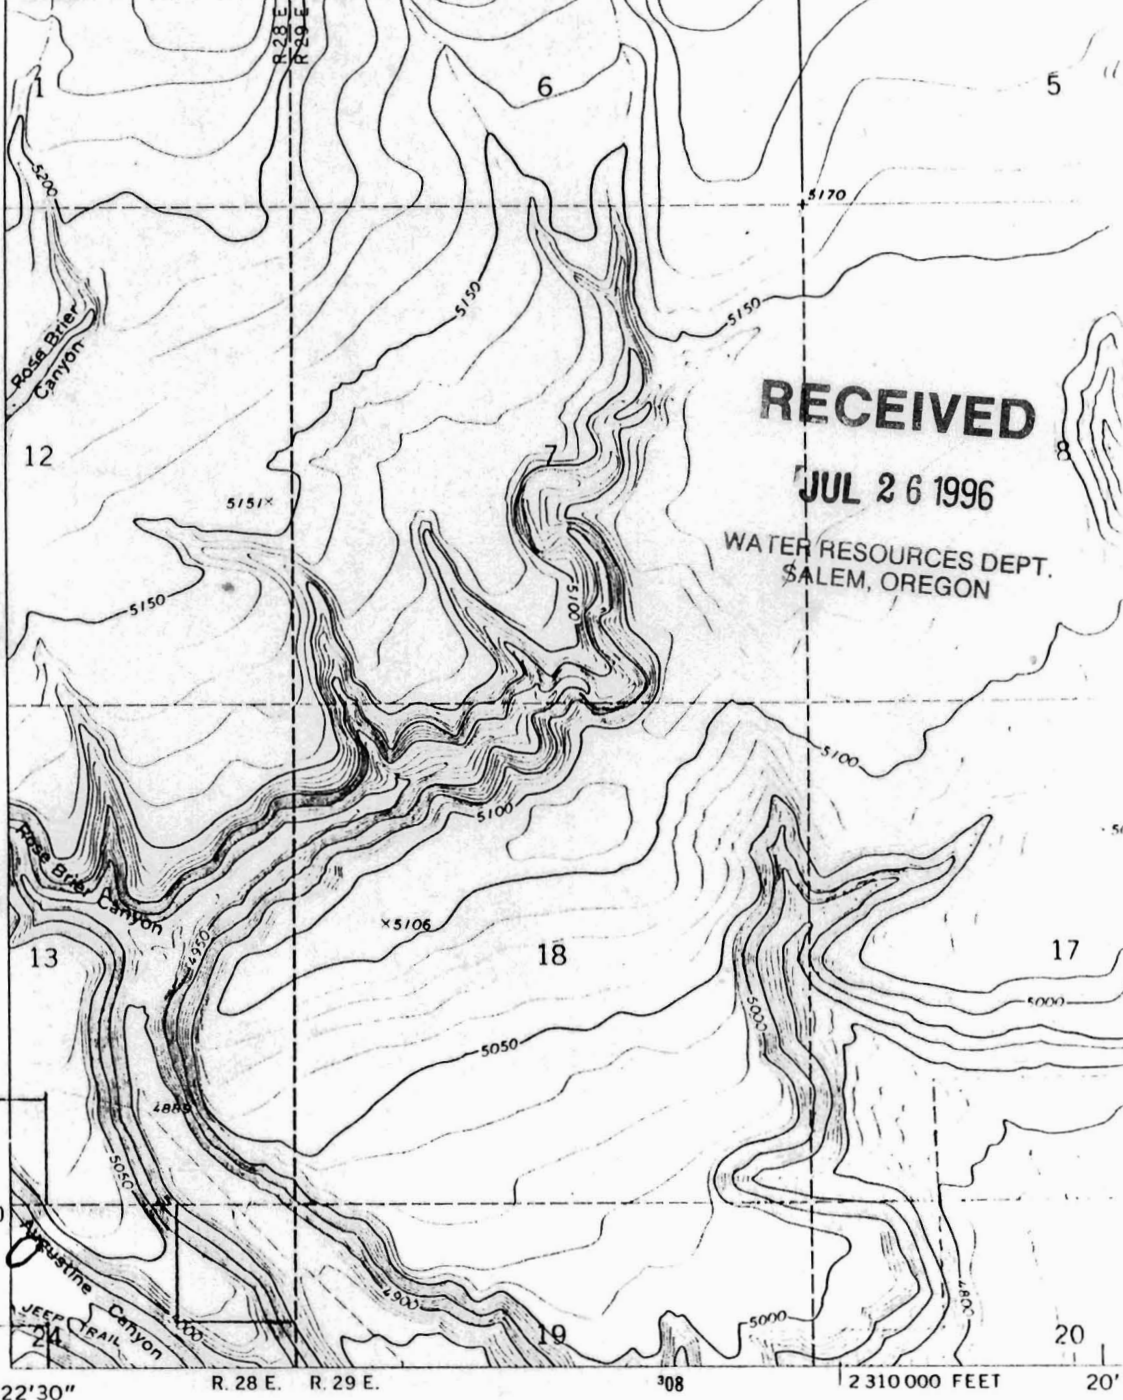

Mapped, edited, and published by the Geological Survey

Control by USGS and USC&GS


Topography by photogrammetric methods from aerial
photo

Pl
Pr
sy
1C
zo
Fir

CLOVER SWALE, OREG.
N4252.5-W11915/7.5

1971

AMS 2169 IV NE-SERIES V892

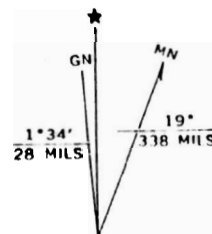

TM GRID AND 1971 MAGNETIC NORTH
DECLINATION AT CENTER OF SHEET

Application No. R-81395
Permit No.