


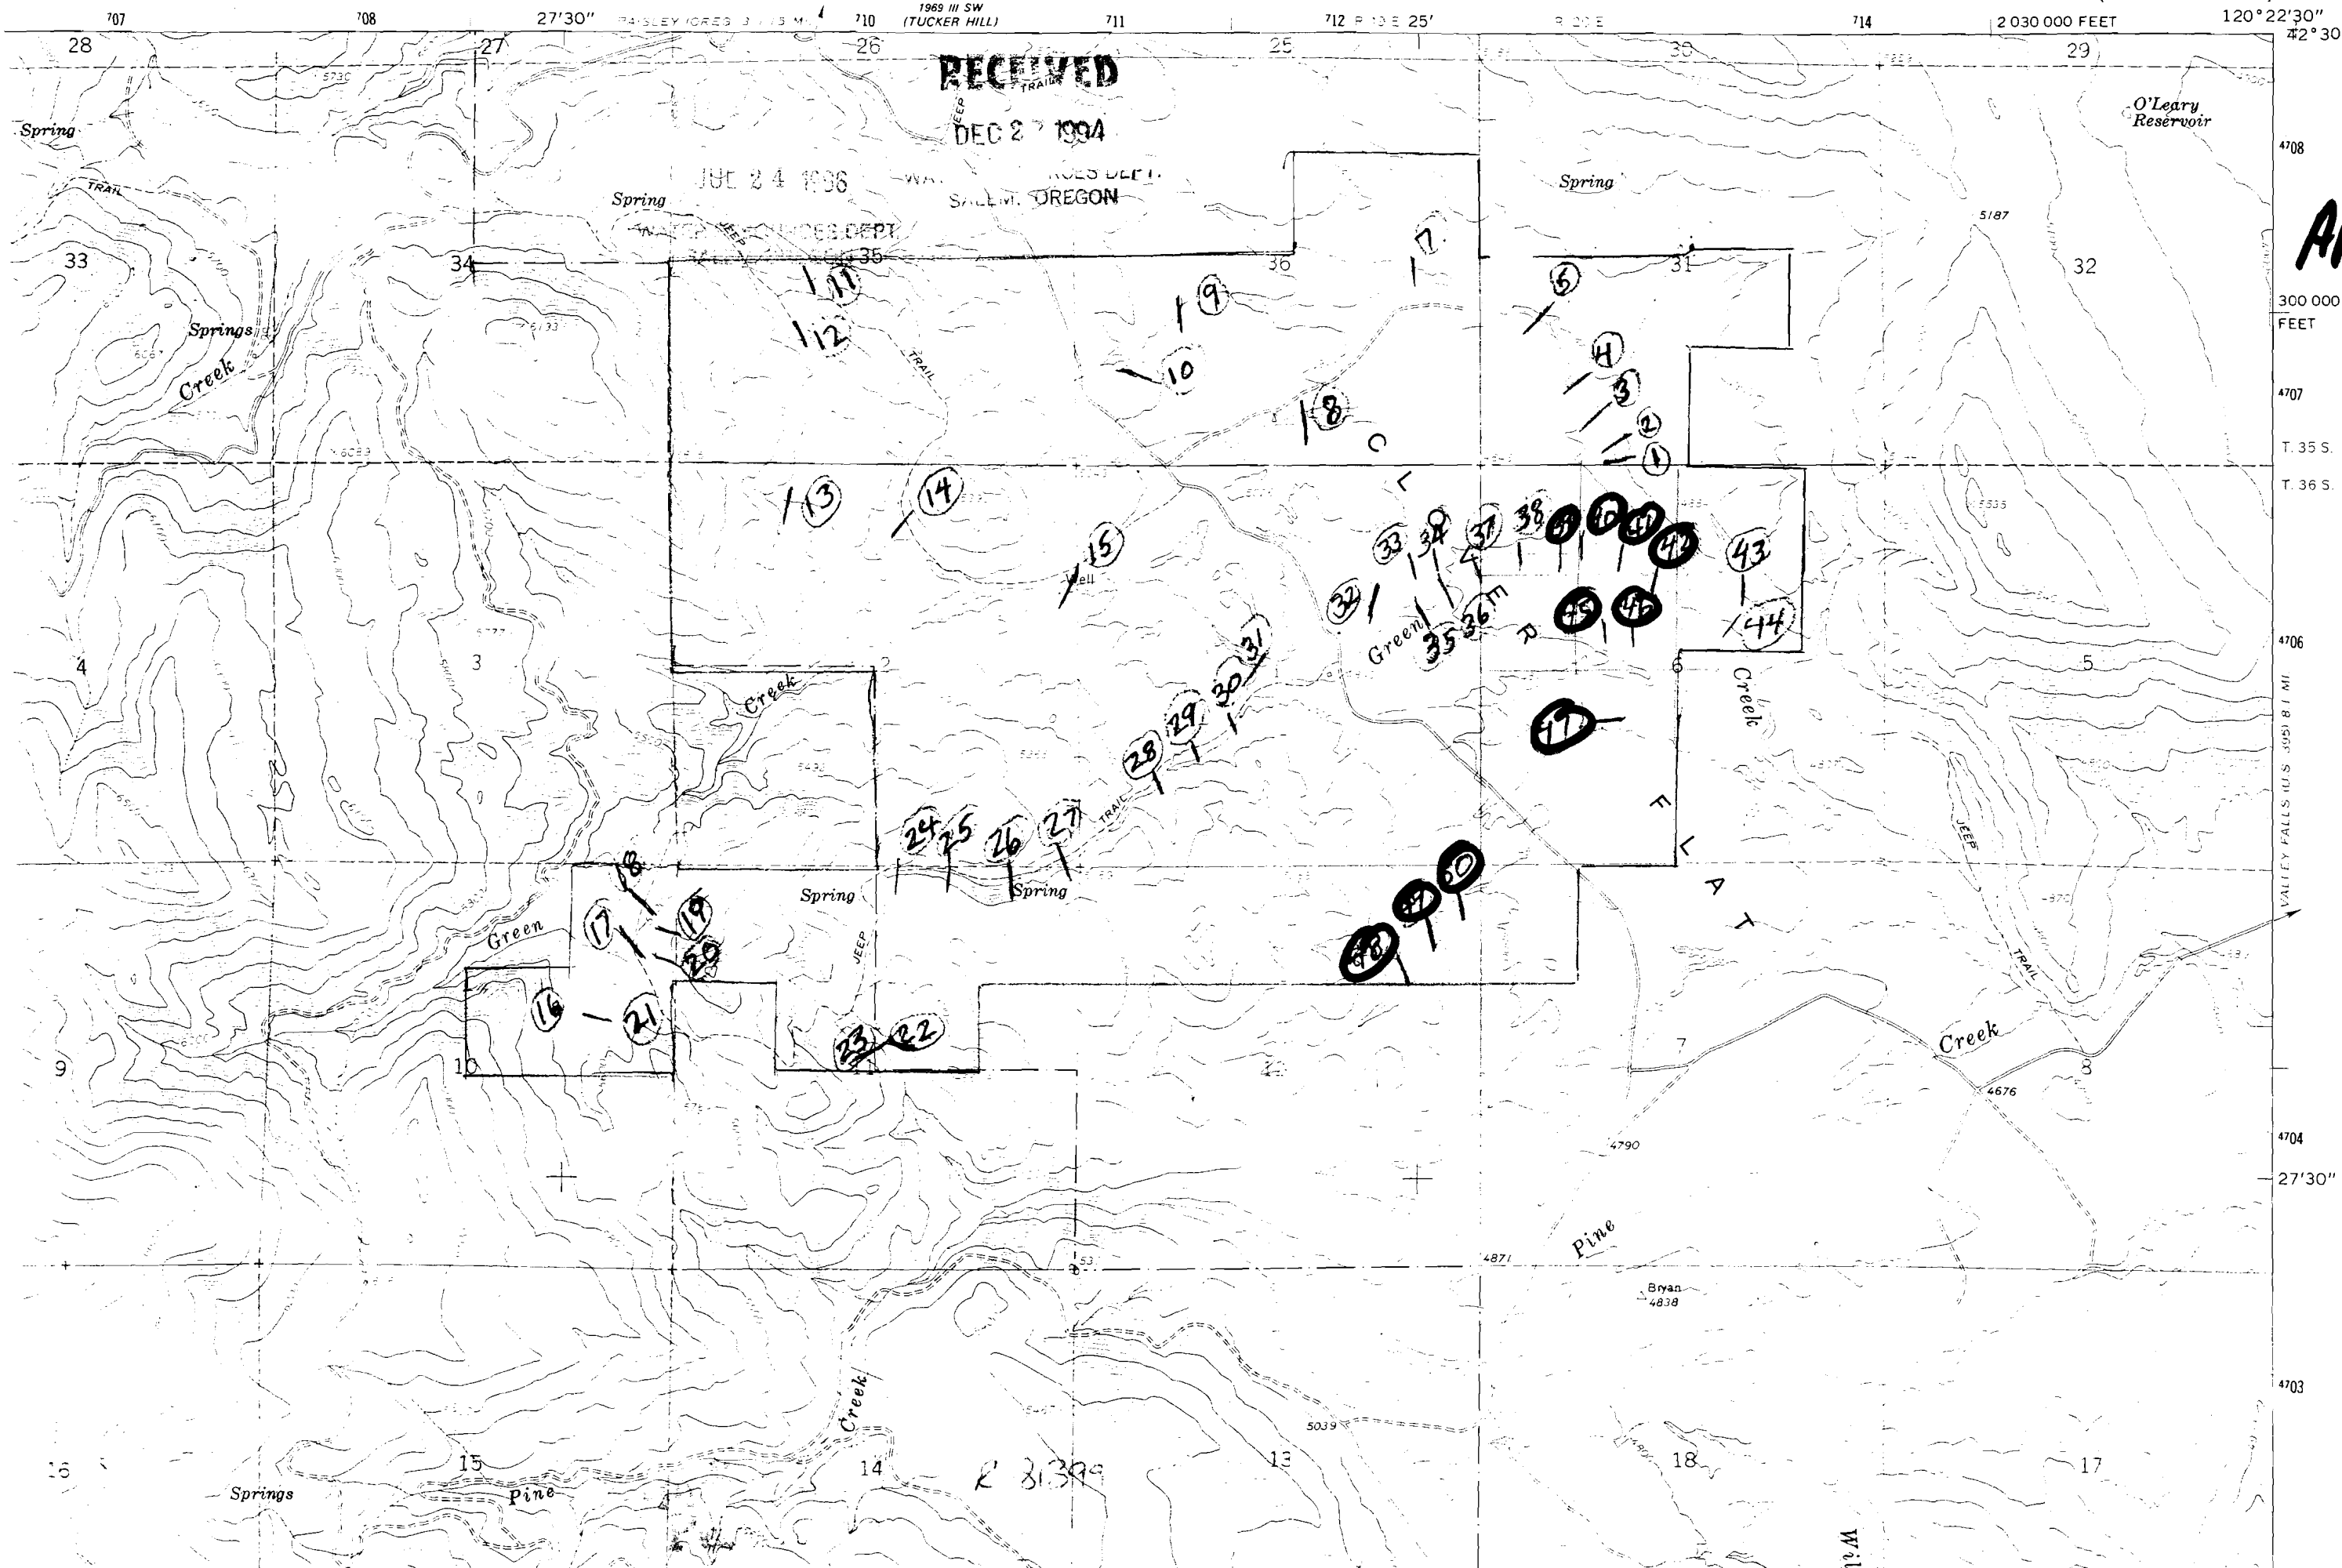

APP #5

300 000
FEET

4708
T. 35 S.
T. 36 S.

4706
VALLEY FALLS 10 S 30 S 8 1 MI

4704
27'30"

4703

No Final Proof Map available

No Permit Map available