


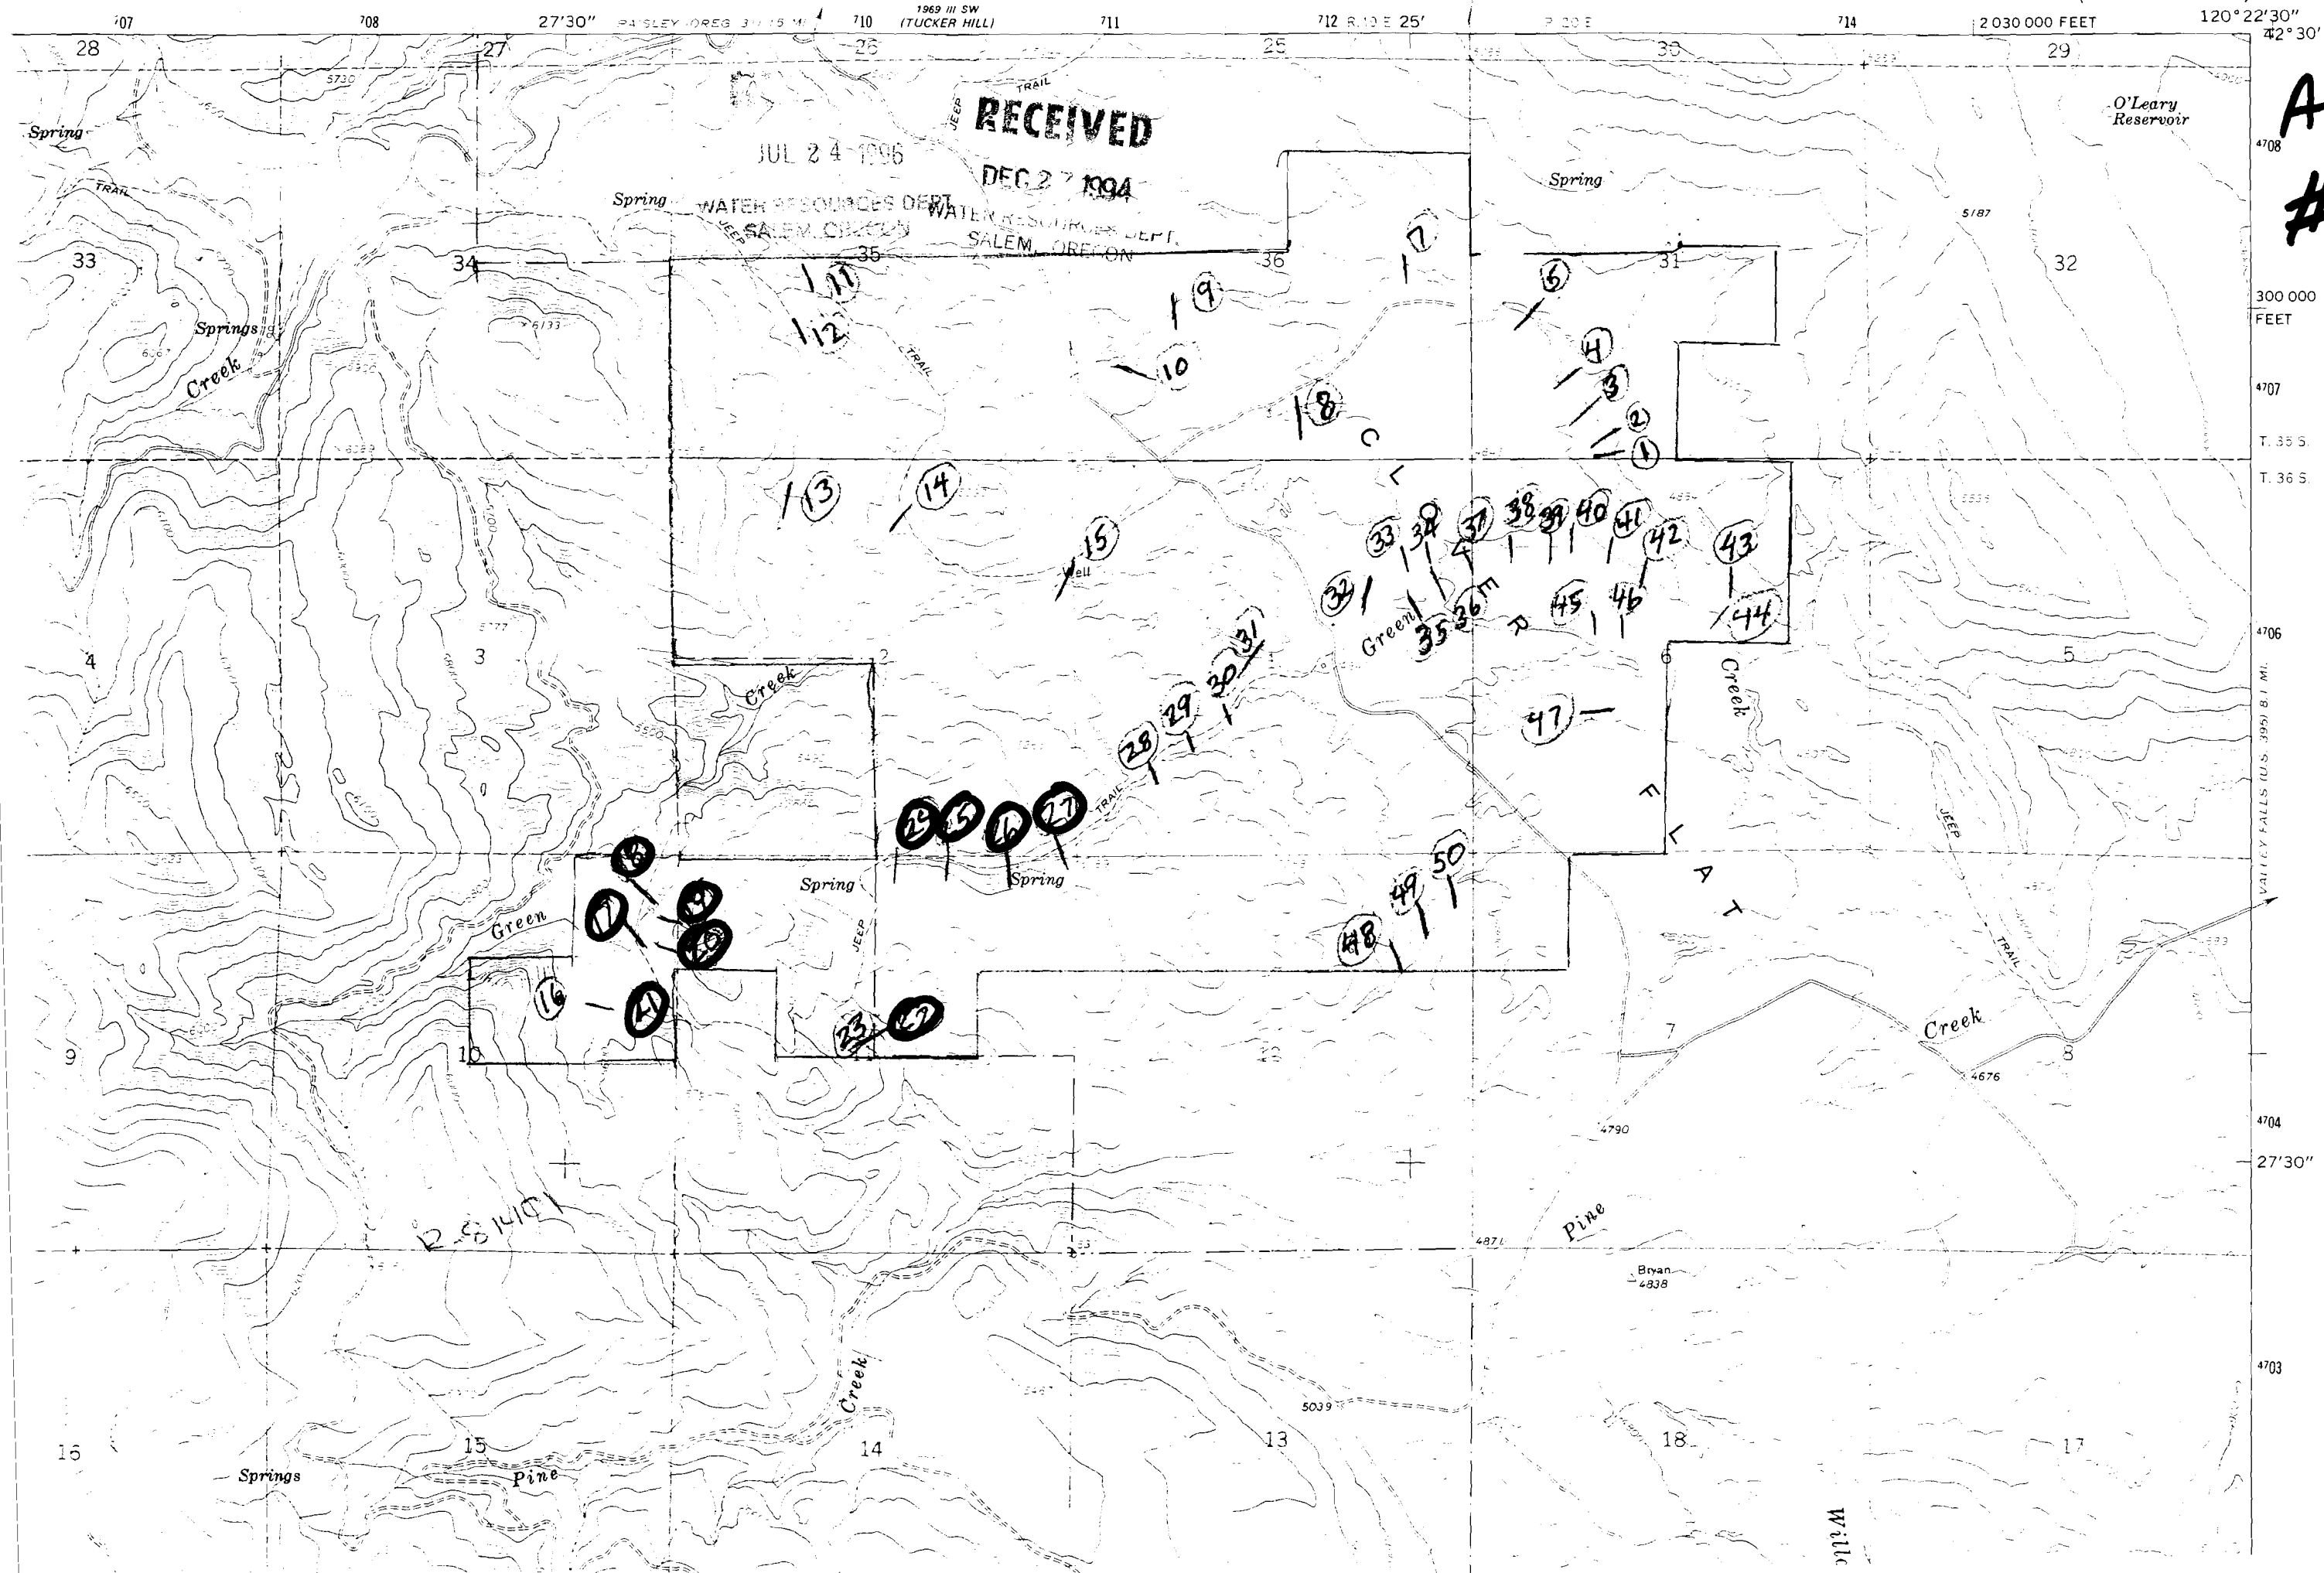

APP
#3

No Final Proof Map available

No Permit Map available