


CLOVER FLAT QUADRANGLE  
OREGON-LAKE CO.  
7.5 MINUTE SERIES (TOPOGRAPHIC)

1989 III -  
(COPLAN BUTTE)

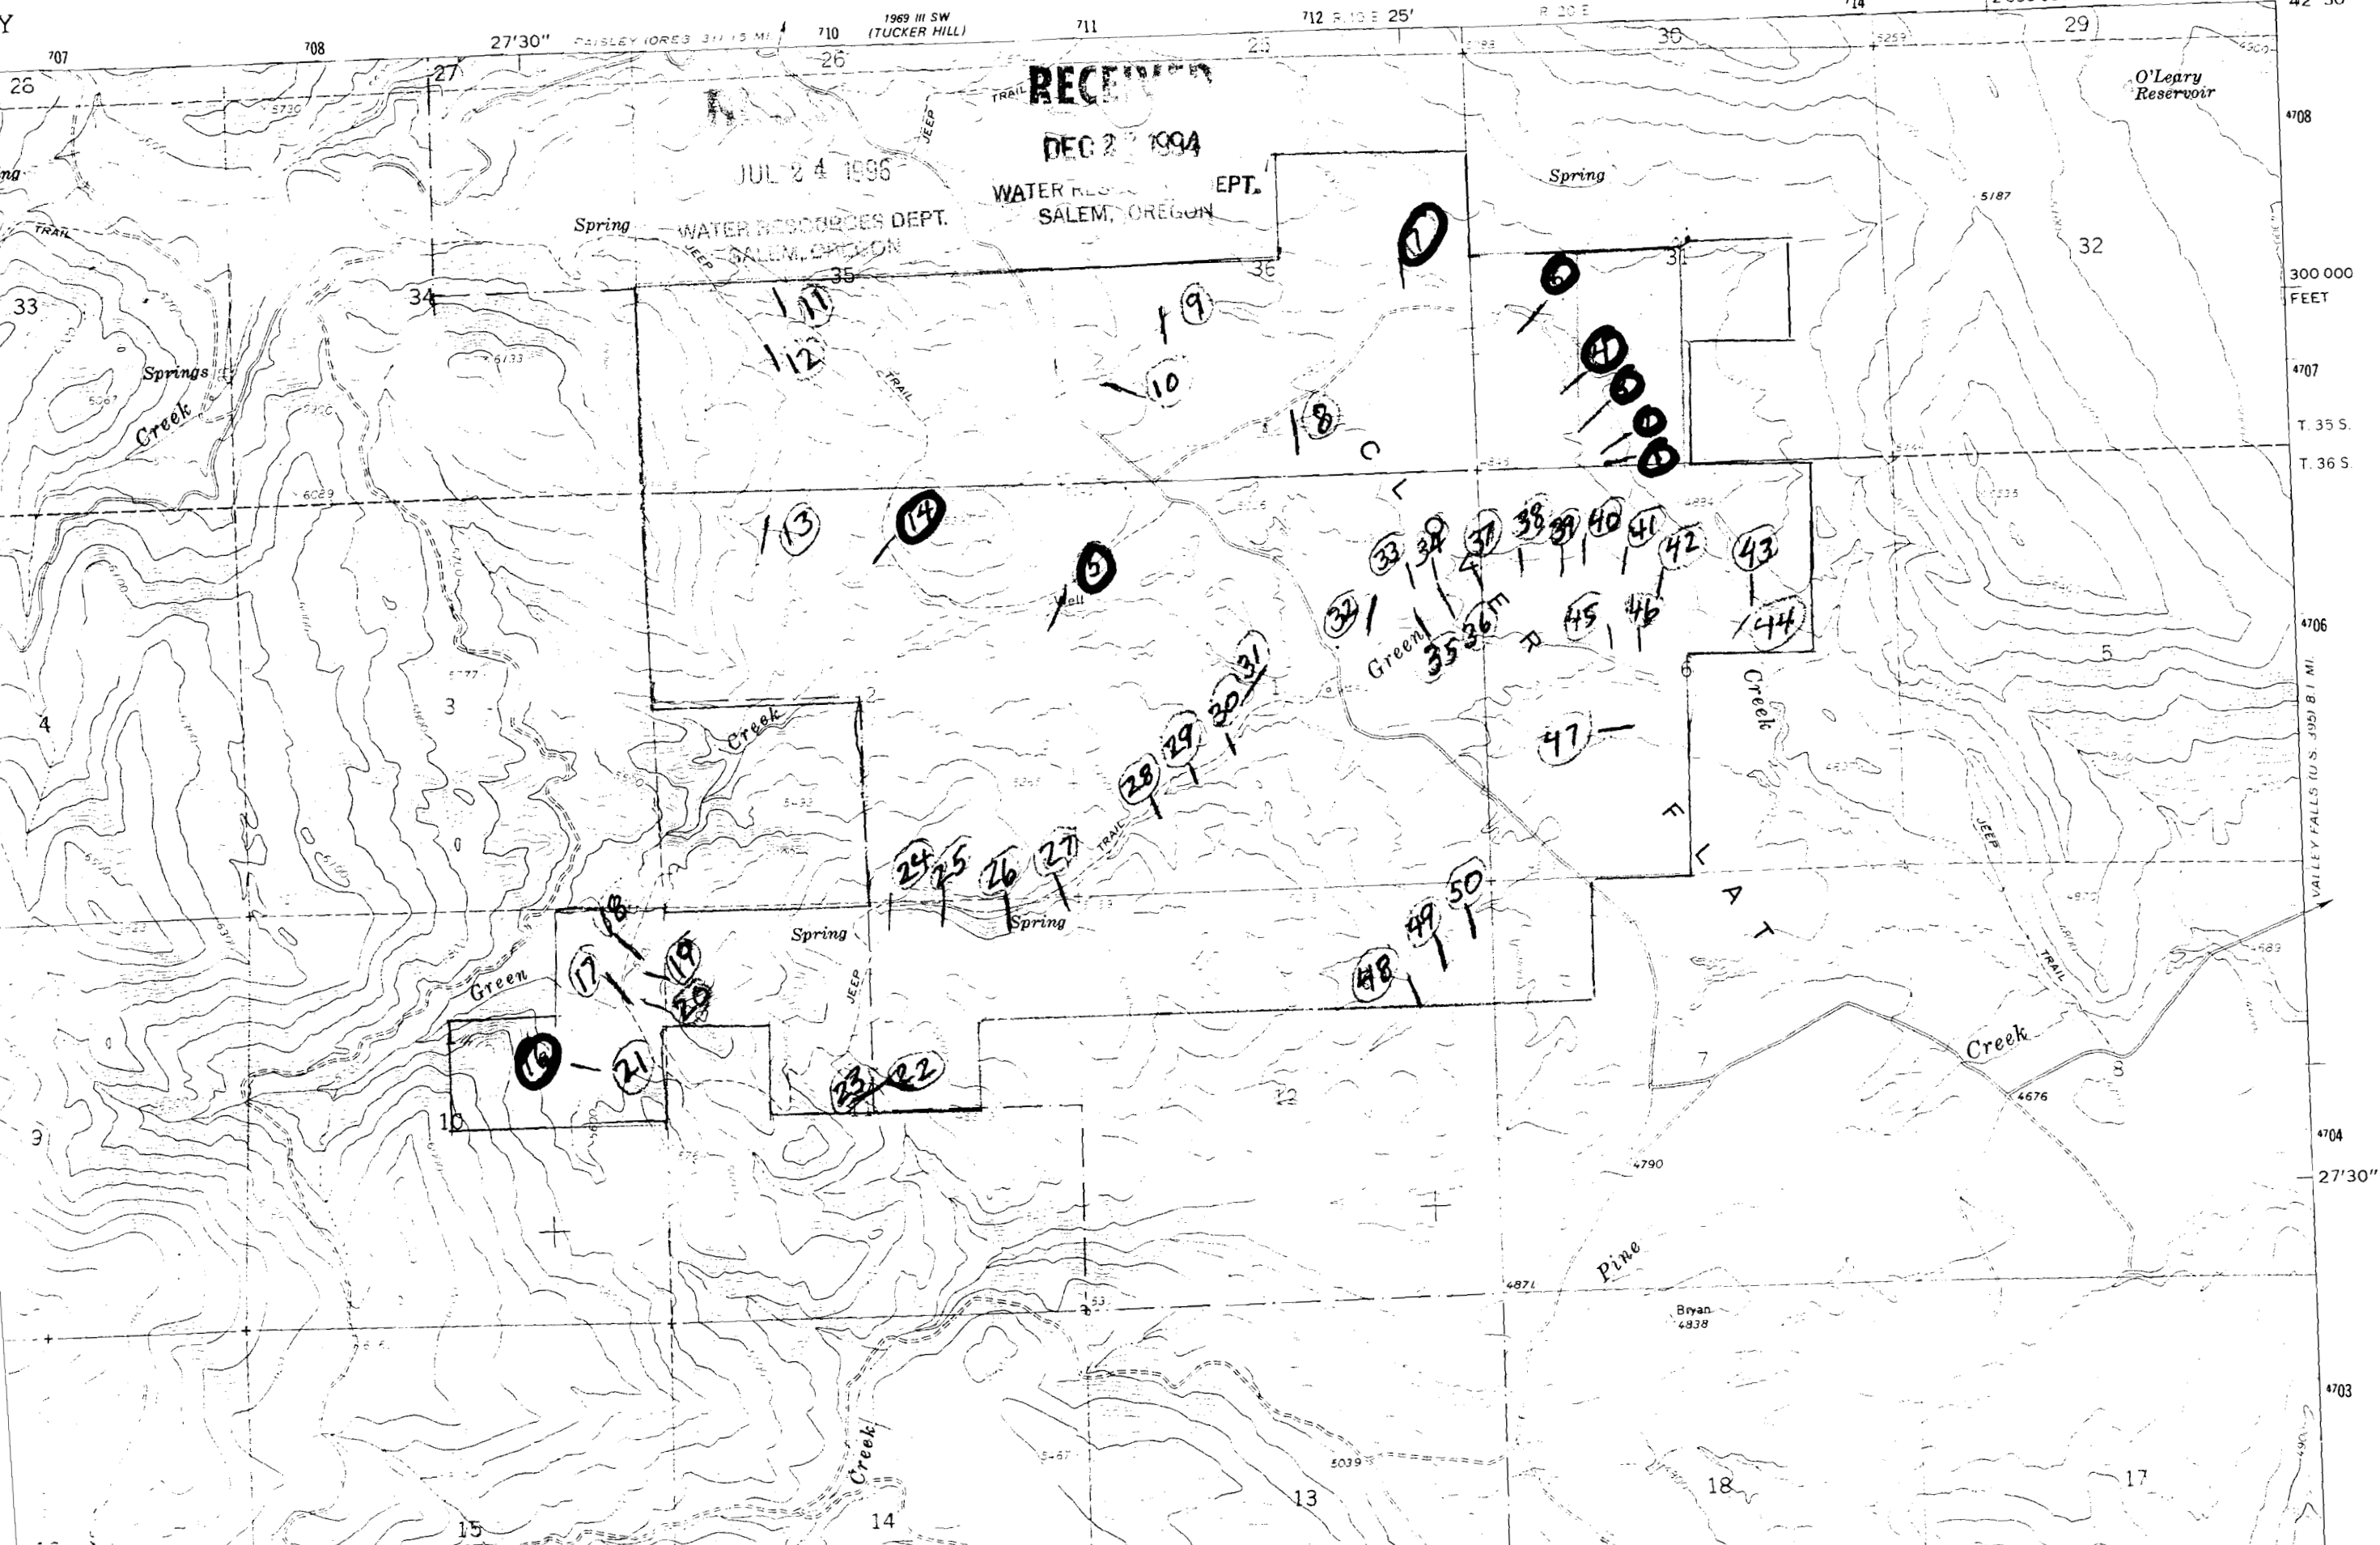

L-8/40.2

No Final Proof Map available

No Permit Map available