

9

10

RECEIVED

AUG 13 1996

WATER RESOURCES DEPT.
SALEM, OREGON

RECEIVED
JUL 18 1996
WATER RESOURCES DEPT.
SALEM, OREGON

Application No. R-81406
Permit No.

THIS SECTION IS MADE SOLELY FOR THE PURPOSE OF ASSESSING IN THE SAID SECTION AND THE COMPANY IS NOT RESPONSIBLE FOR VARIATIONS IN ANY MEASUREMENTS AND LOCATIONS DETERMINED BY ACTUAL SURVEY.

SCALE 1

201
640.00Ac

16

3

15

14

FOREST

200
240.00Ac

500
120.00Ac

410
120.00Ac

405
40.00Ac

407 20.00Ac

406 20.00Ac

416
80.00Ac

TRAM STEWART

JENN McLAUGHLIN
B. H. STEWART

Road location

21

22

23

800
80.00Ac

408
40.00Ac
LARKIN (FLOWERS)

412
320.00Ac

402
12.00Ac

1700
80.00Ac

1701
80.00Ac

1600
160.00Ac

413
135.00Ac

409
24.00Ac

403
20.00Ac

1200
156.83Ac

1800
2296.84Ac

28

1400
58.29Ac

414
40.00Ac

419
40.00Ac

418
40.00Ac

27

411
31.80Ac

420
38.51Ac

415
39.98Ac

1100
1684.83Ac

RA 43

1300
40.00Ac

1800

1800

2100

2100

1100

3.4 mi to 395

RECEIVED

JAN - 4 1995

WATER RESOURCES DEPT.
SALEM, OREGON

This Pond WAS
Built by A Previous
Land owner in
1979 And WAS
ENLARGED by the
Hays (current owner)
in 1986.

Mark Cerny
(caretaker)


12-26-94

Hayer

Application No 281406
Permit No

JUL 18 1996

RECEIVED

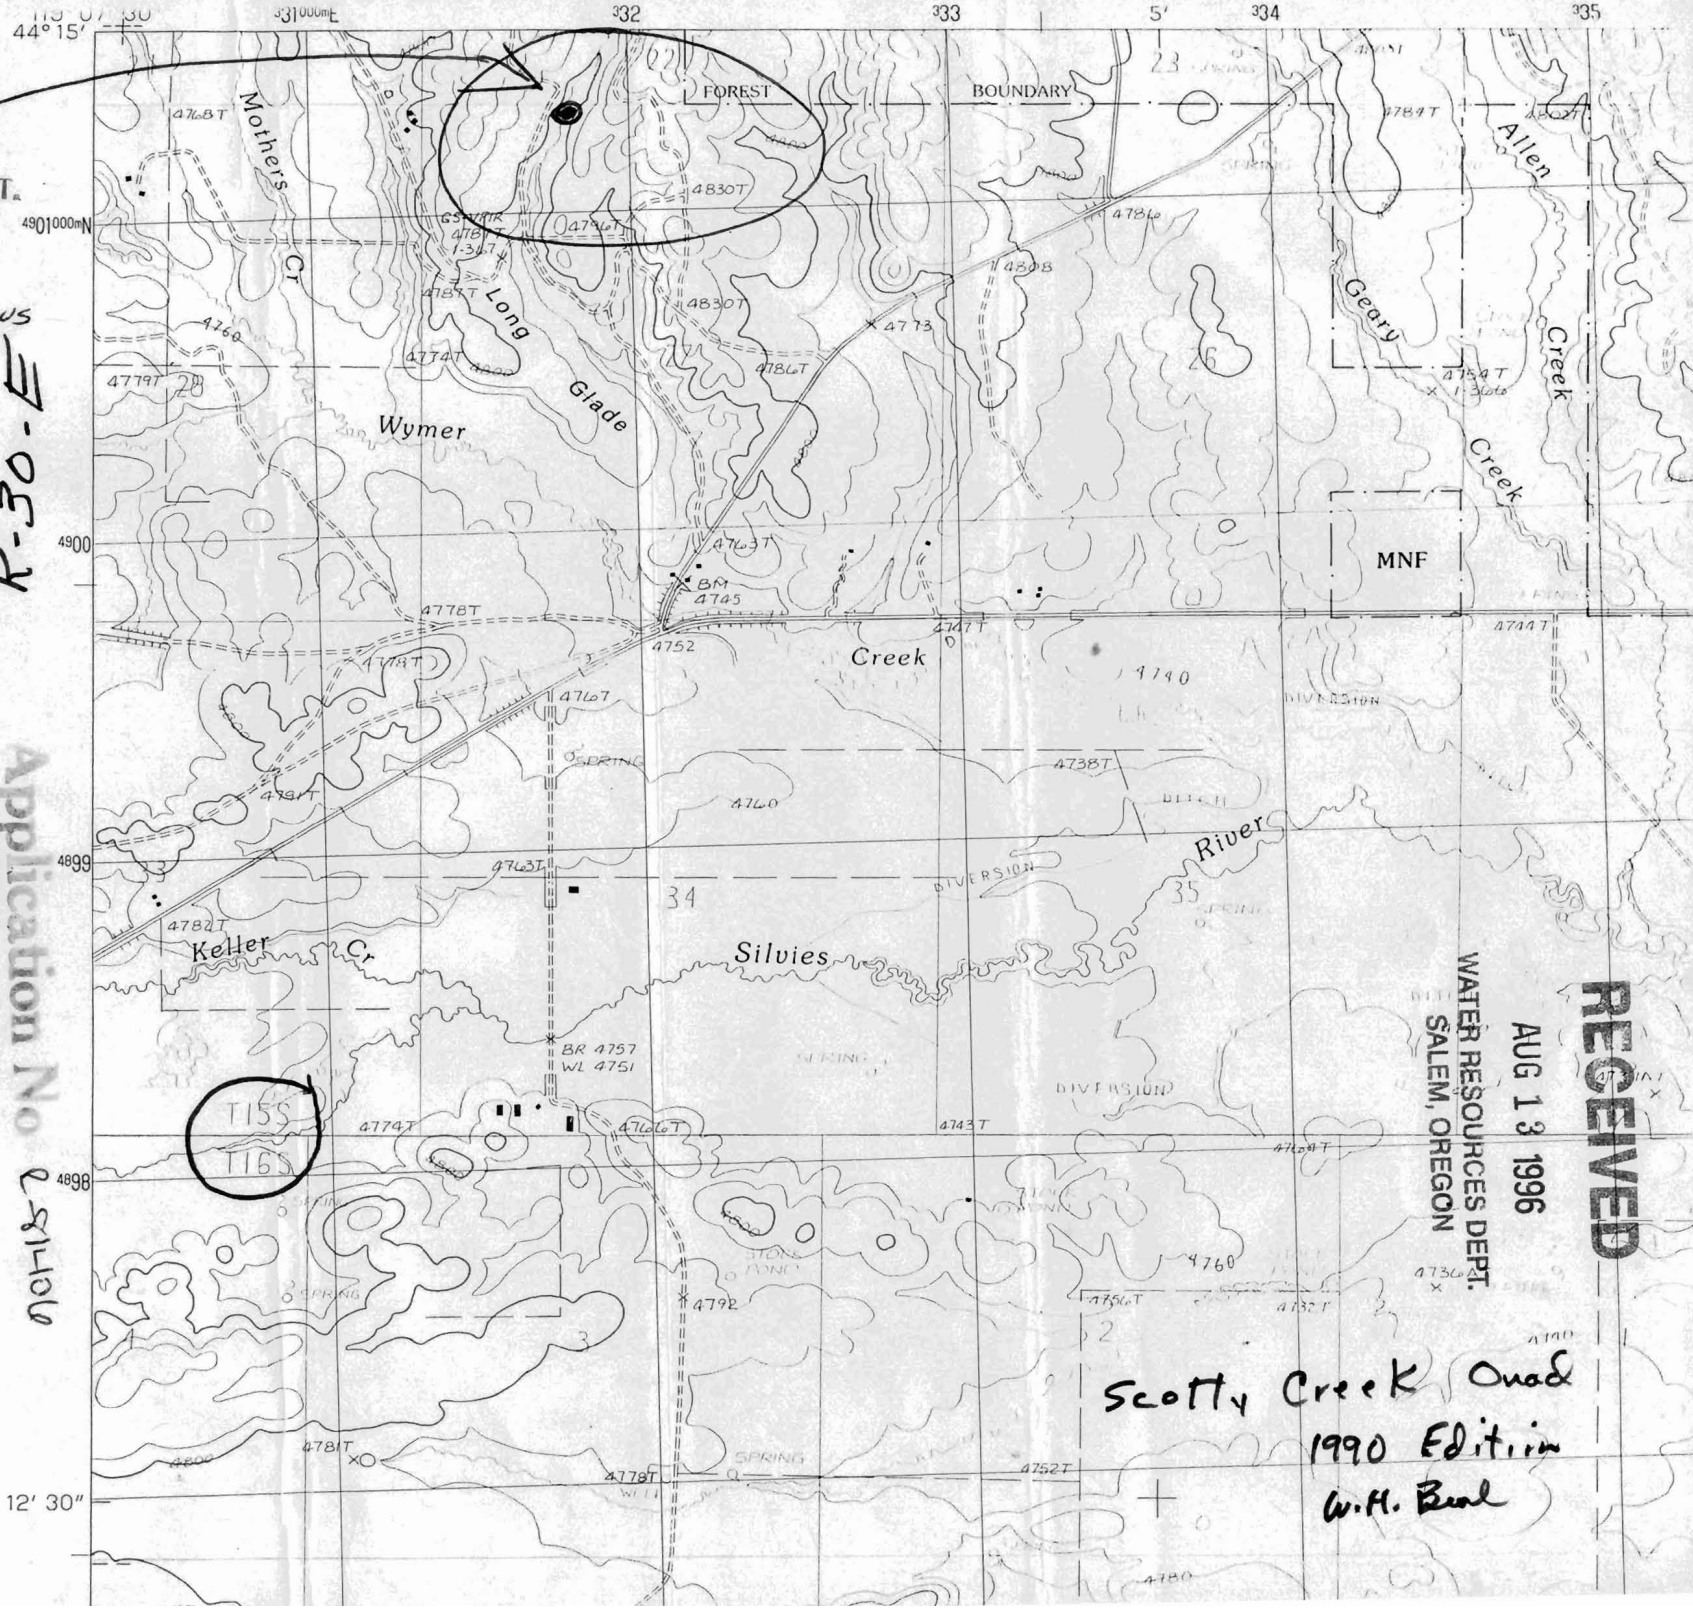

RECEIVED

AUG 13 1996

WATER RESOURCES DEPT.
SALEM, OREGON

Scotty Creek Quad
1990 Edition
W.H. Beal