

10324


MAP
To Accompany Application of
Richard Beddows
for a permit to appropriate water
in - Sec. 19 Twp 28 S. R. 12 W. W. M.

TWP 28 S. R. 12 W. W. M.

STATE ENGINEER
RECEIVED

AUG 6 1925

SALEM, OREGON

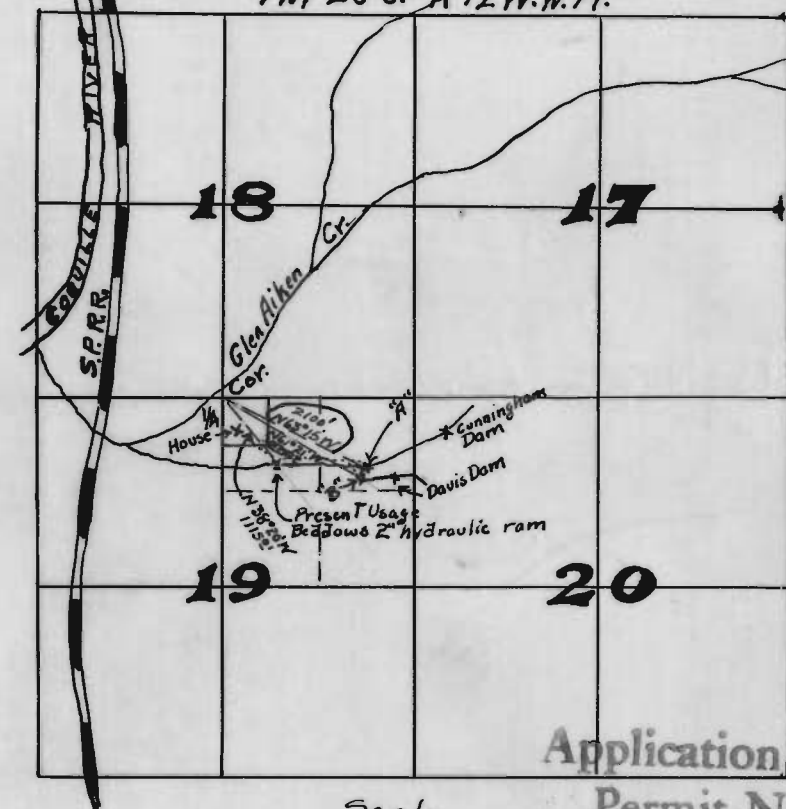

Bearing of Points
to $\frac{1}{4}$ Cor. Bet Sec 18 and 19
"A" N 63° 15' W 2100'
"B" N 61° 20' W 2082'
Present Usage N 38° 20' W 1115'

Application No. 10324
Permit No. 6934

Application No. 10324
Permit No. 6934

Scale
one inch = 40 chains.

I, D. L. Buckingham of Marshfield Oregon, hereby
certify that this map was made from notes taken
during an actual survey made under my direction
July 25 1925 and that it correctly represents the works
described in the accompanying application together
with the streams and water fillings and usages in
the immediate vicinity

D. L. Buckingham

