


SECTION 8 T.27S. R. 5 W. W.M.
DOUGLAS COUNTY

REVISED ON
8-31-93

RECEIVED 27 5 8
DEC 28 1994
WATER RESOURCES DEPT.
SALEM, OREGON

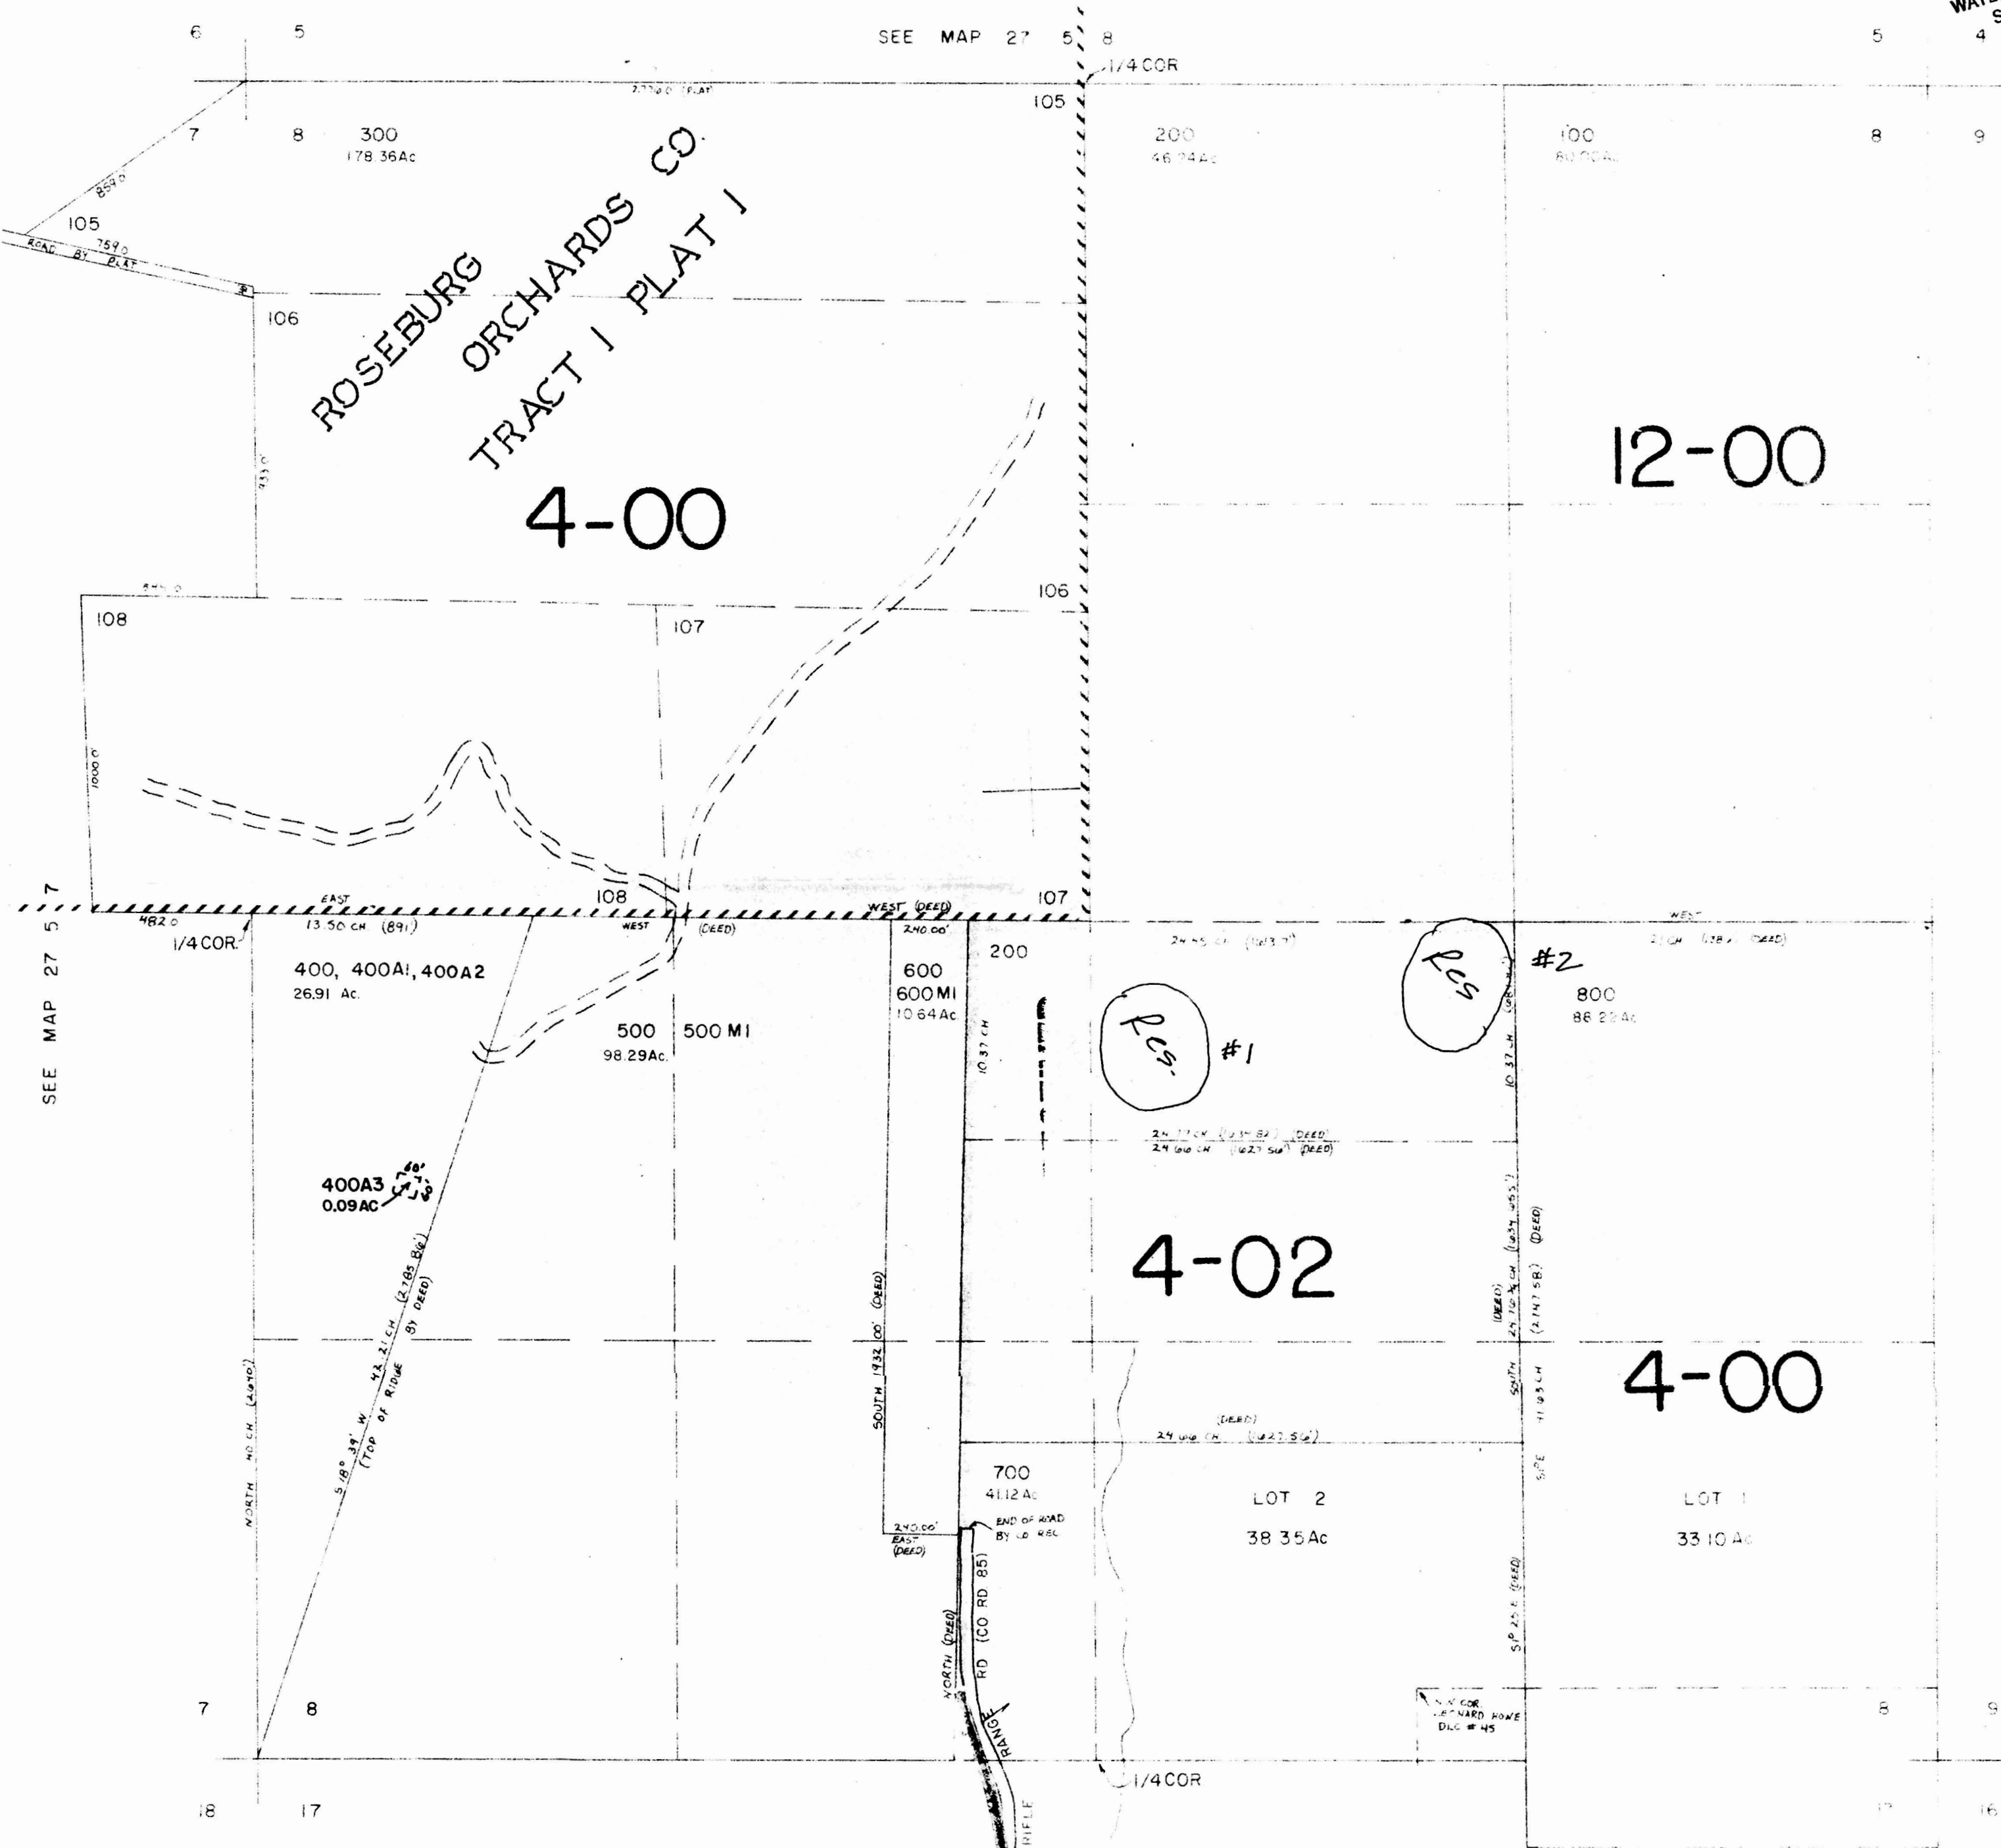

4-00

12-00

4-02

4-00

SEE MAP 27 5 9

RECEIVED

JUL 30 1996
WATER RESOURCES DEPT.
SALEM, OREGON

SEE MAP 27 5 17

No Final Proof Map available

No Permit Map available