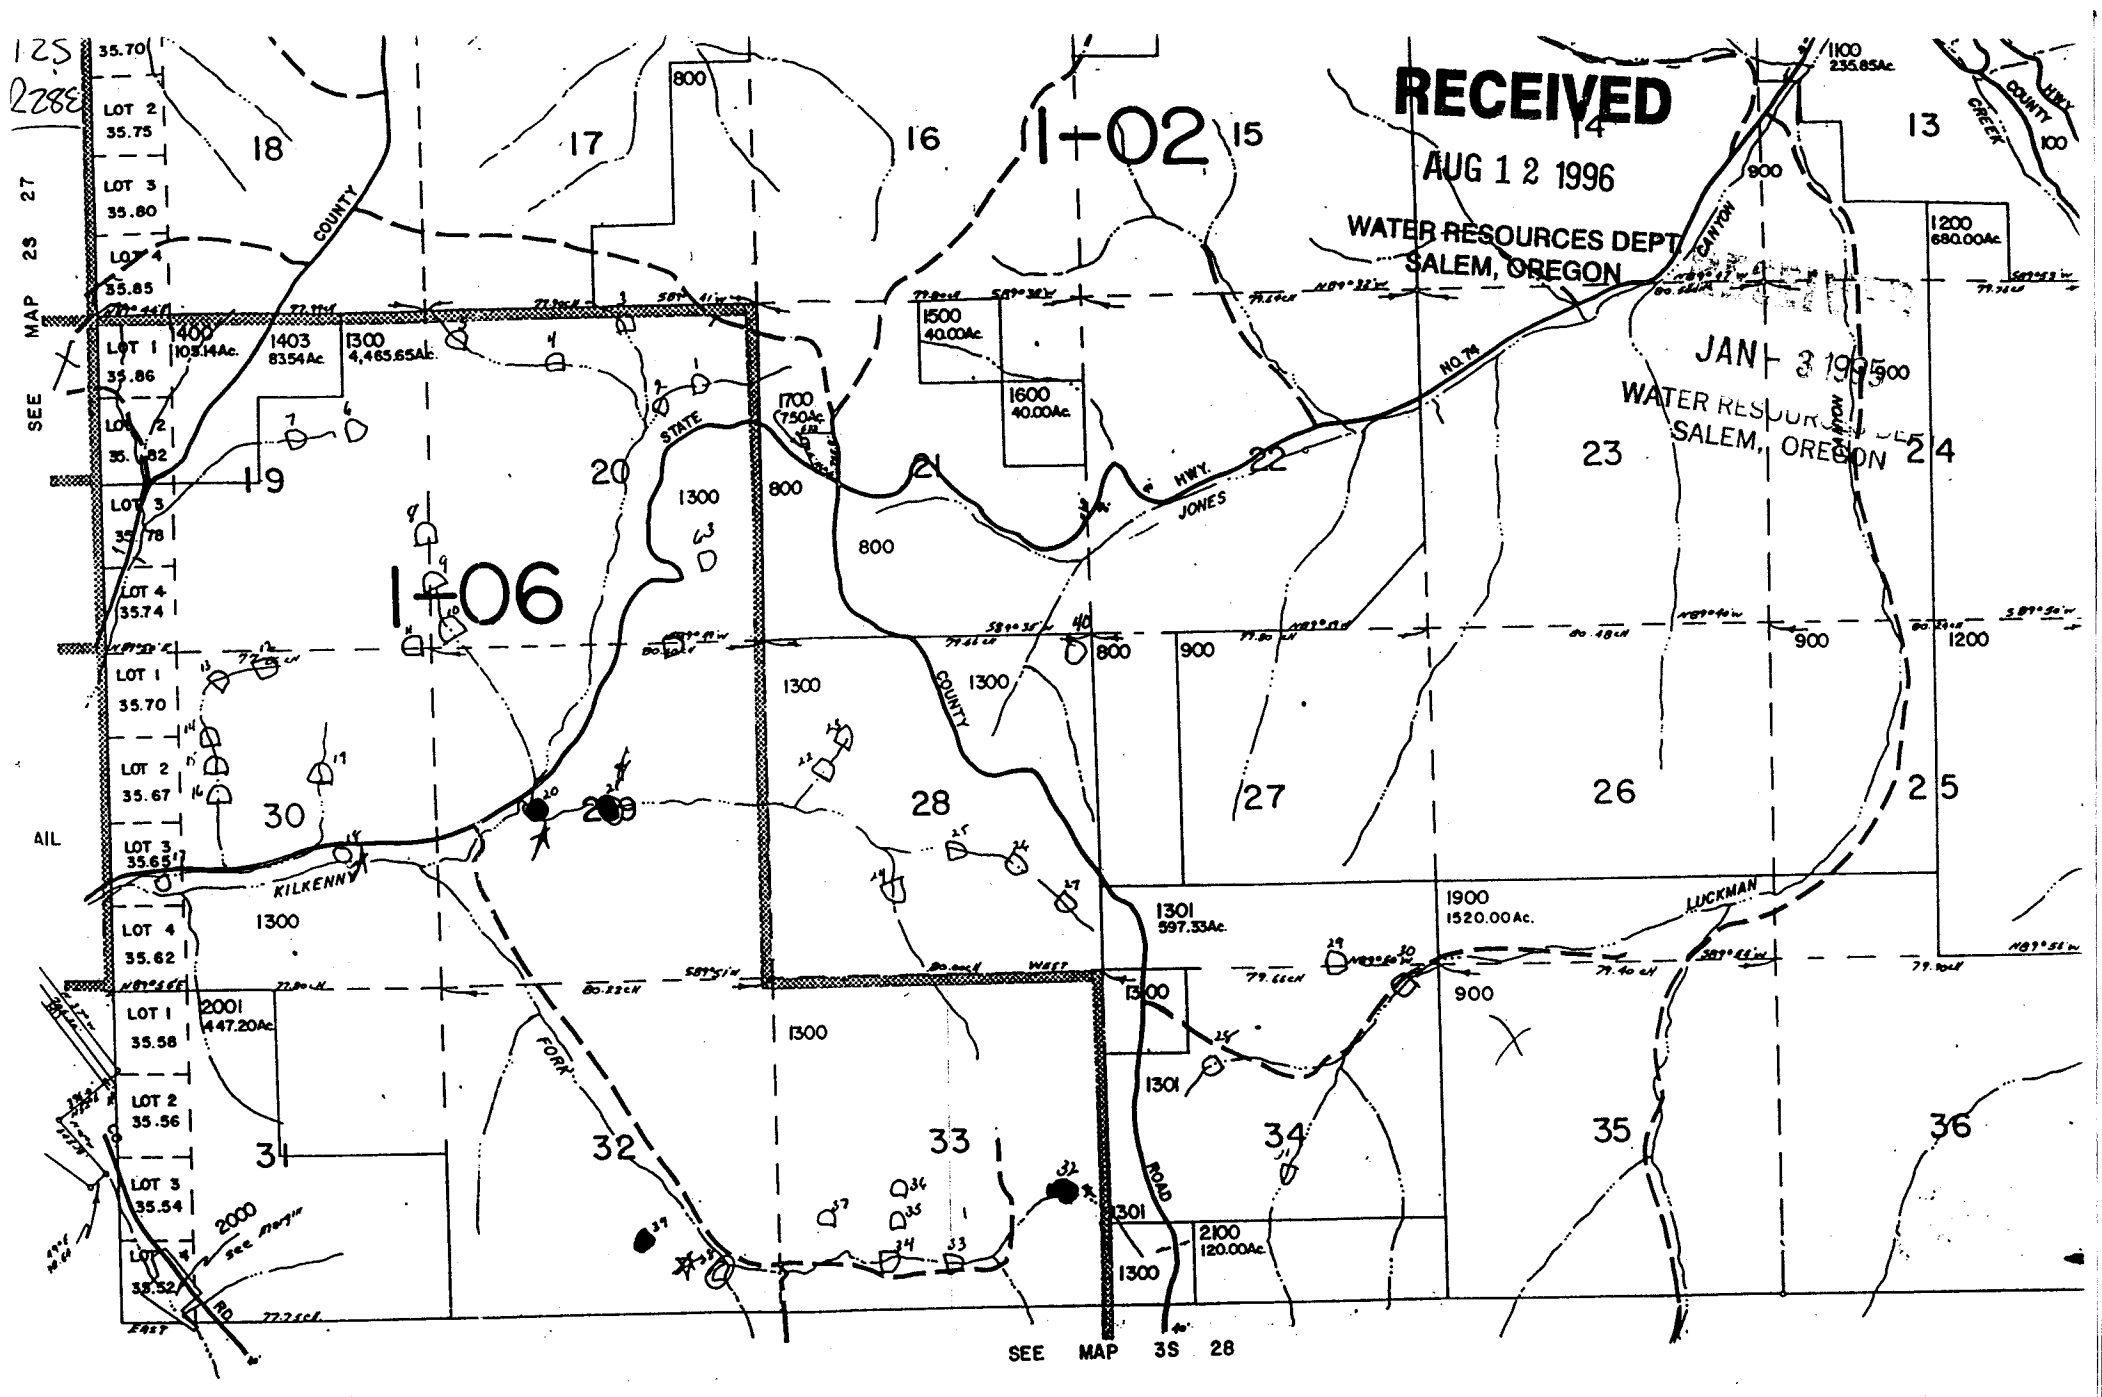

RECEIVED
AUG 12 1996
WATER RESOURCES DEPT
SALEM, OREGON
JAN - 3 1995
WATER RESOURCES DEPT
SALEM, OREGON
I-02
I-06
SEE MAP 23 27
SEE MAP 3S 28
KILKENNY
LUCKMAN
JONES
FORK
ROAD
COUNTY
STATE
HWY.
CANYON
CREEK
LOT 1 35.70
LOT 2 35.75
LOT 3 35.80
LOT 4 35.85
LOT 1 35.86
LOT 2 35.82
LOT 3 35.78
LOT 4 35.74
LOT 1 35.70
LOT 2 35.67
LOT 3 35.65
LOT 4 35.62
LOT 1 35.58
LOT 2 35.56
LOT 3 35.54
LOT 35.52
1403 83.54Ac.
1300 4,465.65Ac.
1700 750Ac.
1500 40.00Ac.
1600 40.00Ac.
1301 597.33Ac.
1900 1520.00Ac.
2001 447.20Ac.
2100 120.00Ac.
1100 235.85Ac.
1200 680.00Ac.
18
17
16
15
14
13
19
20
21
22
23
24
30
29
28
27
26
25
31
32
33
34
35
36

R-81427