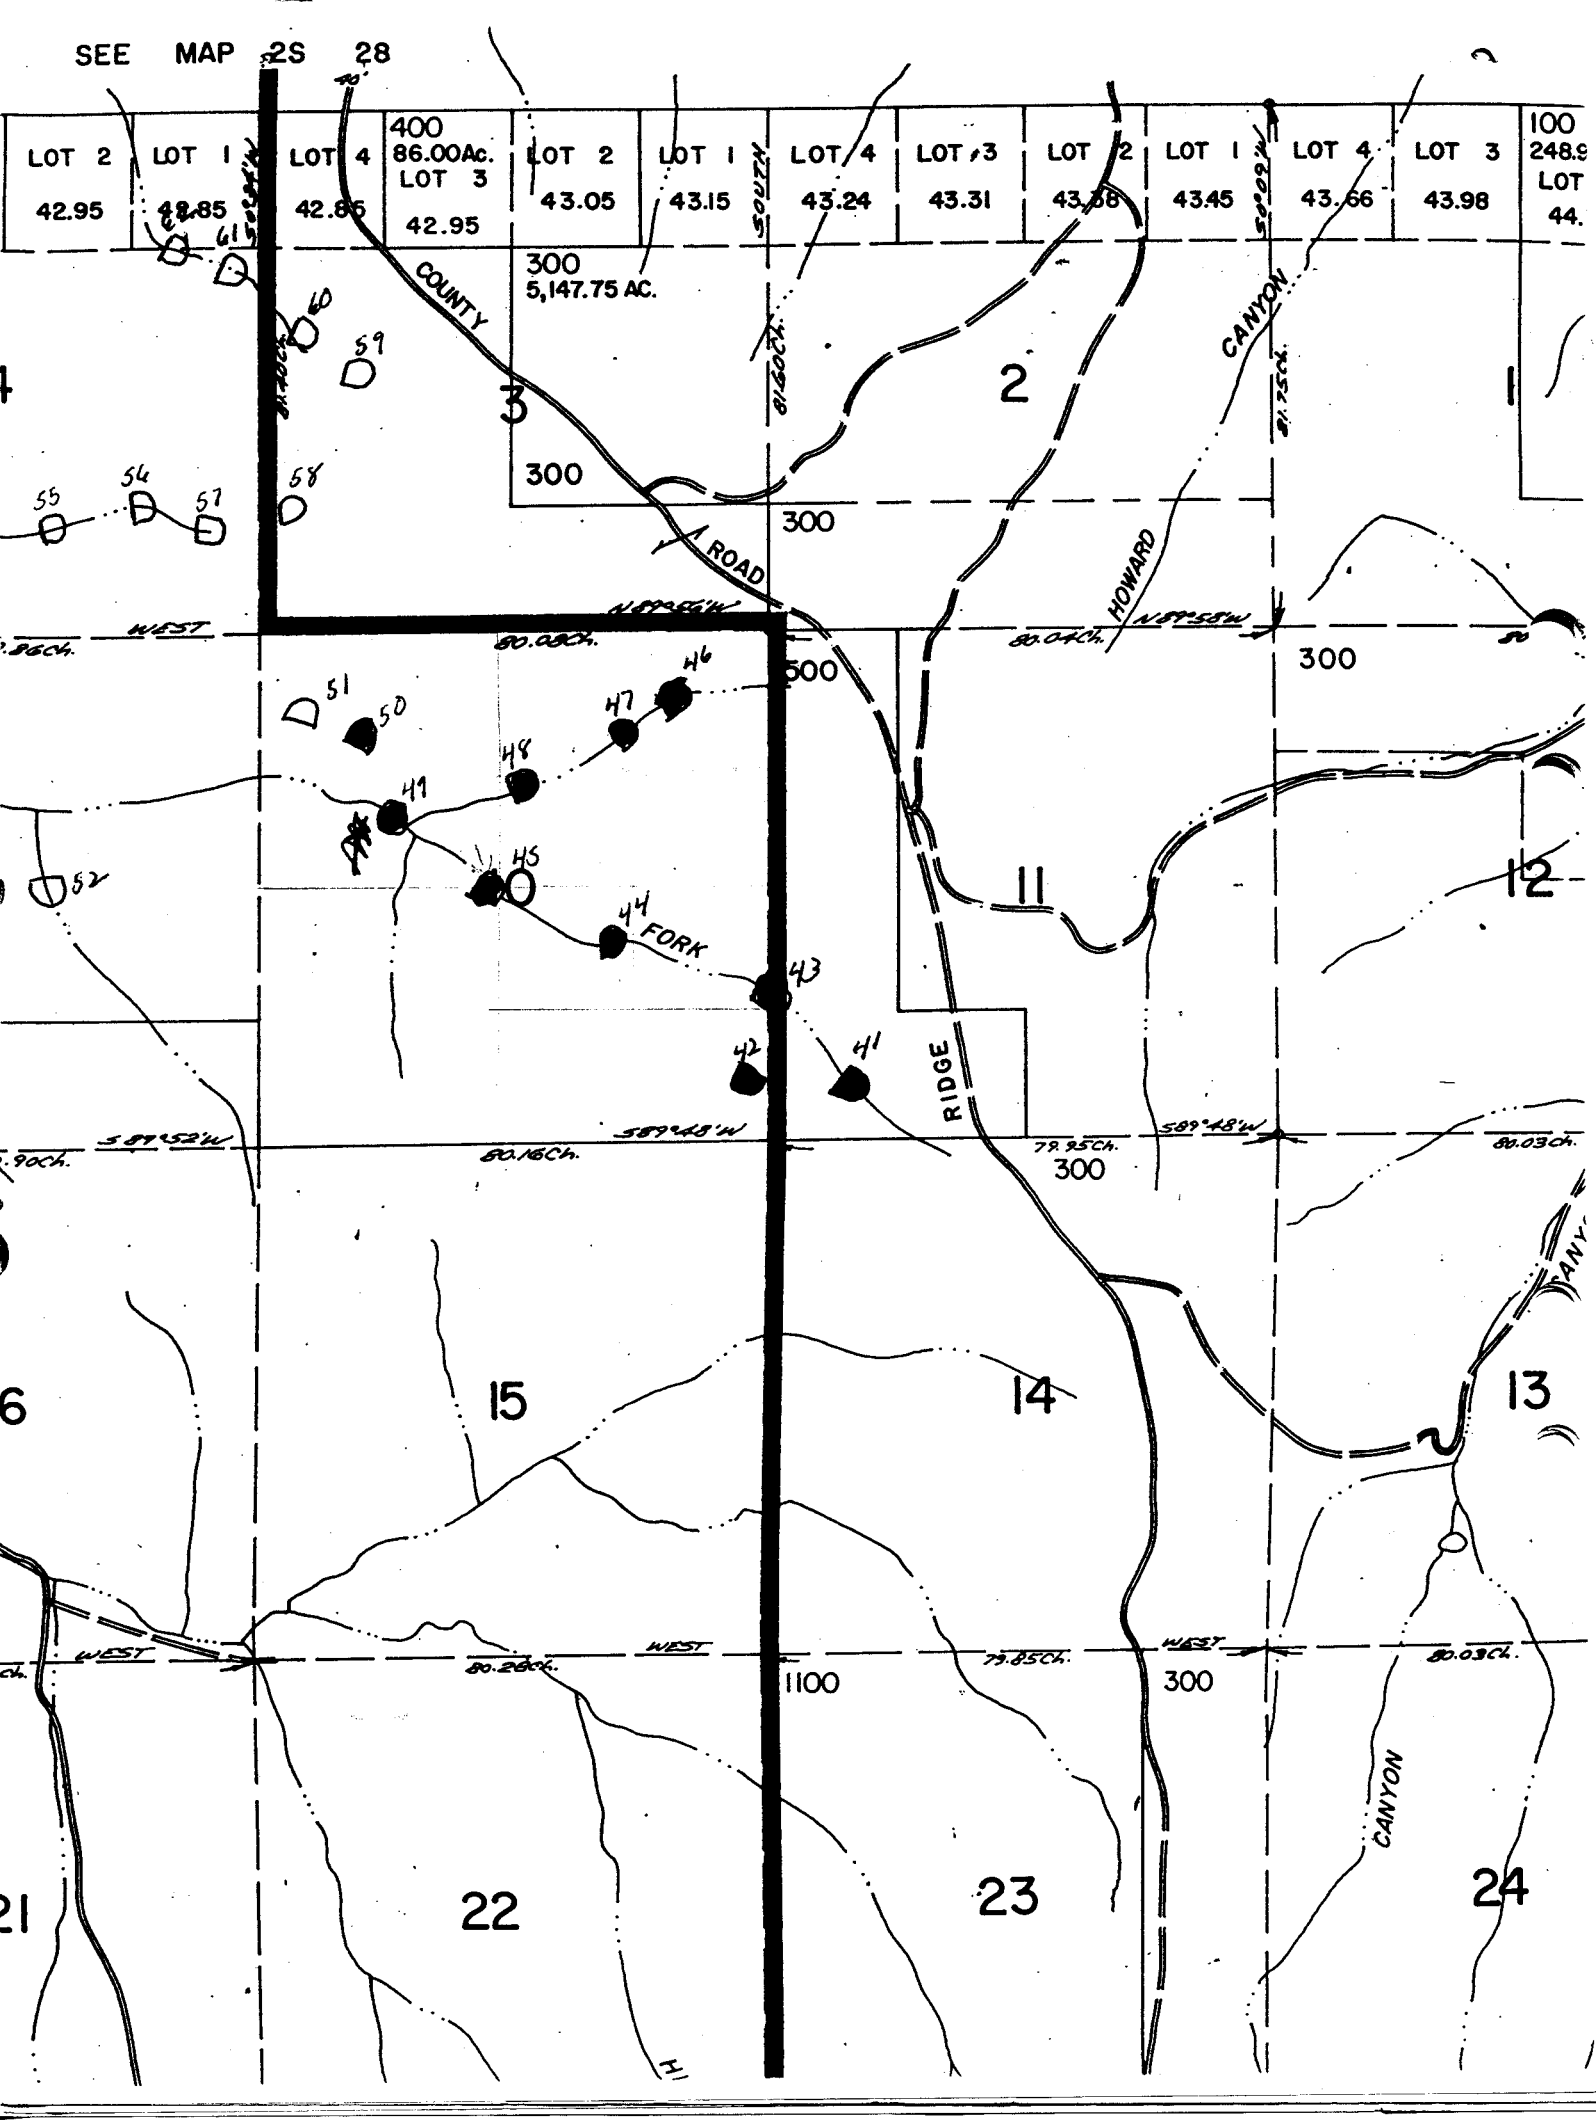

SEE MAP 2S 28
LOT 2 42.95
LOT 1 42.85
LOT 4 42.86
400 86.00Ac. LOT 3 42.95
LOT 2 43.05
LOT 1 43.15
LOT 4 43.24
LOT 3 43.31
LOT 2 43.38
LOT 1 43.45
LOT 4 43.66
LOT 3 43.98
300 5,147.75 AC.
COUNTY ROAD
CANYON
HOWARD
RIDGE
FORK
WEST
80.08Ch.
80.04Ch.
80.16Ch.
79.95Ch.
80.03Ch.
80.26Ch.
79.85Ch.
1100
300
500
2
3
11
12
13
14
15
22
23
24