


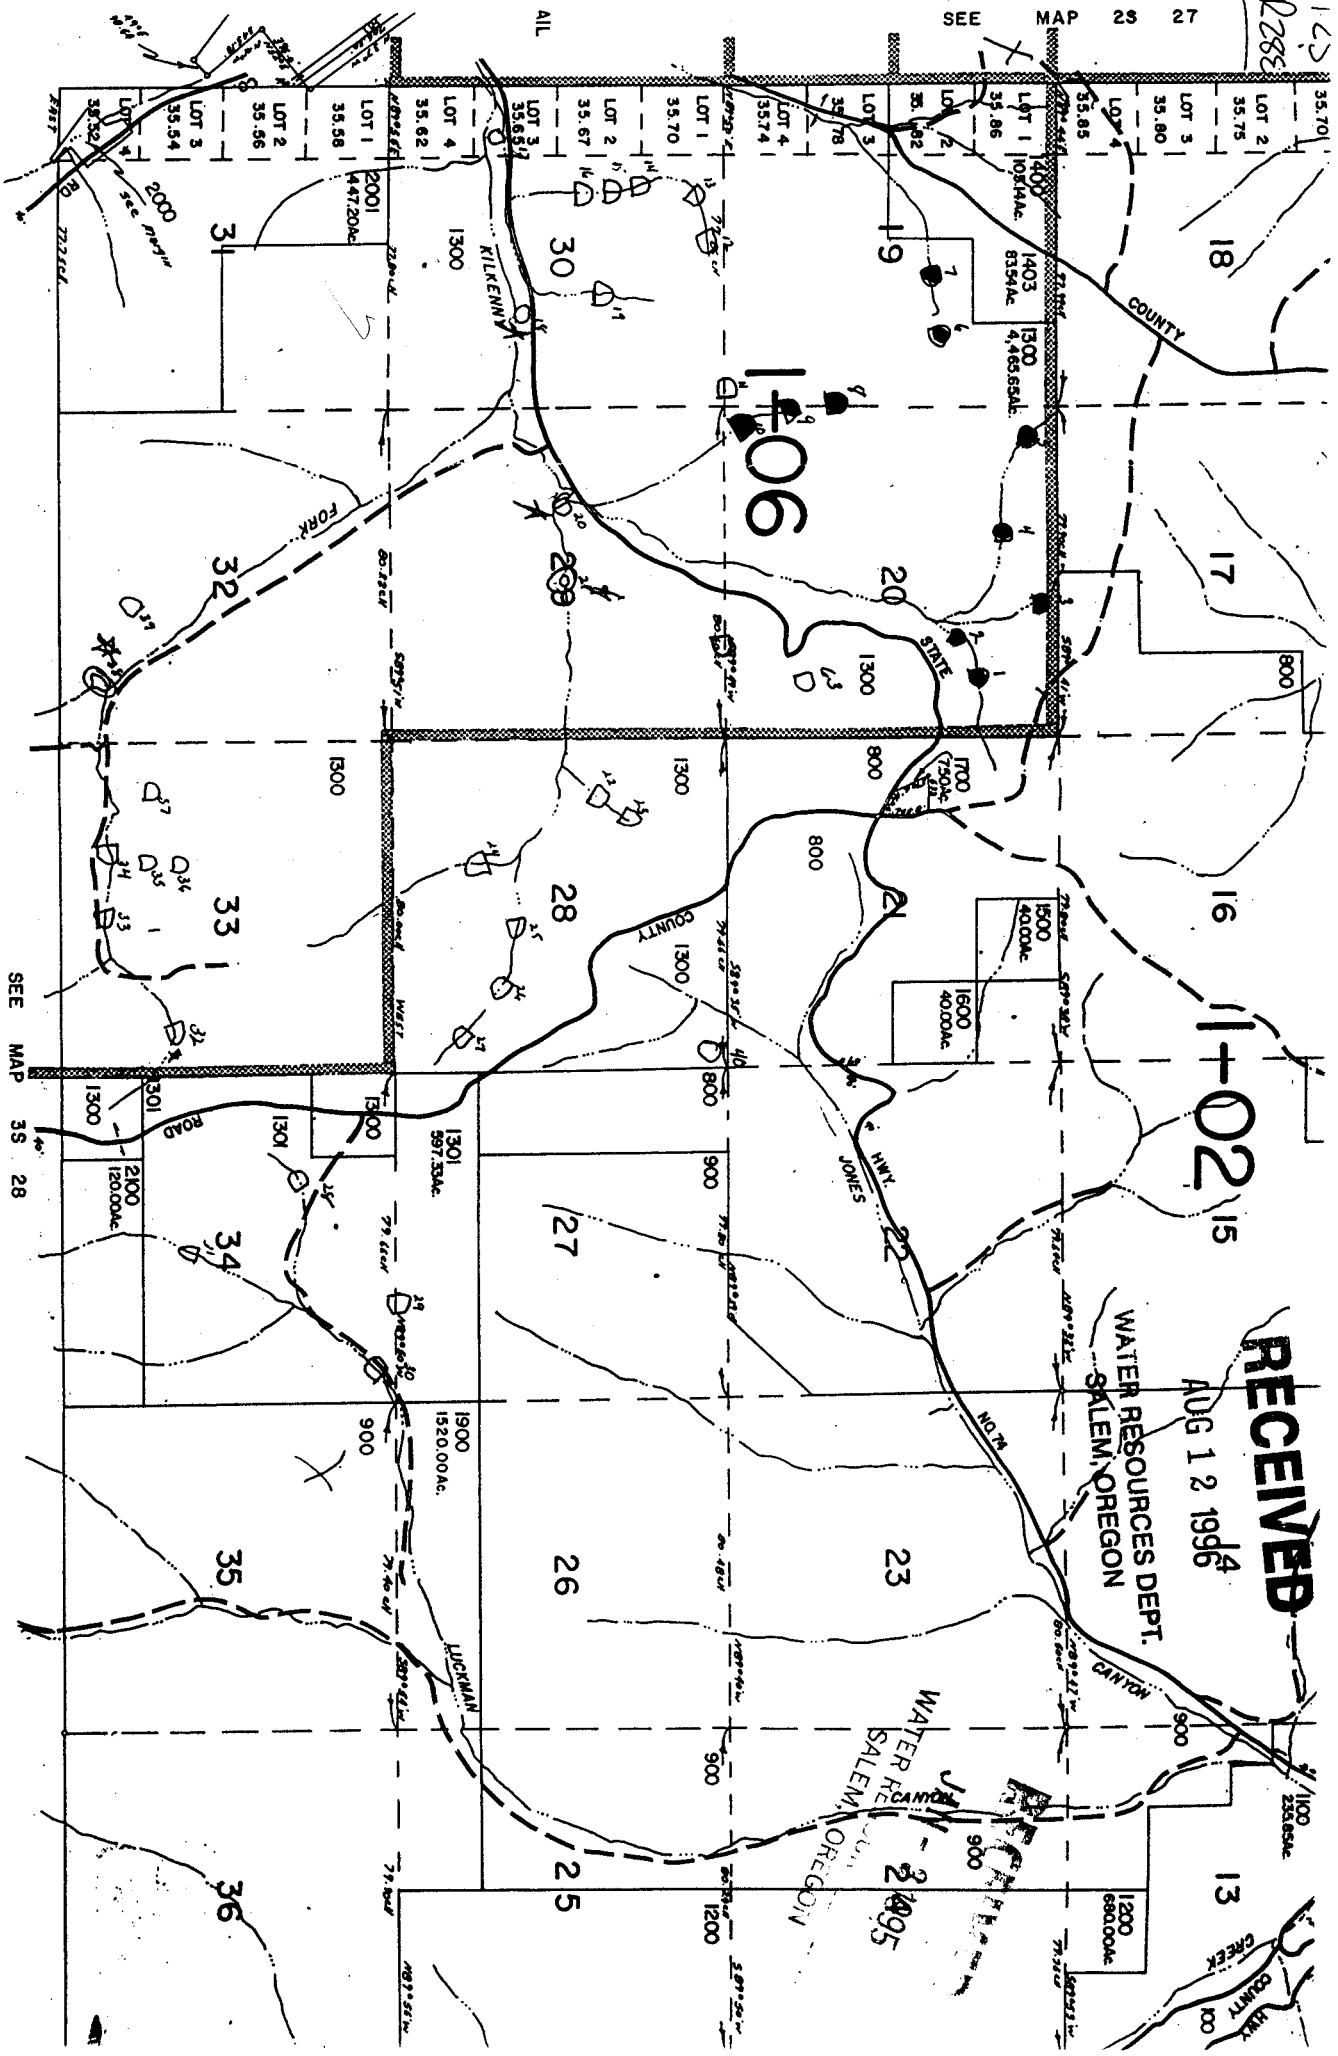

RECEIVED

AUG 12 1964

WATER RESOURCES DEPT.
SALEM, OREGON

WATER RE
SALEM, OREGON
JAN - 2 1995

R-81432