


R-81433

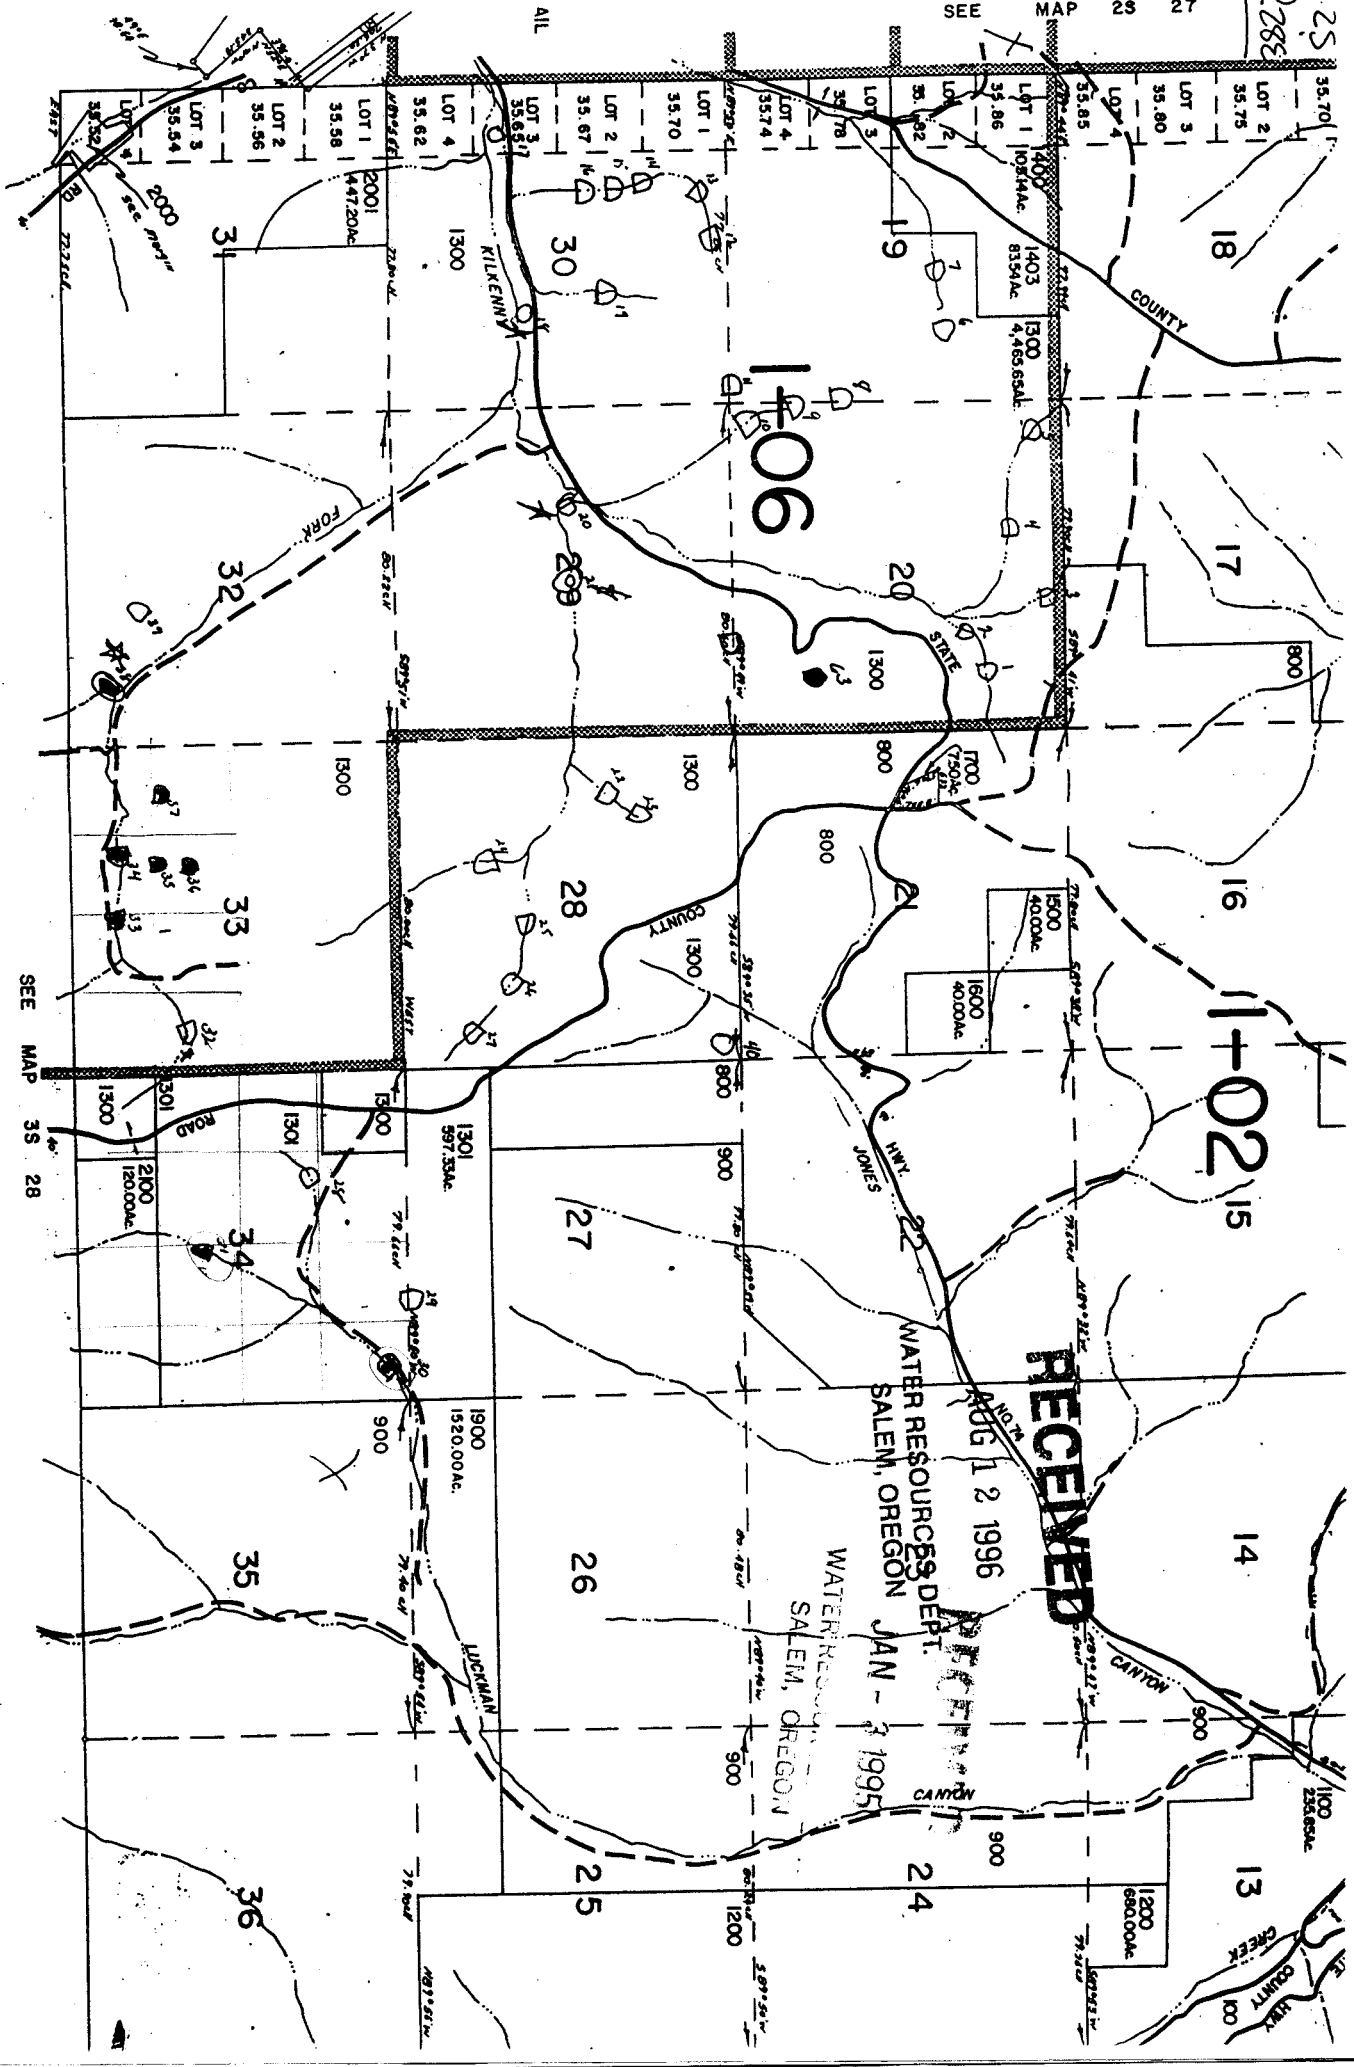

RECEIVED

WATER RESOURCES
SALEM, OREGON

WATER RESOURCES
SALEM, OREGON

JAN - 3 1995

SEE MAP 2S 28



KILKENNY ROAD


1-06

16 15 14 21 22 23

53 54 55 