

1"=400'


SEE MAP 4S 10 14

THIS SKETCH IS MADE SOLELY FOR THE PURPOSE OF ASSISTING IN LOCATING SAID PREMISES, AND THE COMPANY ASSUMES NO LIABILITY FOR VARIATION, IF ANY, IN DIMENSIONS AND LOCATIONS ASCERTAINED BY ACTUAL SURVEY.

THIS PLOT PLAN IS COURTESY OF

300 FIRST AMERICAN TITLE INSURANCE COMPANY OF OREGON

N 1/4

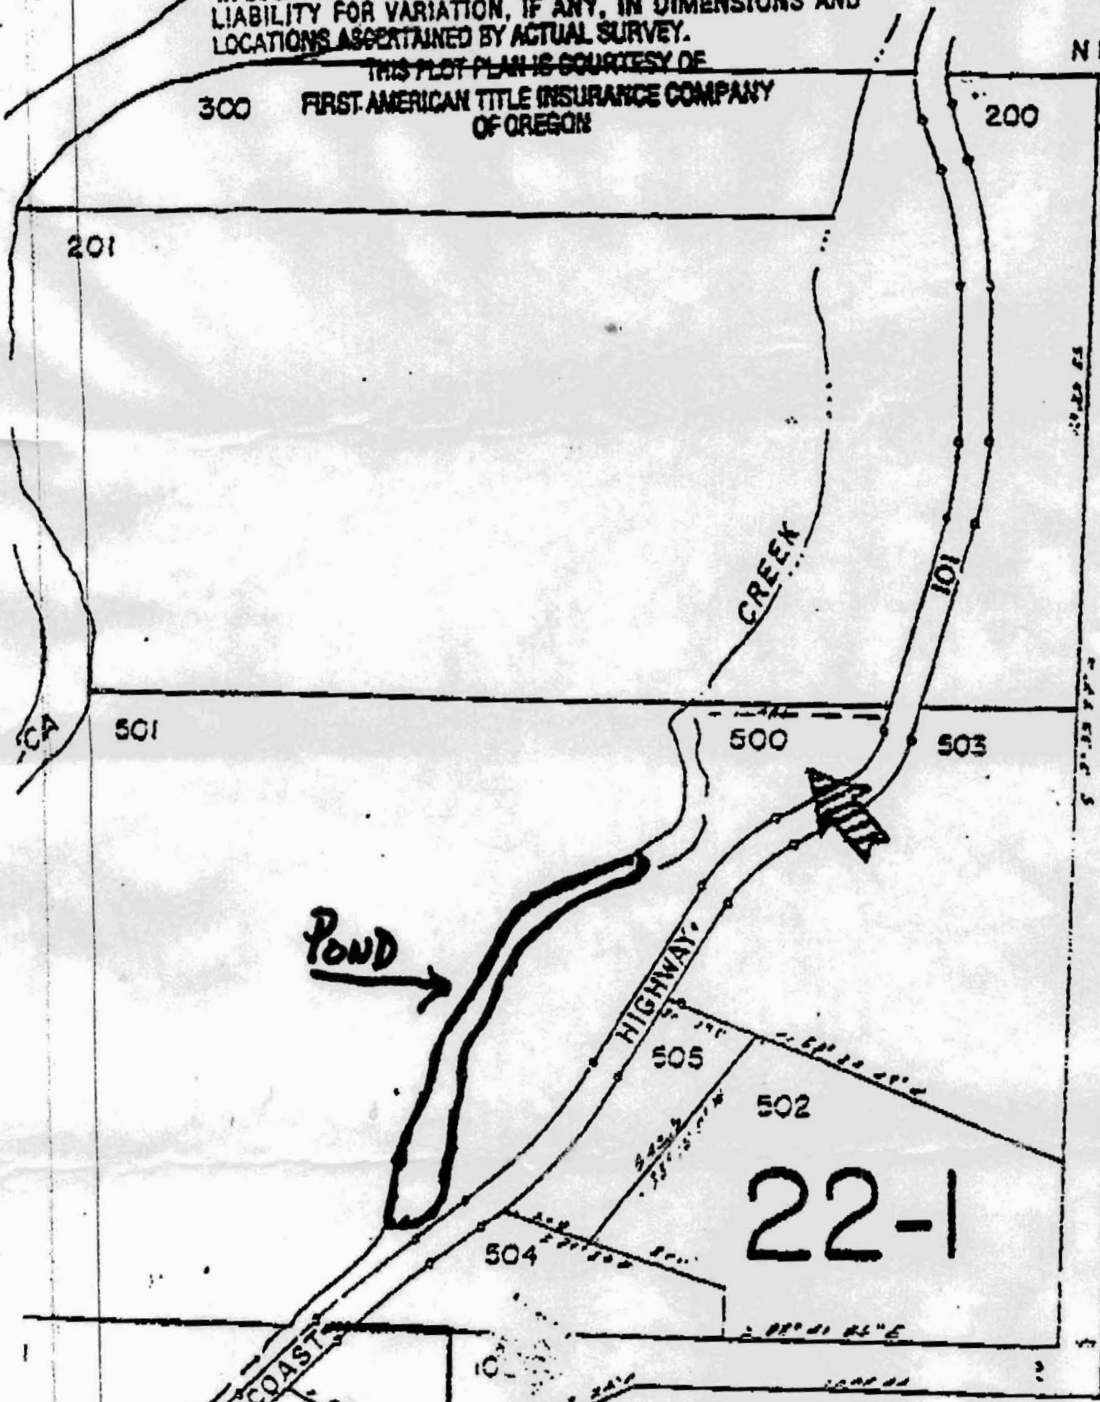

RECEIVED

AUG - 7 1996

WATER RESOURCES DEPT. SALEM, OREGON

RECEIVED

AUG 23 1996

WATER RESOURCES DEPT. SALEM, OREGON

22-1

SEE MAP

Application No. R-8160
Permit No.