T.01N. R.45E. W.M.
WALLOWA COUNTY

01N 45

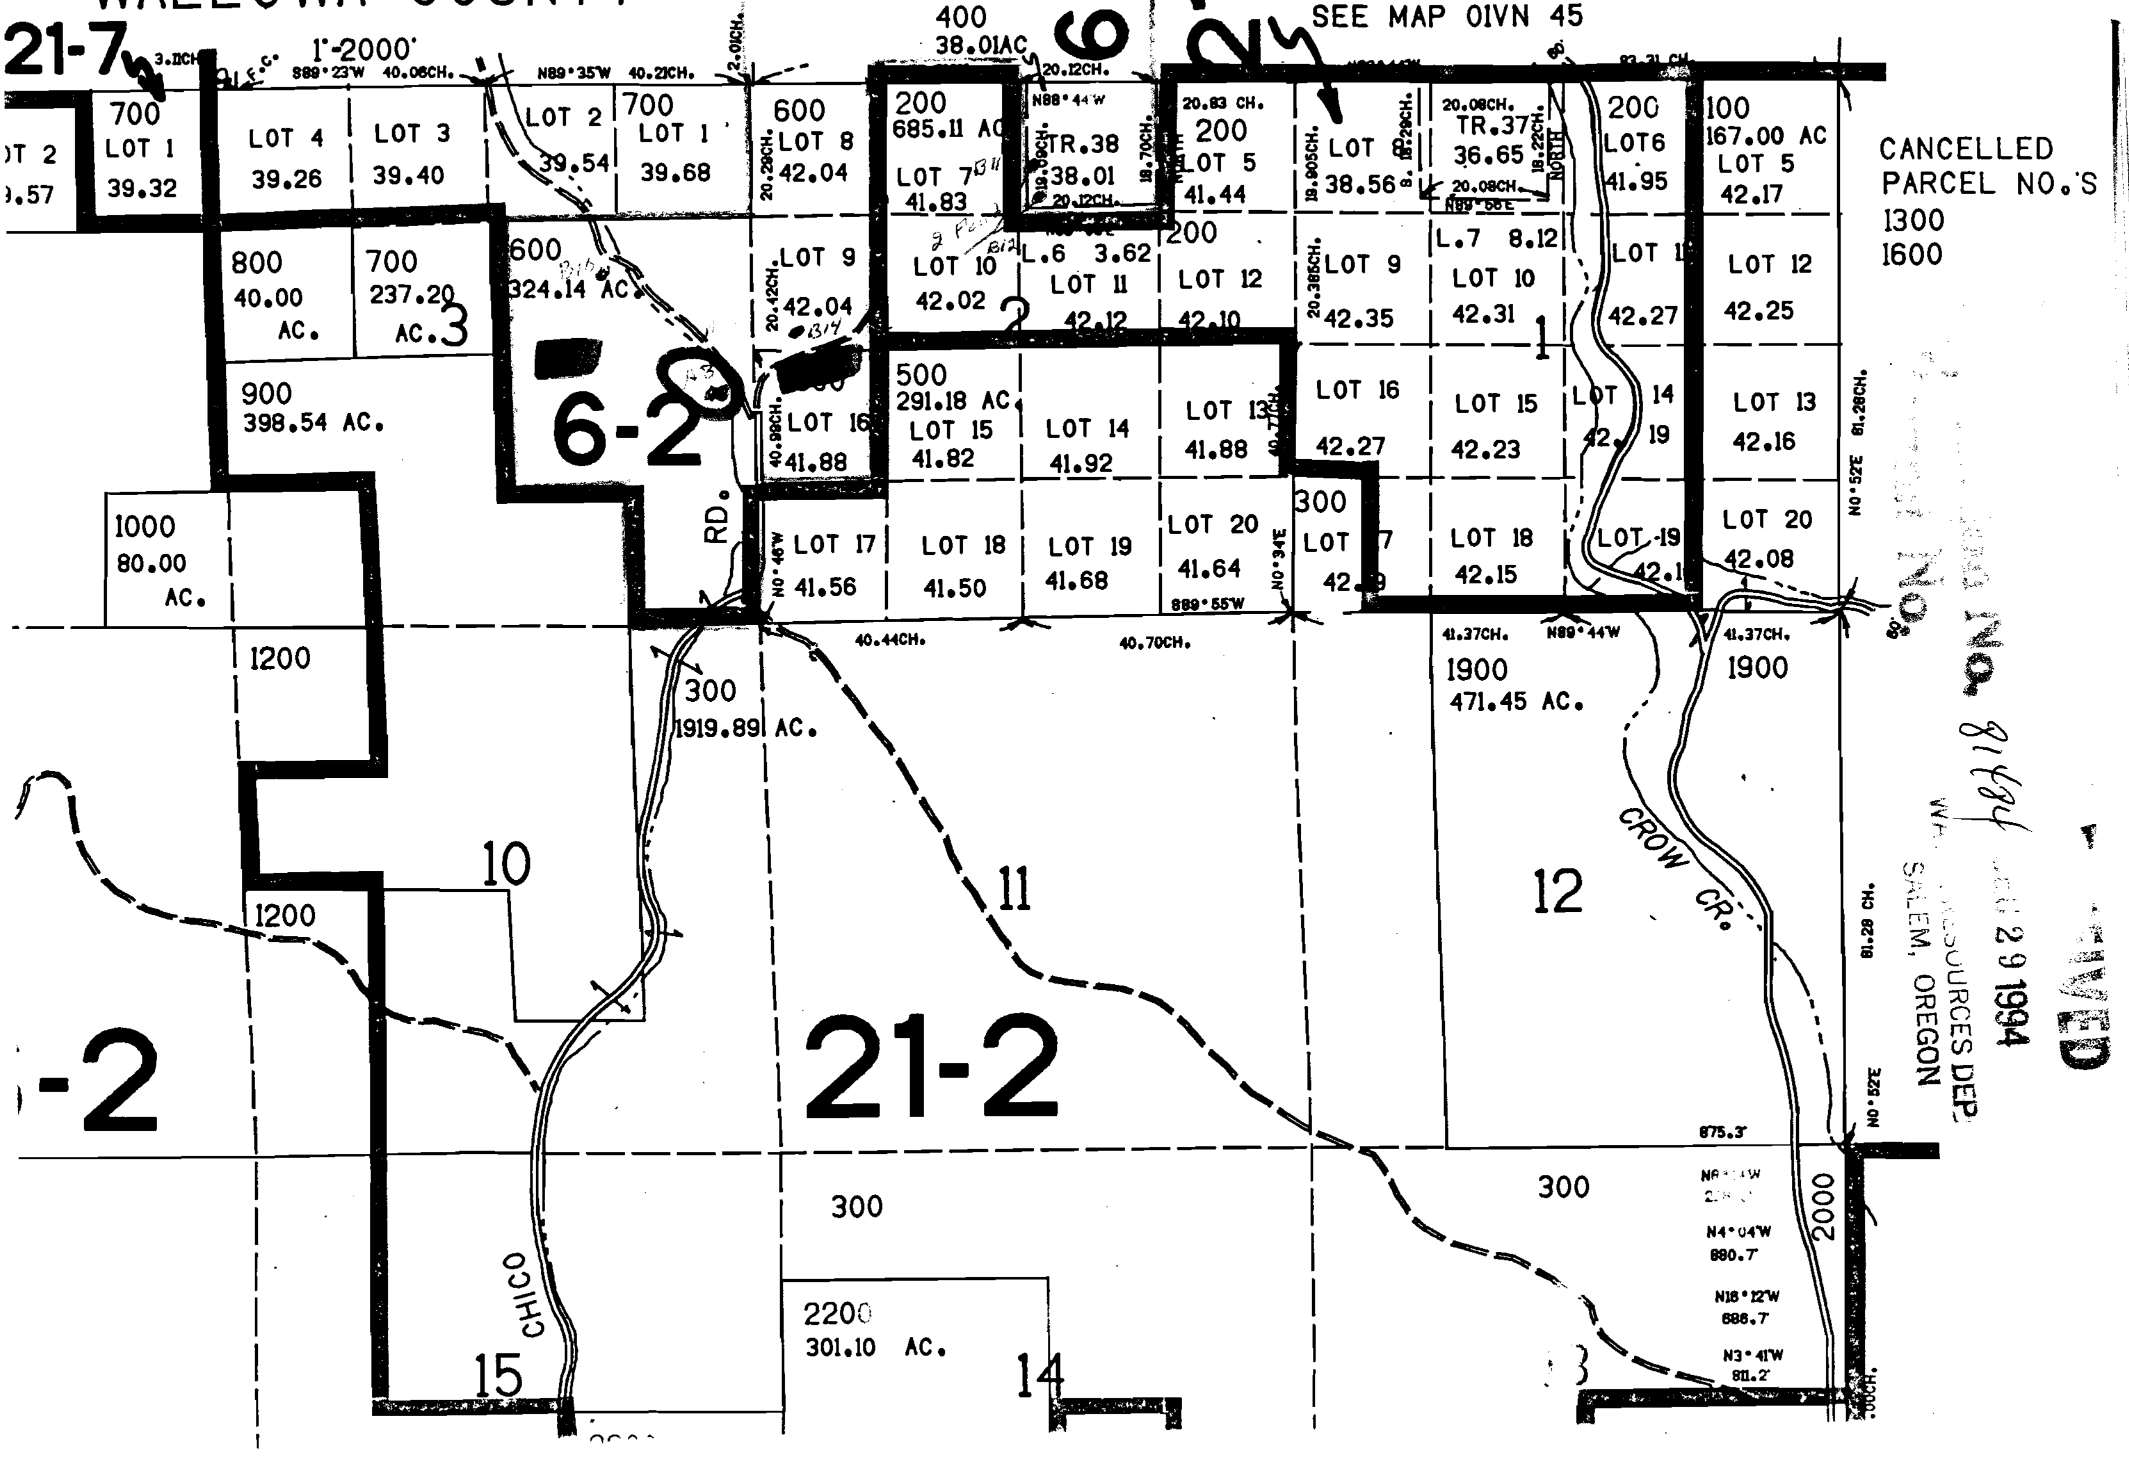

CANCELLED
PARCEL NO.S
1300
1600

RECEIVED
JUL 29 1994
WATER RESOURCES DEPT.
SALEM, OREGON


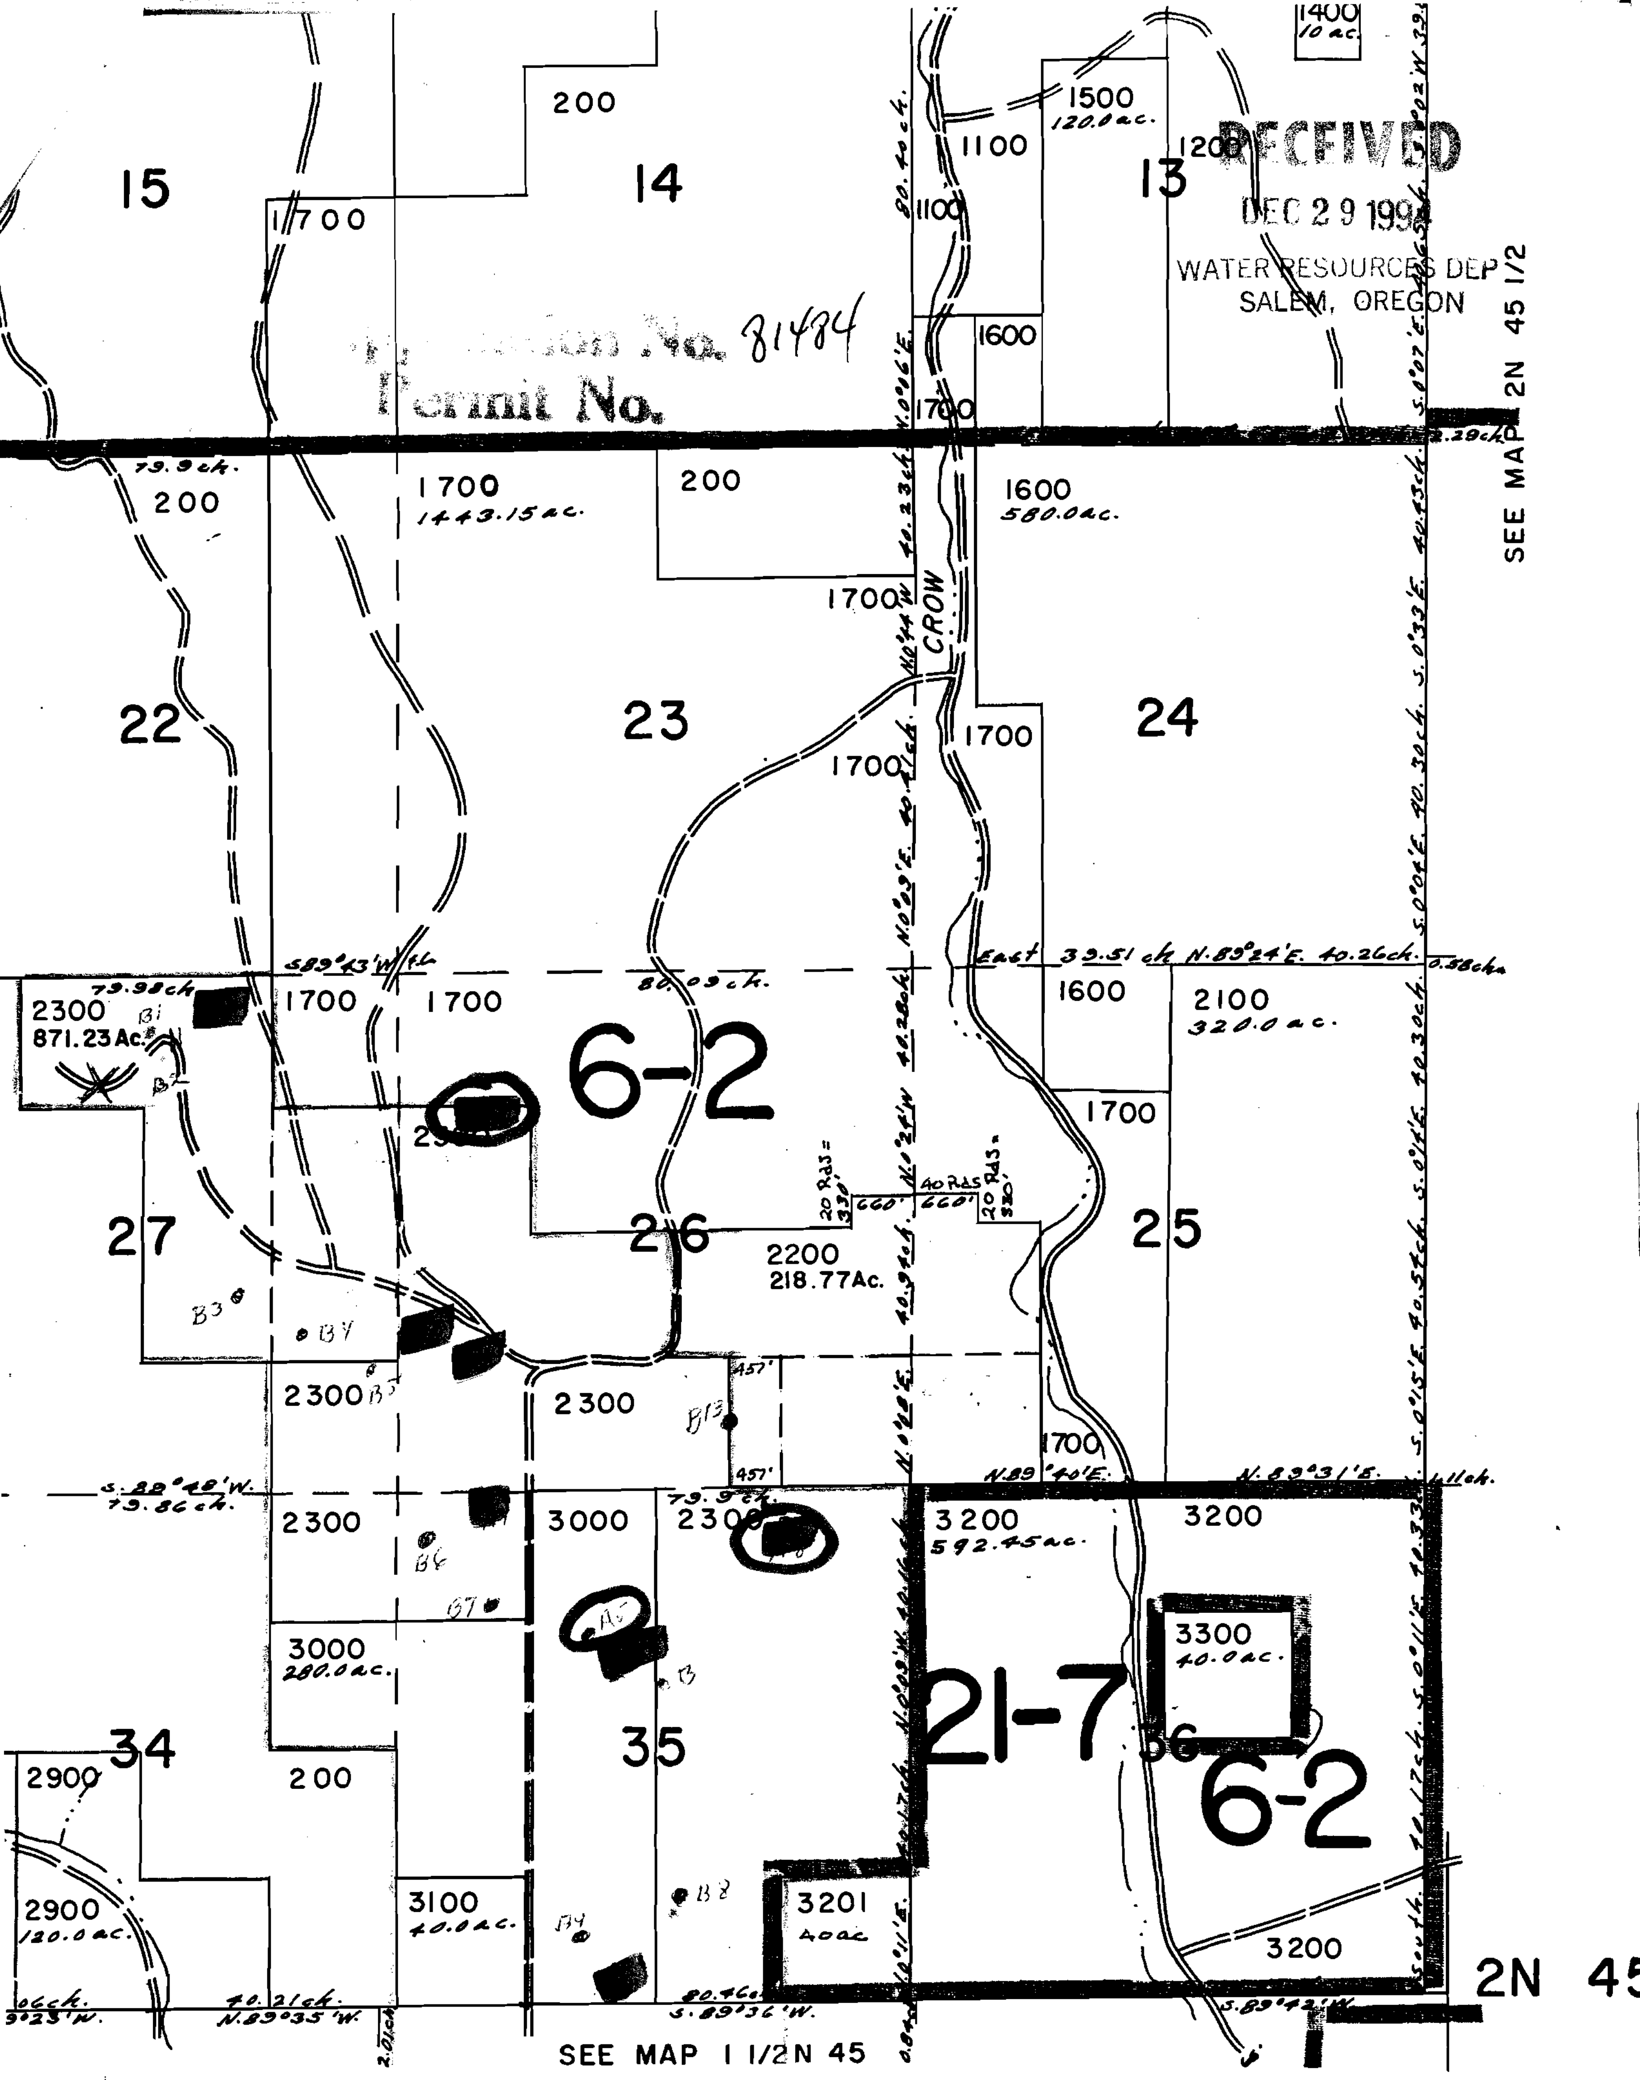

RECEIVED
DEC 29 1994
WATER RESOURCES DEPT
SALEM, OREGON

Application No. 81484
Permit No.