


Application No. R-81578
Permit No.

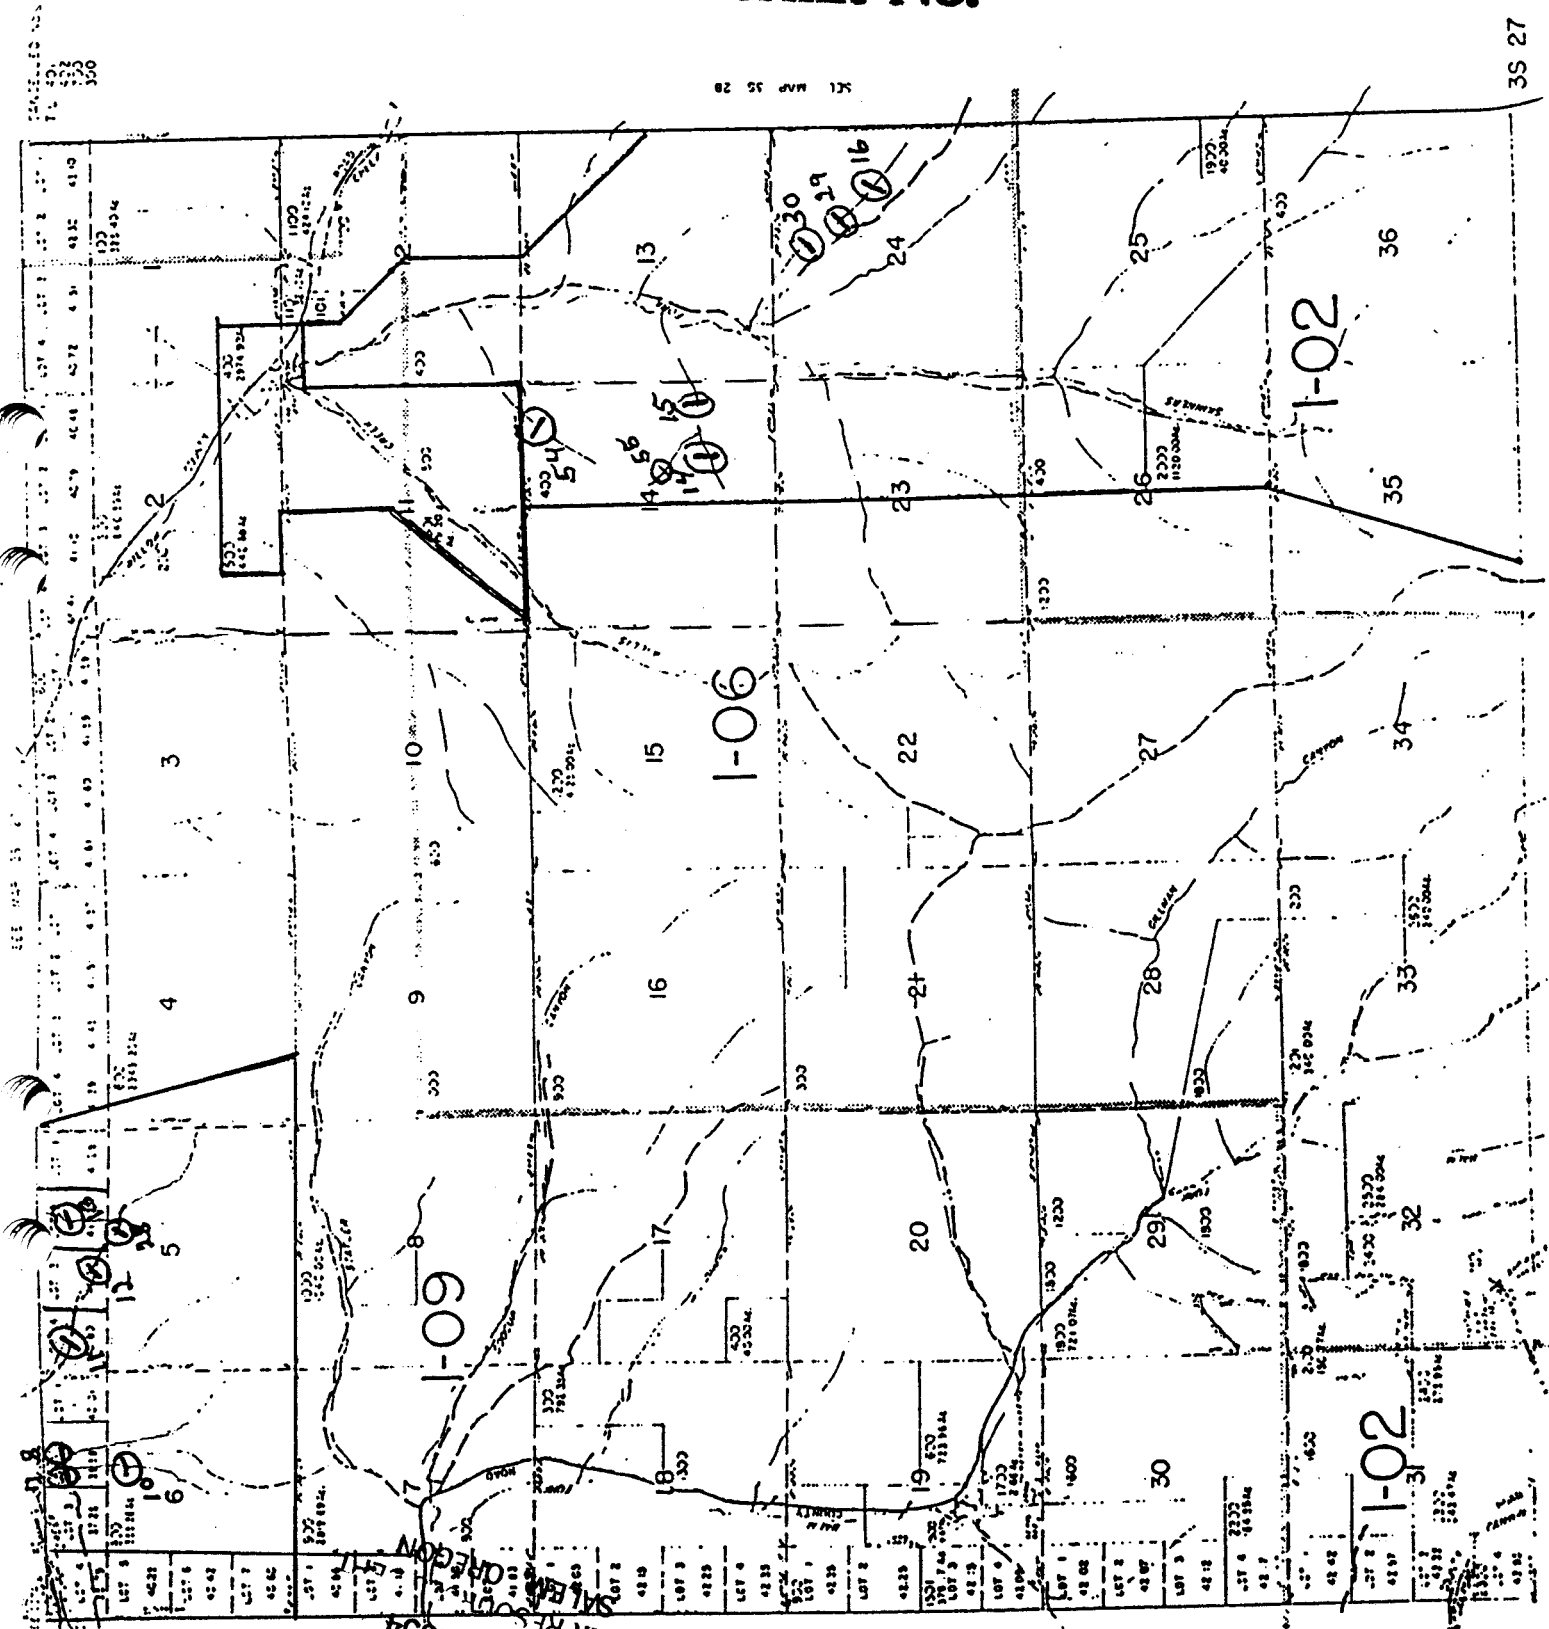

Bonds #:
7, 8, 10, 11, 12, 13
14, 15, 16, 20, 29,
30, 5, 155

RECEIVED
DEC 30 1994
WATER RESOUR

3527E

SEC 19
PARCEL 1900

SEC 30
PARCEL 1900

SEE MAP 35 26


511 MAR 35 26

35 27

Ponds #:
 17, 18, 19, 20, 21,
 22, 23, 24, 31, 32,
 33, 34, 35, 36,
 37, 38, 39, 40, 41
 42, 43, 44, 45, 46
 47, 48, 49, 50, 51
 62, 63, 66

RECEIVED
 DEC 30 1994
 WATER RESOURCES
 SALEM

3528E

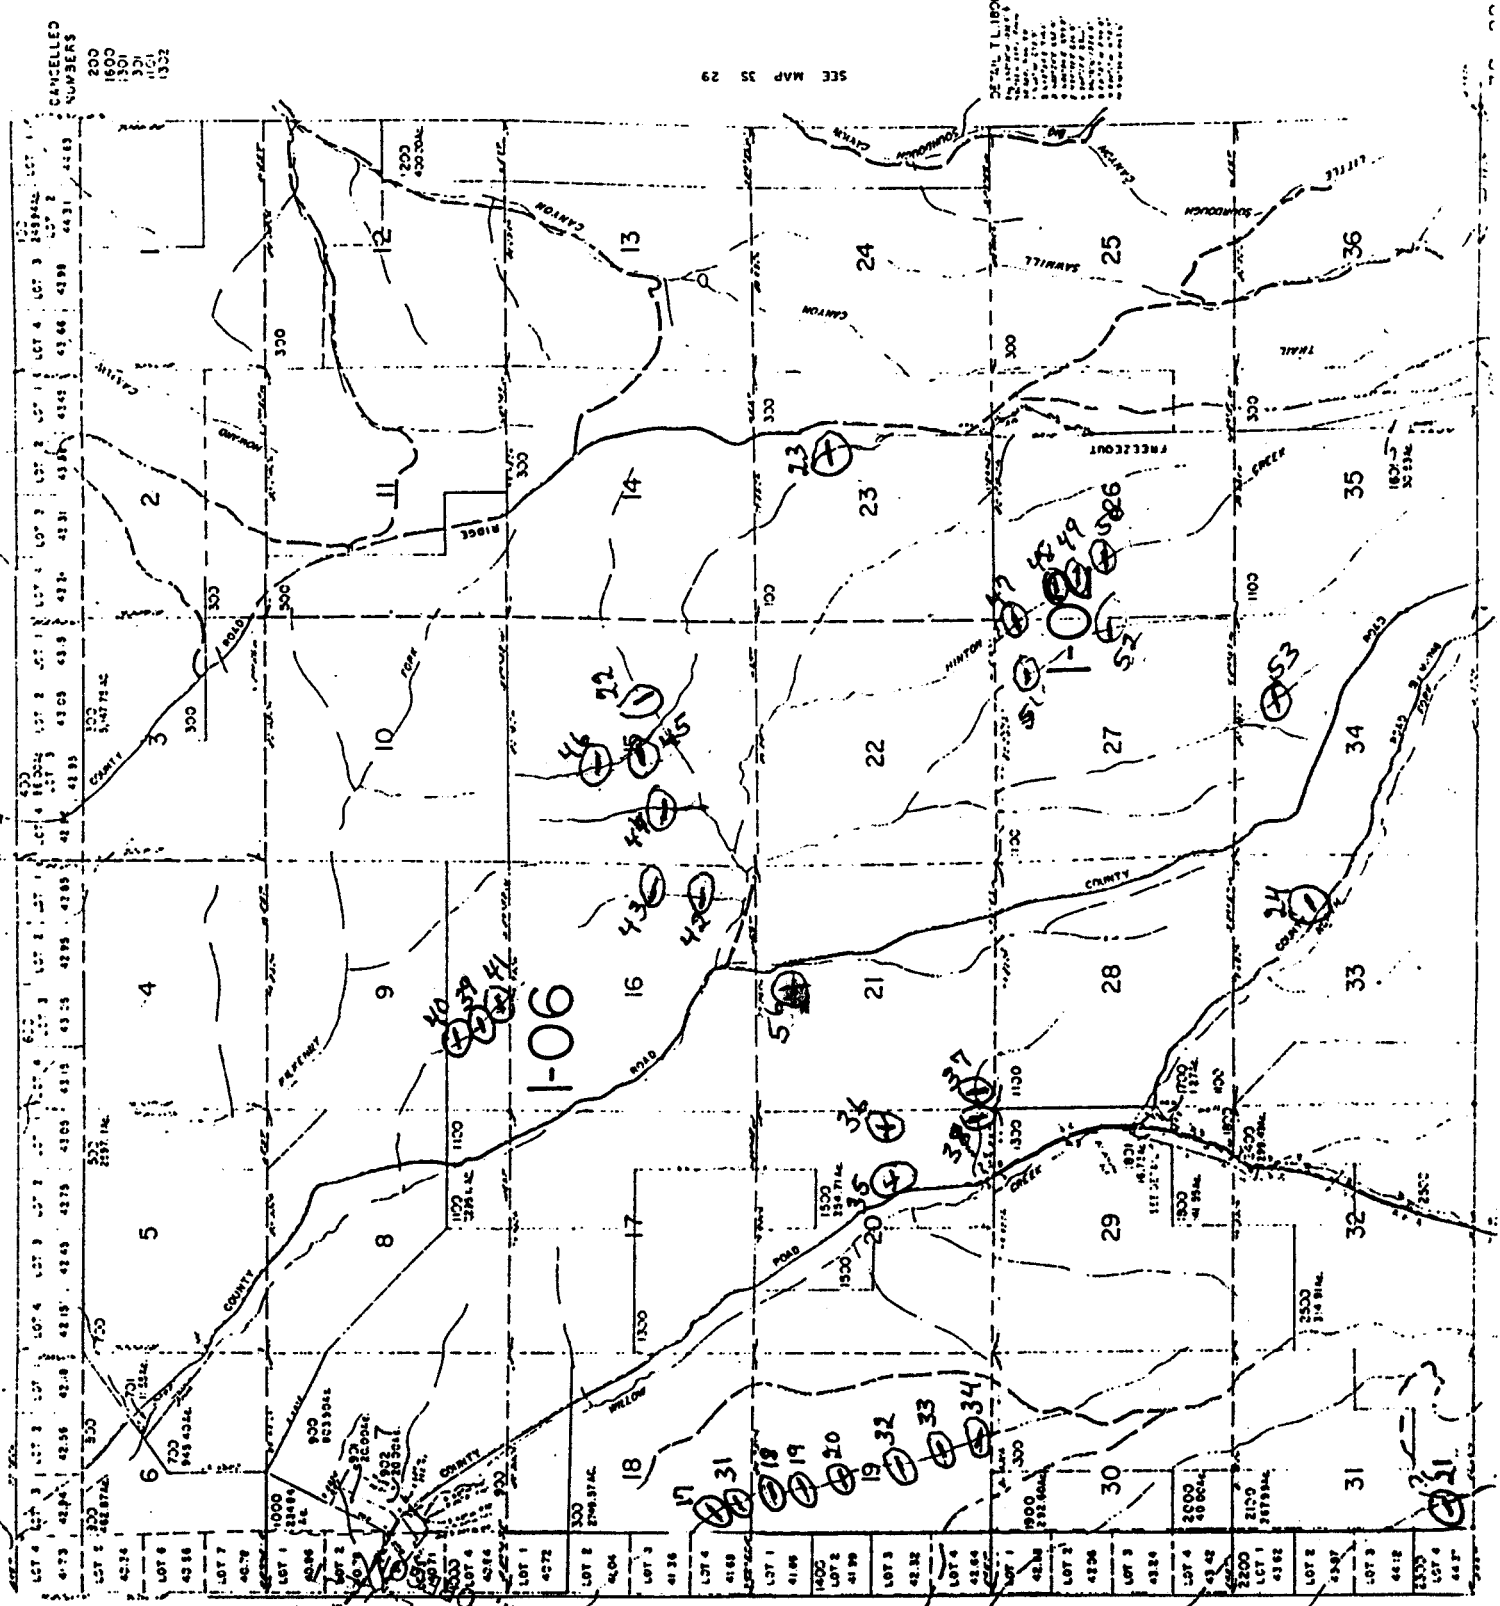

CANCELLED
 NUMBERS
 200
 1600
 1500
 1300
 1323

SEE MAP 35 29

DETAIL T. 1180


Order #: 25, 26, 27

RECEIVED


DEC 30 1994

WATER RESOURCES DEPT. SALEM, OREGON

4528 E

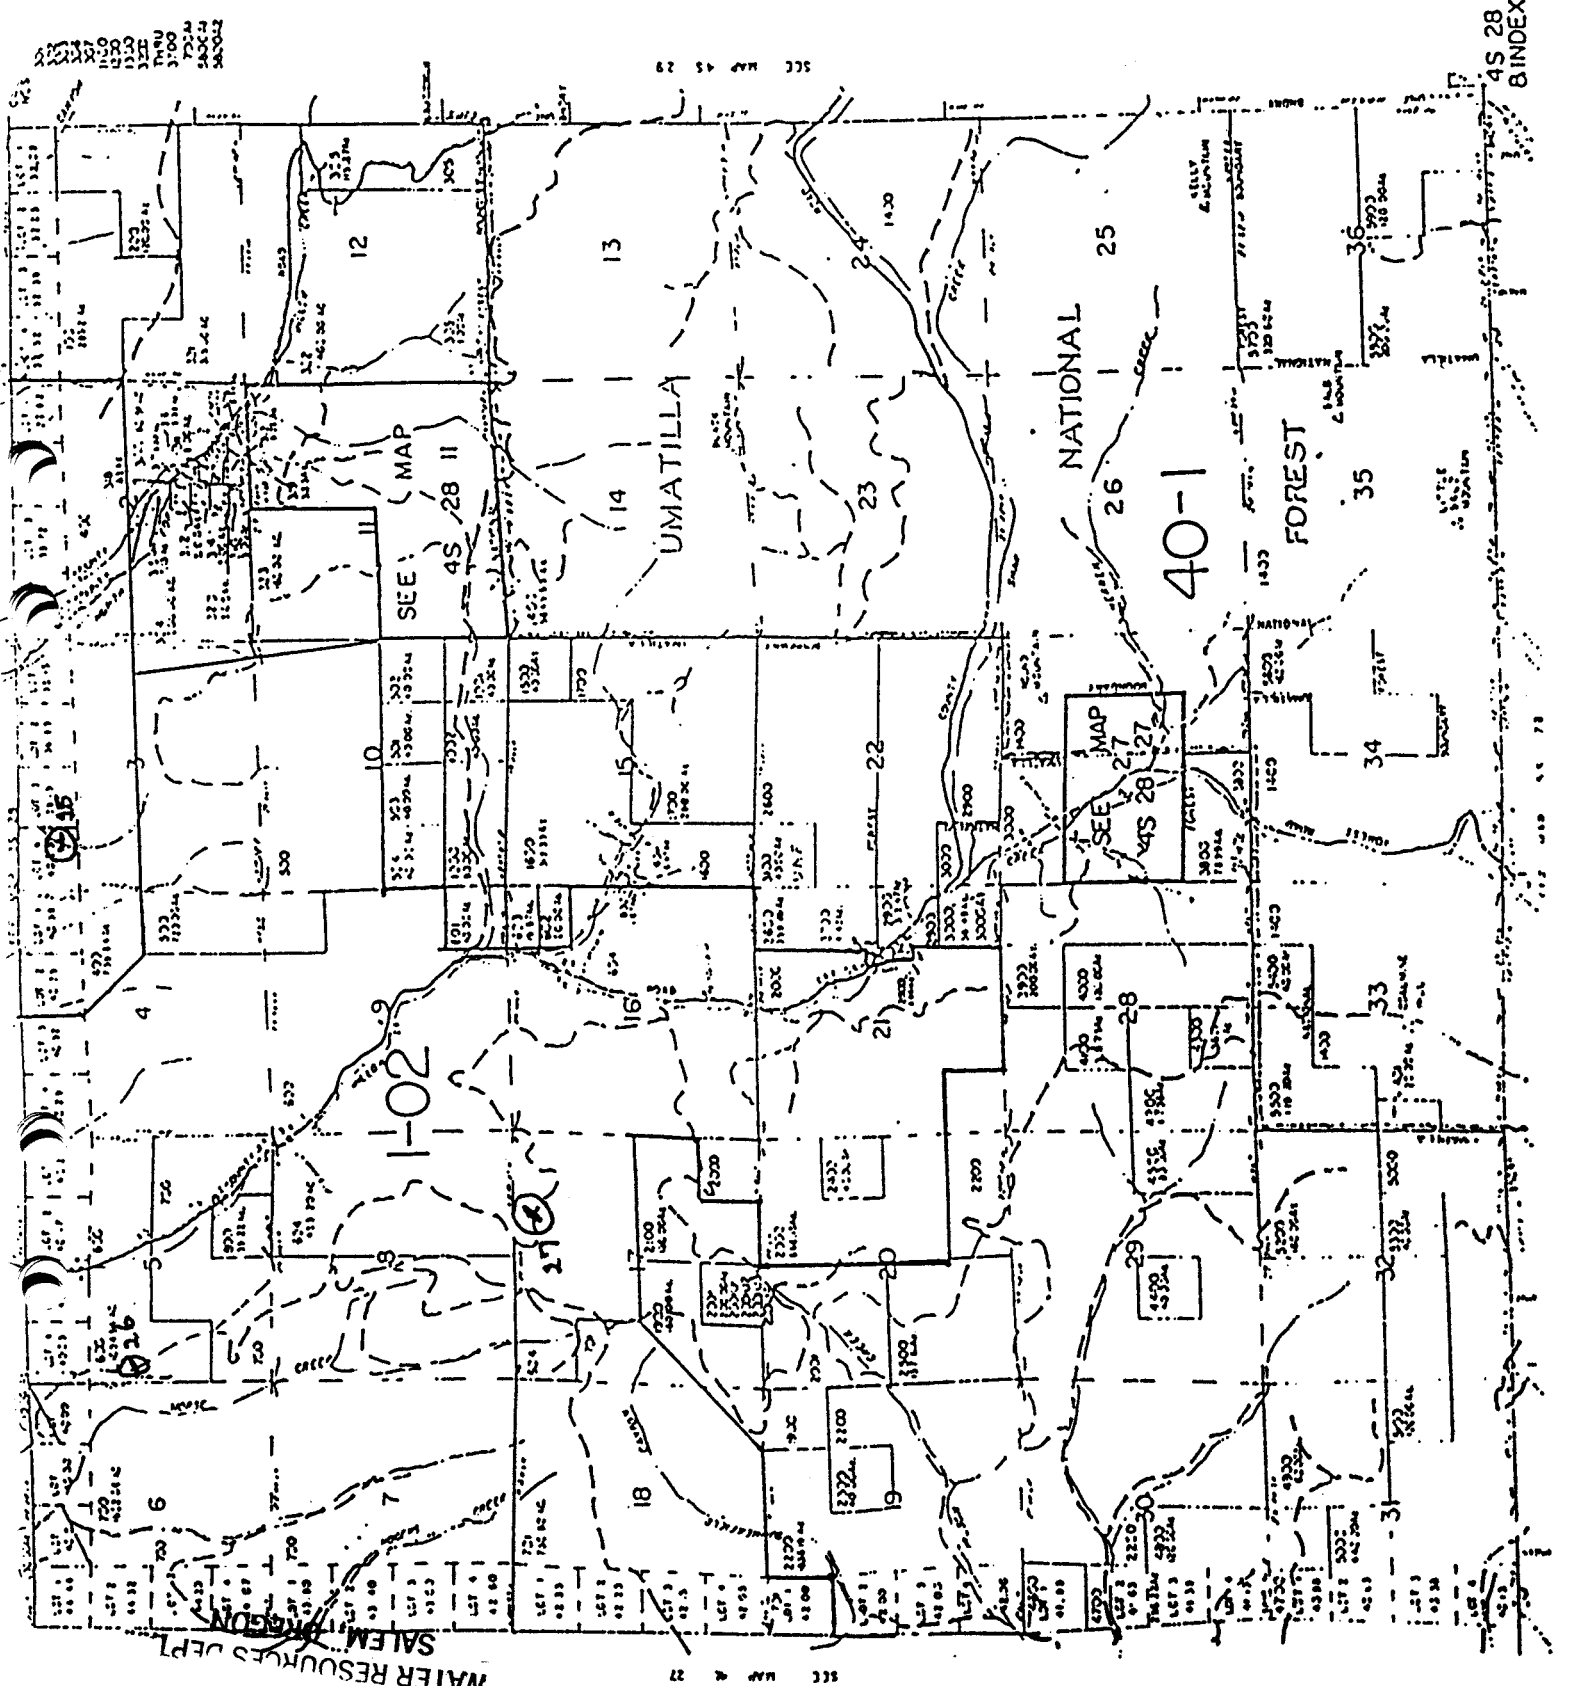

RECEIVED
 DEC 30 1994
 WATER RESOURCES DEPT.
 SALEM, OREGON
 35291E
 Books #: 7, 8, 10, 11, 12, 13, 14, 15, 16, 28, 29, 30, 54, 55

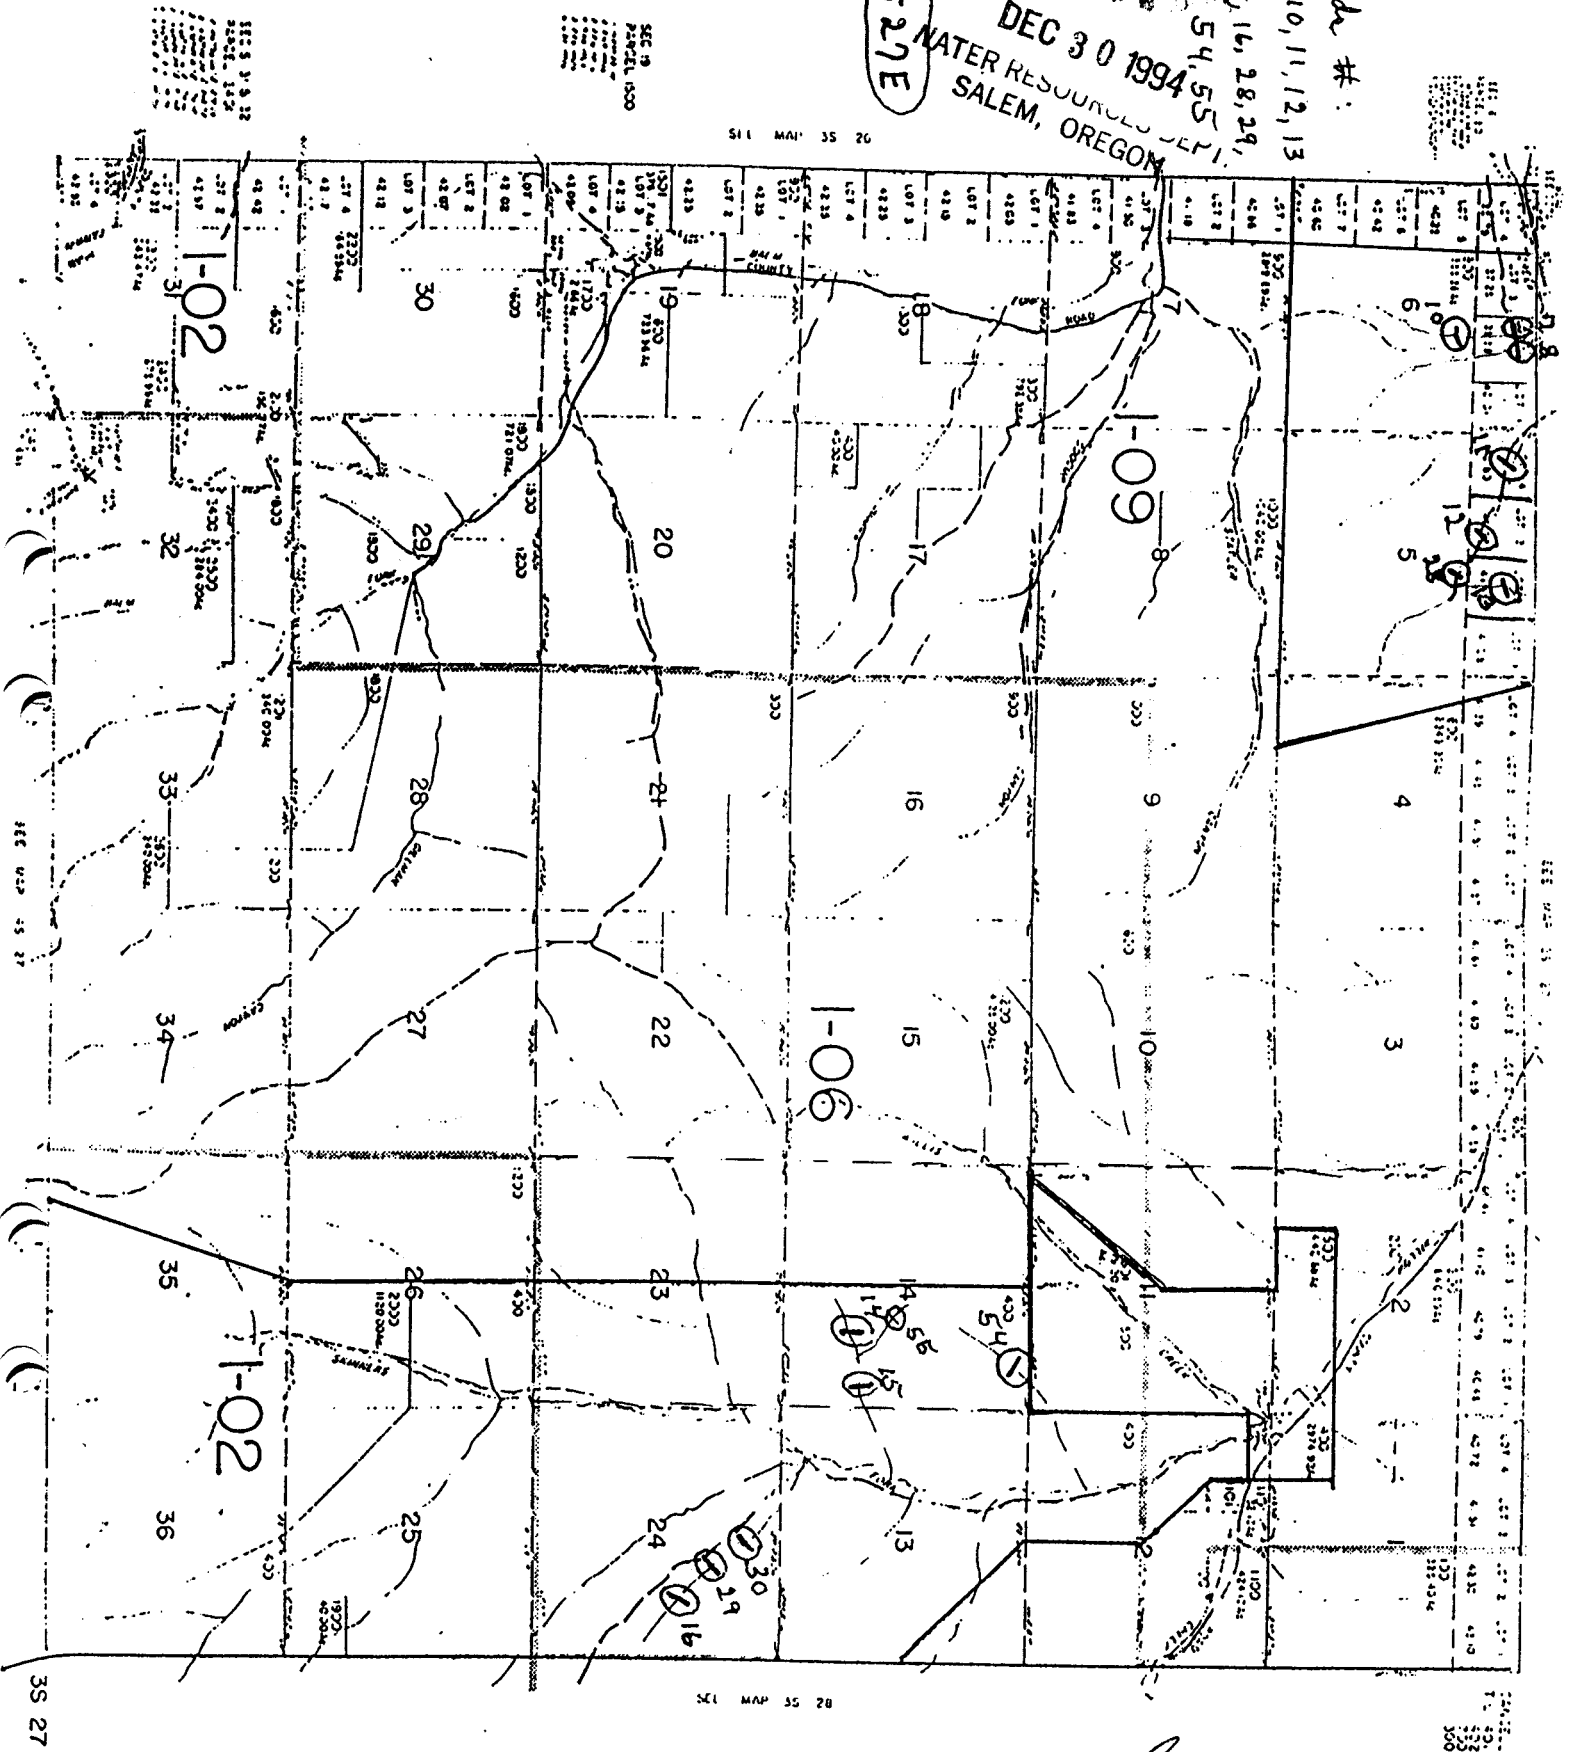

Application No. R-81578
 Permit No.