Bonds #:
7, 18, 19, 20, 21,
22, 23, 24, 31, 32,
33, 34, 35, 36,
7, 38, 39, 40, 41
2, 43, 44, 45, 46
7, 48, 49, 50, 51
2, 53

RECEIVED
DEC 30 1994
WATER RESOURCES DEPT
SALEM, OREGON

3528E
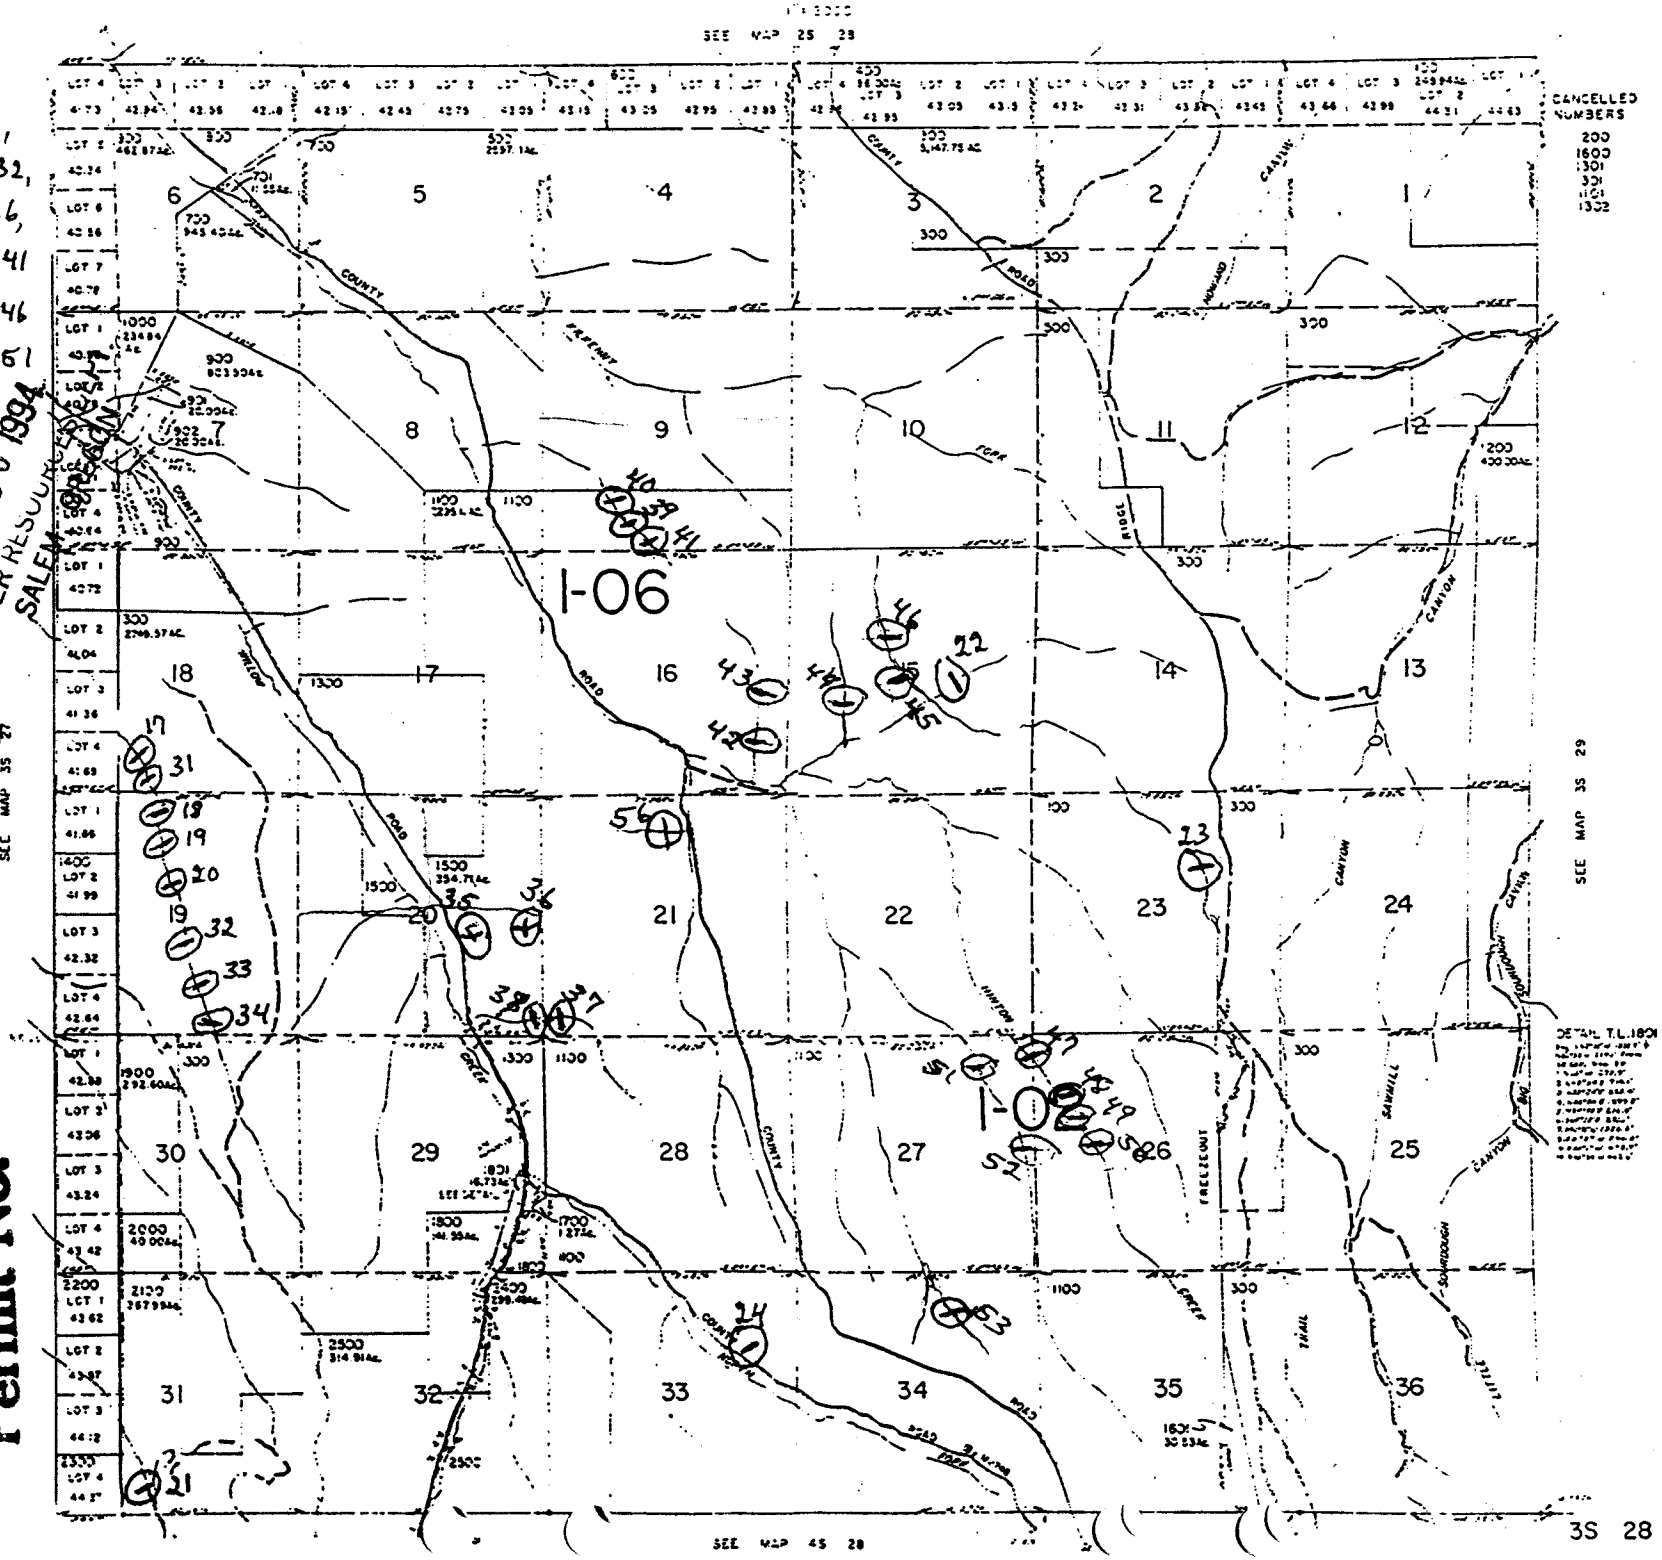
Application No. R-81580
Permit No.