

Application No. R-81606
Permit No.

RECEIVED

DEC 29 1994


T 15 S. R 39 E

WATER RESOURCES DEPT.
SALEM, OREGON

RECEIVED

SEP 19 1996

WATER RESOURCES DEPT.
SALEM, OREGON

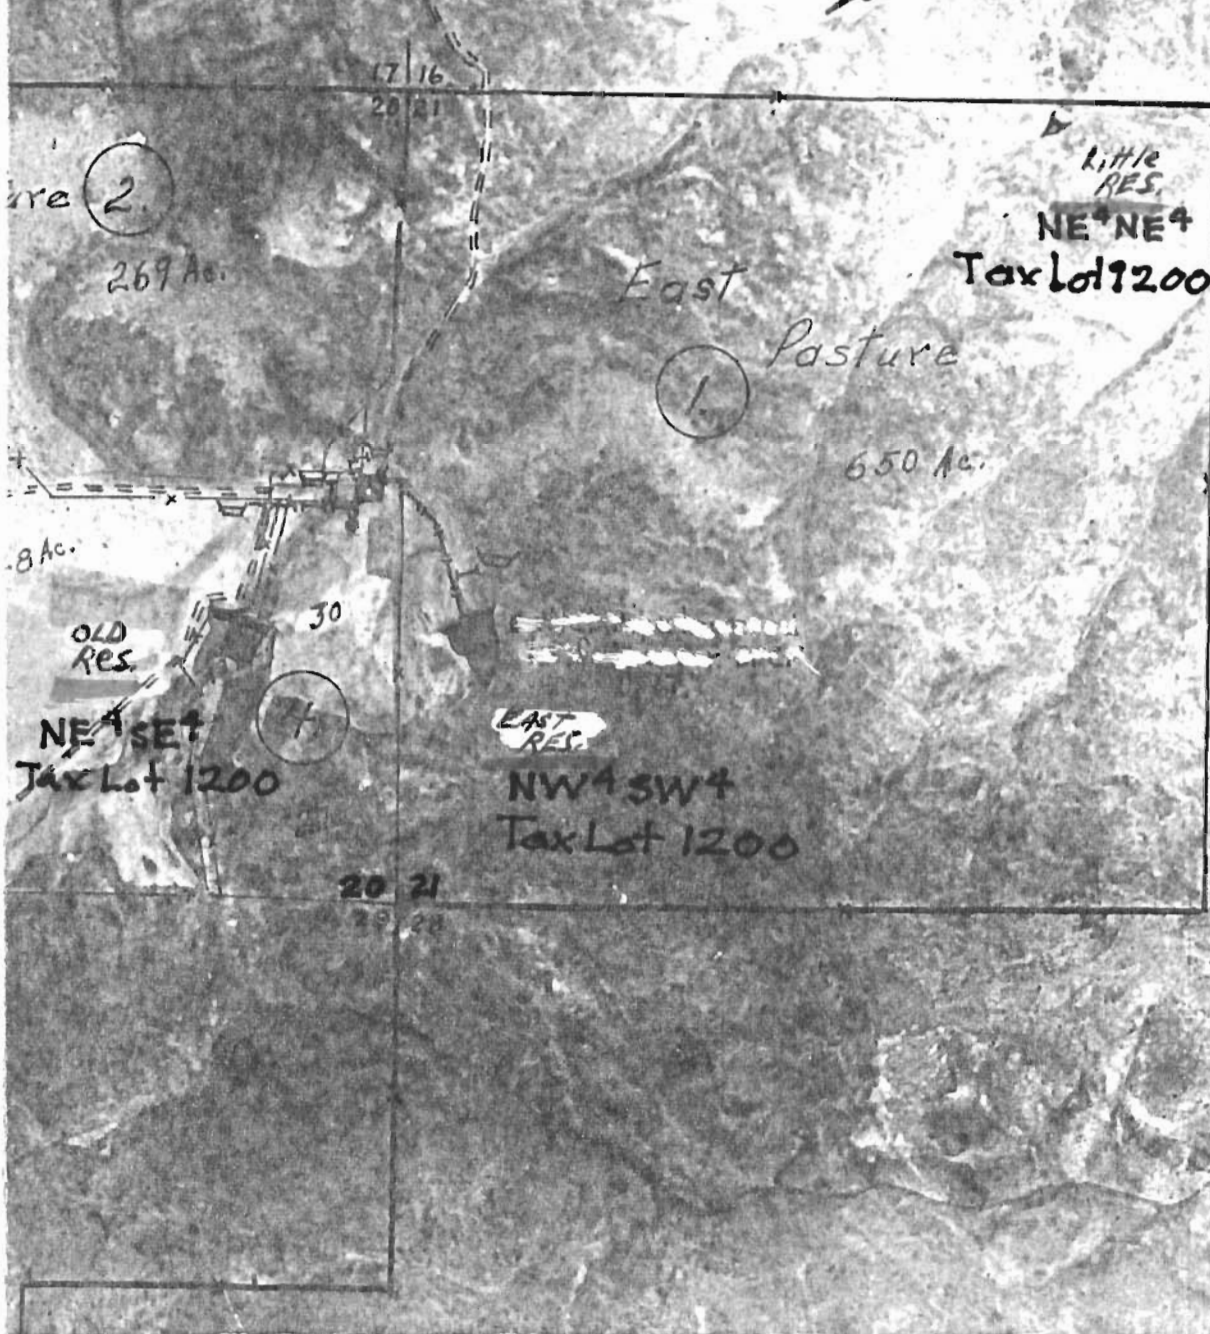

RECEIVED

JUL 26 1996

WATER RESOURCES DEPT.
SALEM, OREGON