


RECEIVED
SEPT 2 9 1990

RECEIVED


DEC 28 1994

WATER RESOURCES DEP.
SALEM, OREGON

SCALE 1:40000

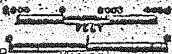

WASCO

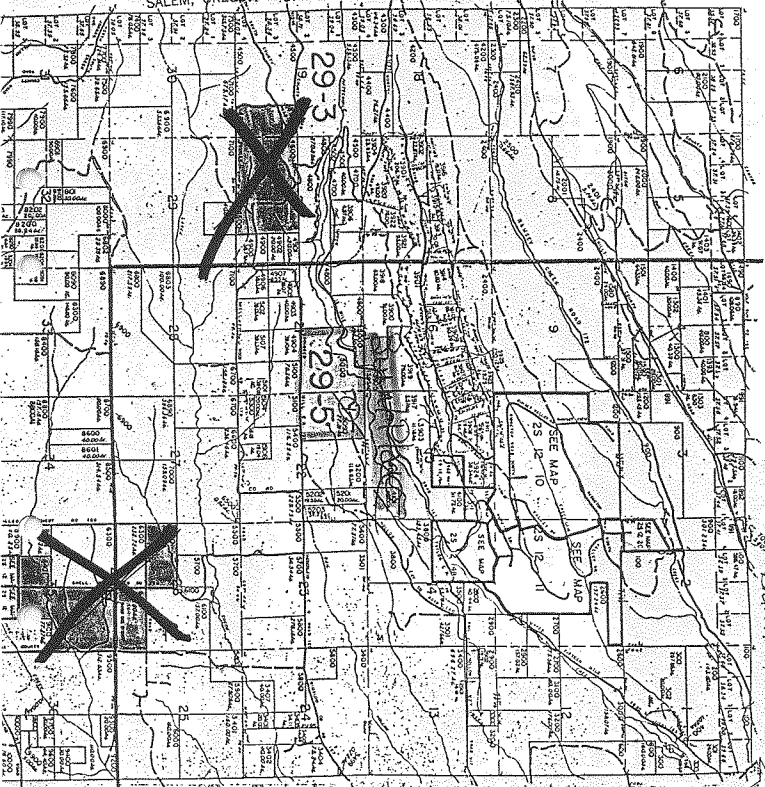

SEE MAP 15 12

Burnt Place

RECEIVED

RECEIVED

Application No. R-81637
Permit No.

SEP 1 8 1996

JUL 29 1996

WATER RESOURCES DEPT.
SALEM, OREGON

WATER RESOURCES DEPT.
SALEM, OREGON

25 12

