

No Final Proof Map available

No Permit Map available

DEC 3 1954
WATER RESOURCES DEPT.
SALEM, OREGON

T 24 S
2370 (NW
MC EWEN BUTTE)


T 25 S

2-81649

OCT 29 1996

RECEIVED

WATER RESOURCES DEPT.
SALEM, OREGON

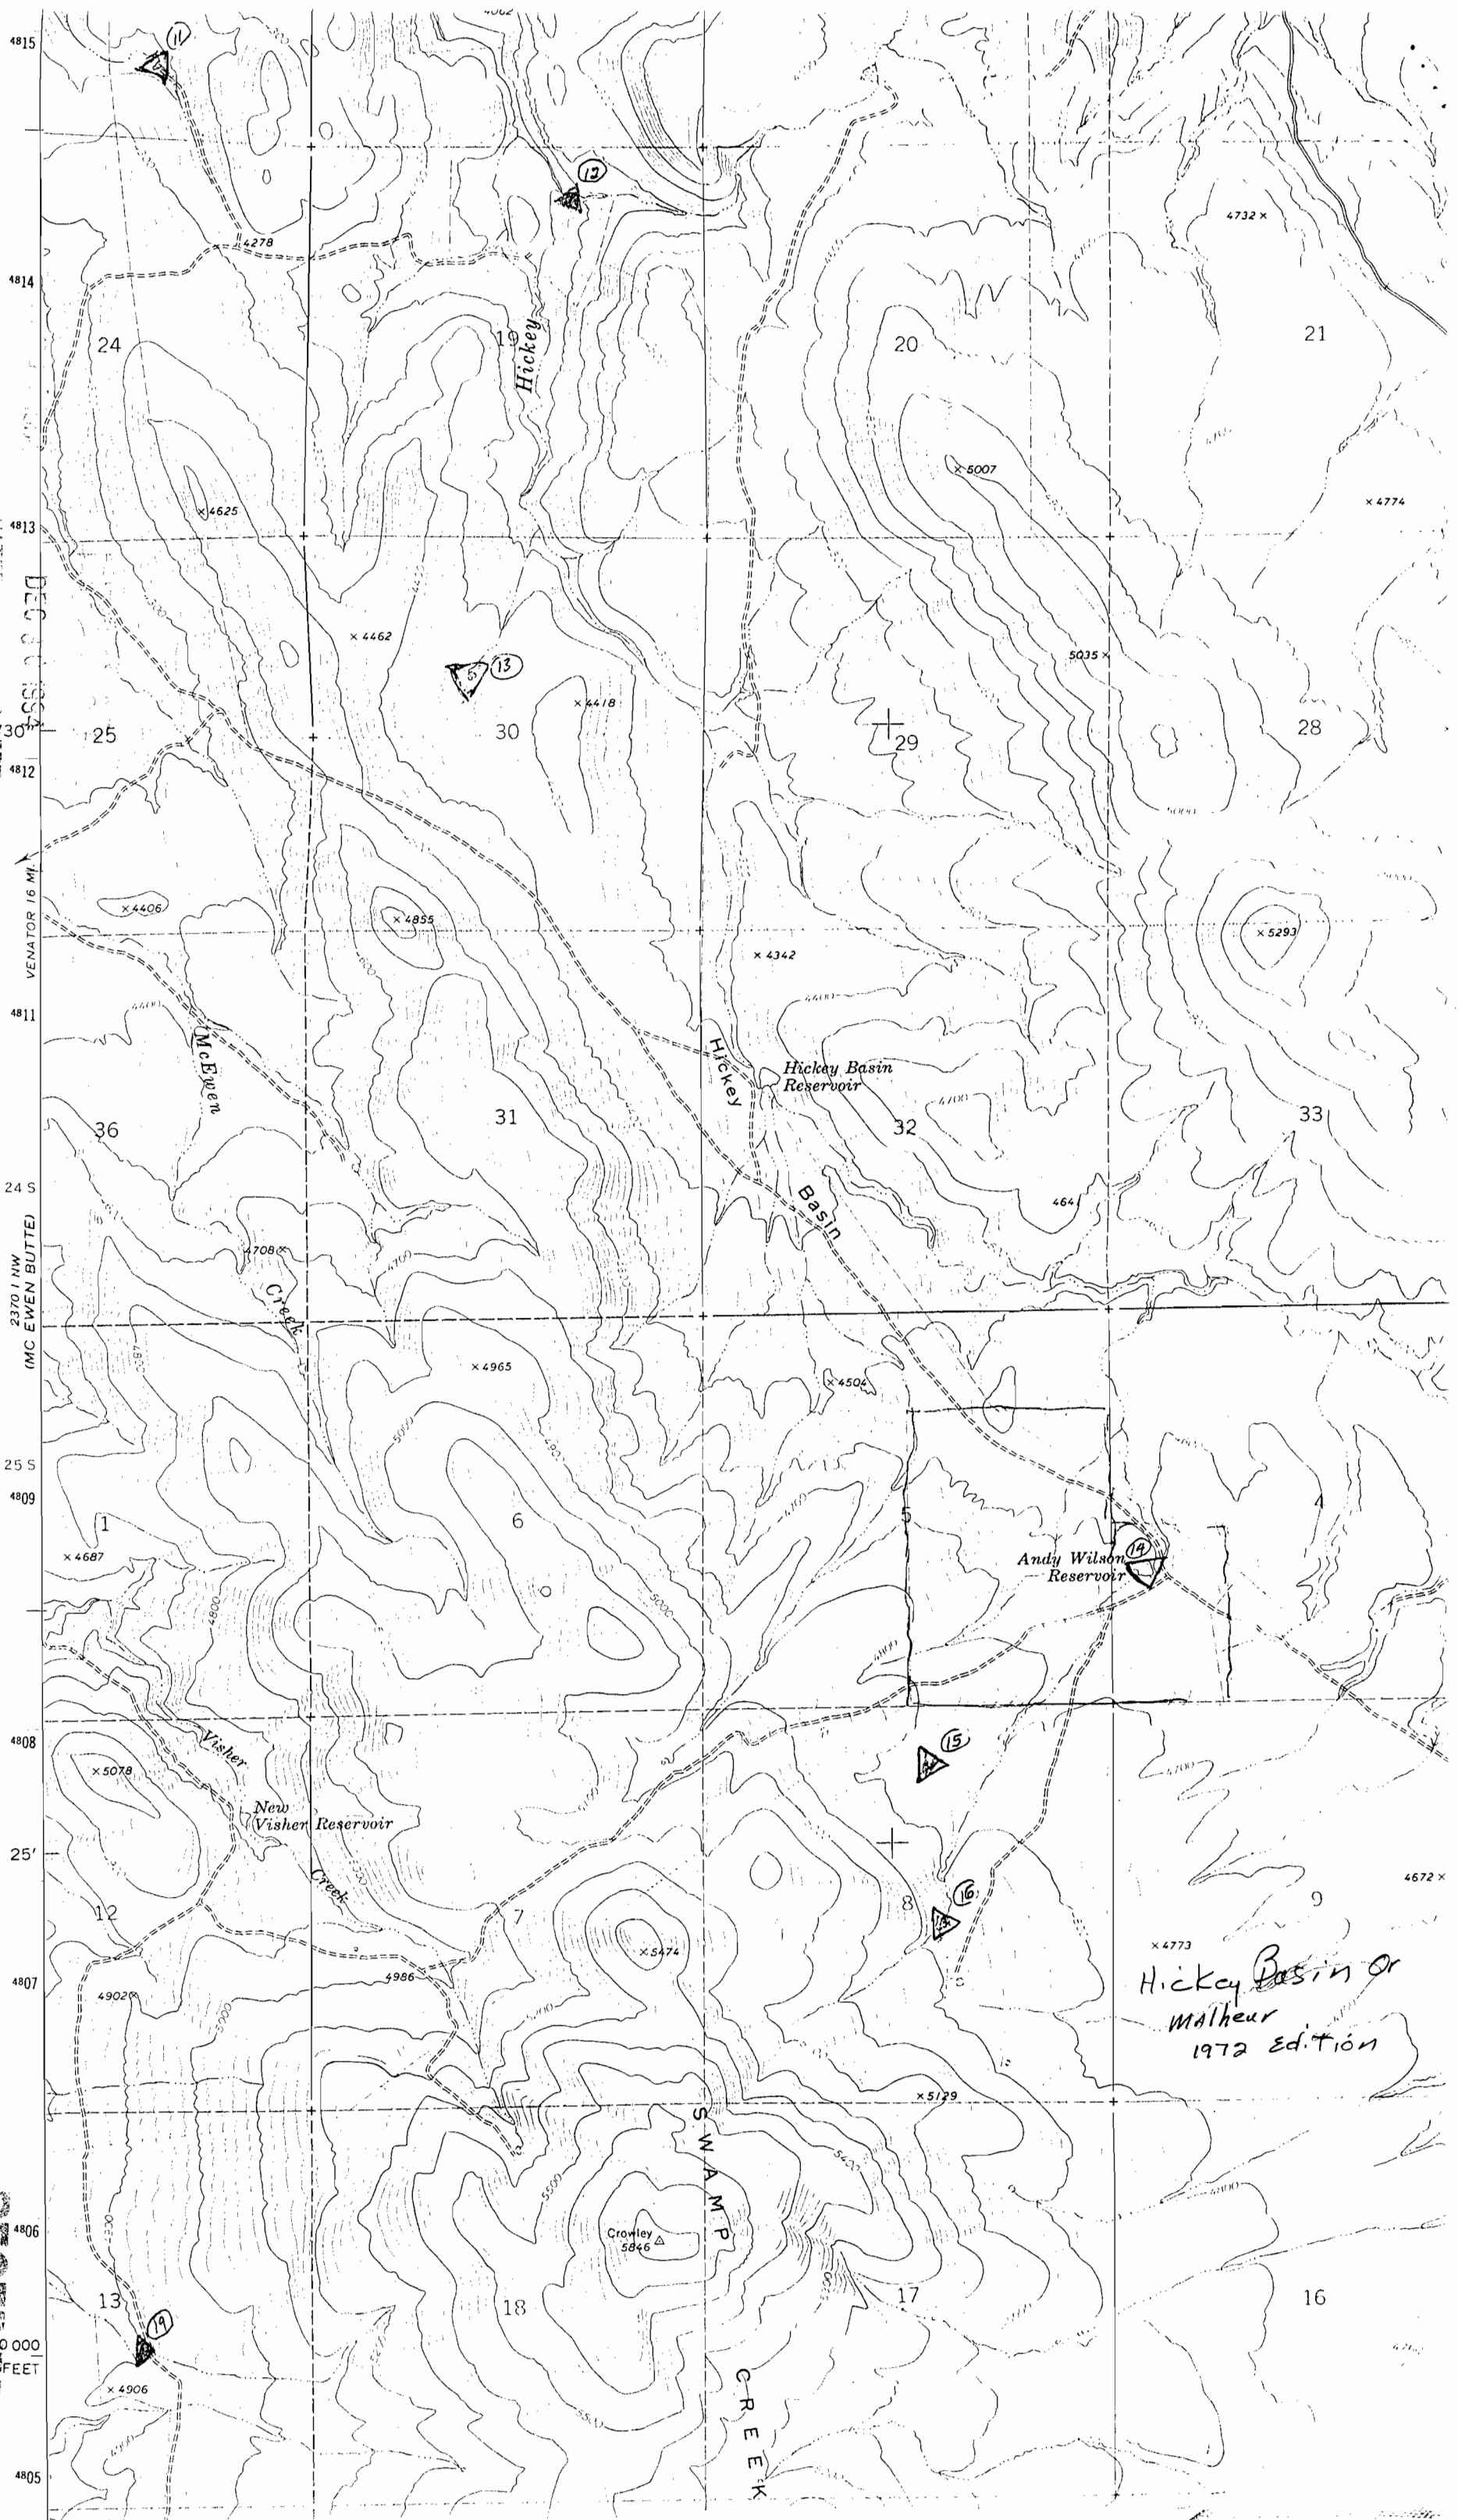

Hickey Basin or
Malheur
1972 edition