


T. 8S. R. 40E. W. M.

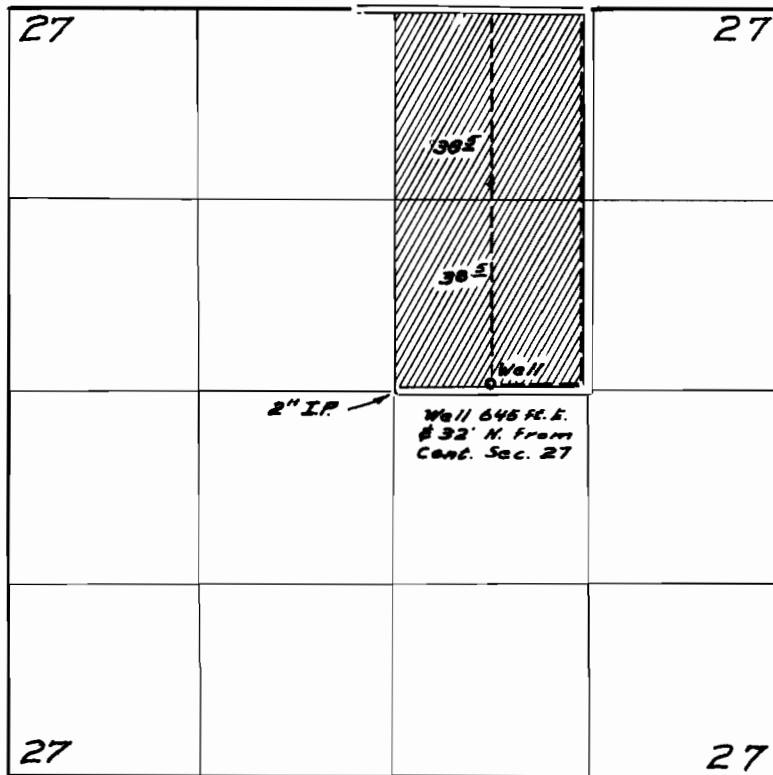

FINAL PROOF SURVEY UNDER

Application No. G-2261 Permit No. G-2077
IN NAME OF

William Schaan

Surveyed Aug. 2 1966, by W. J. Ruppert